
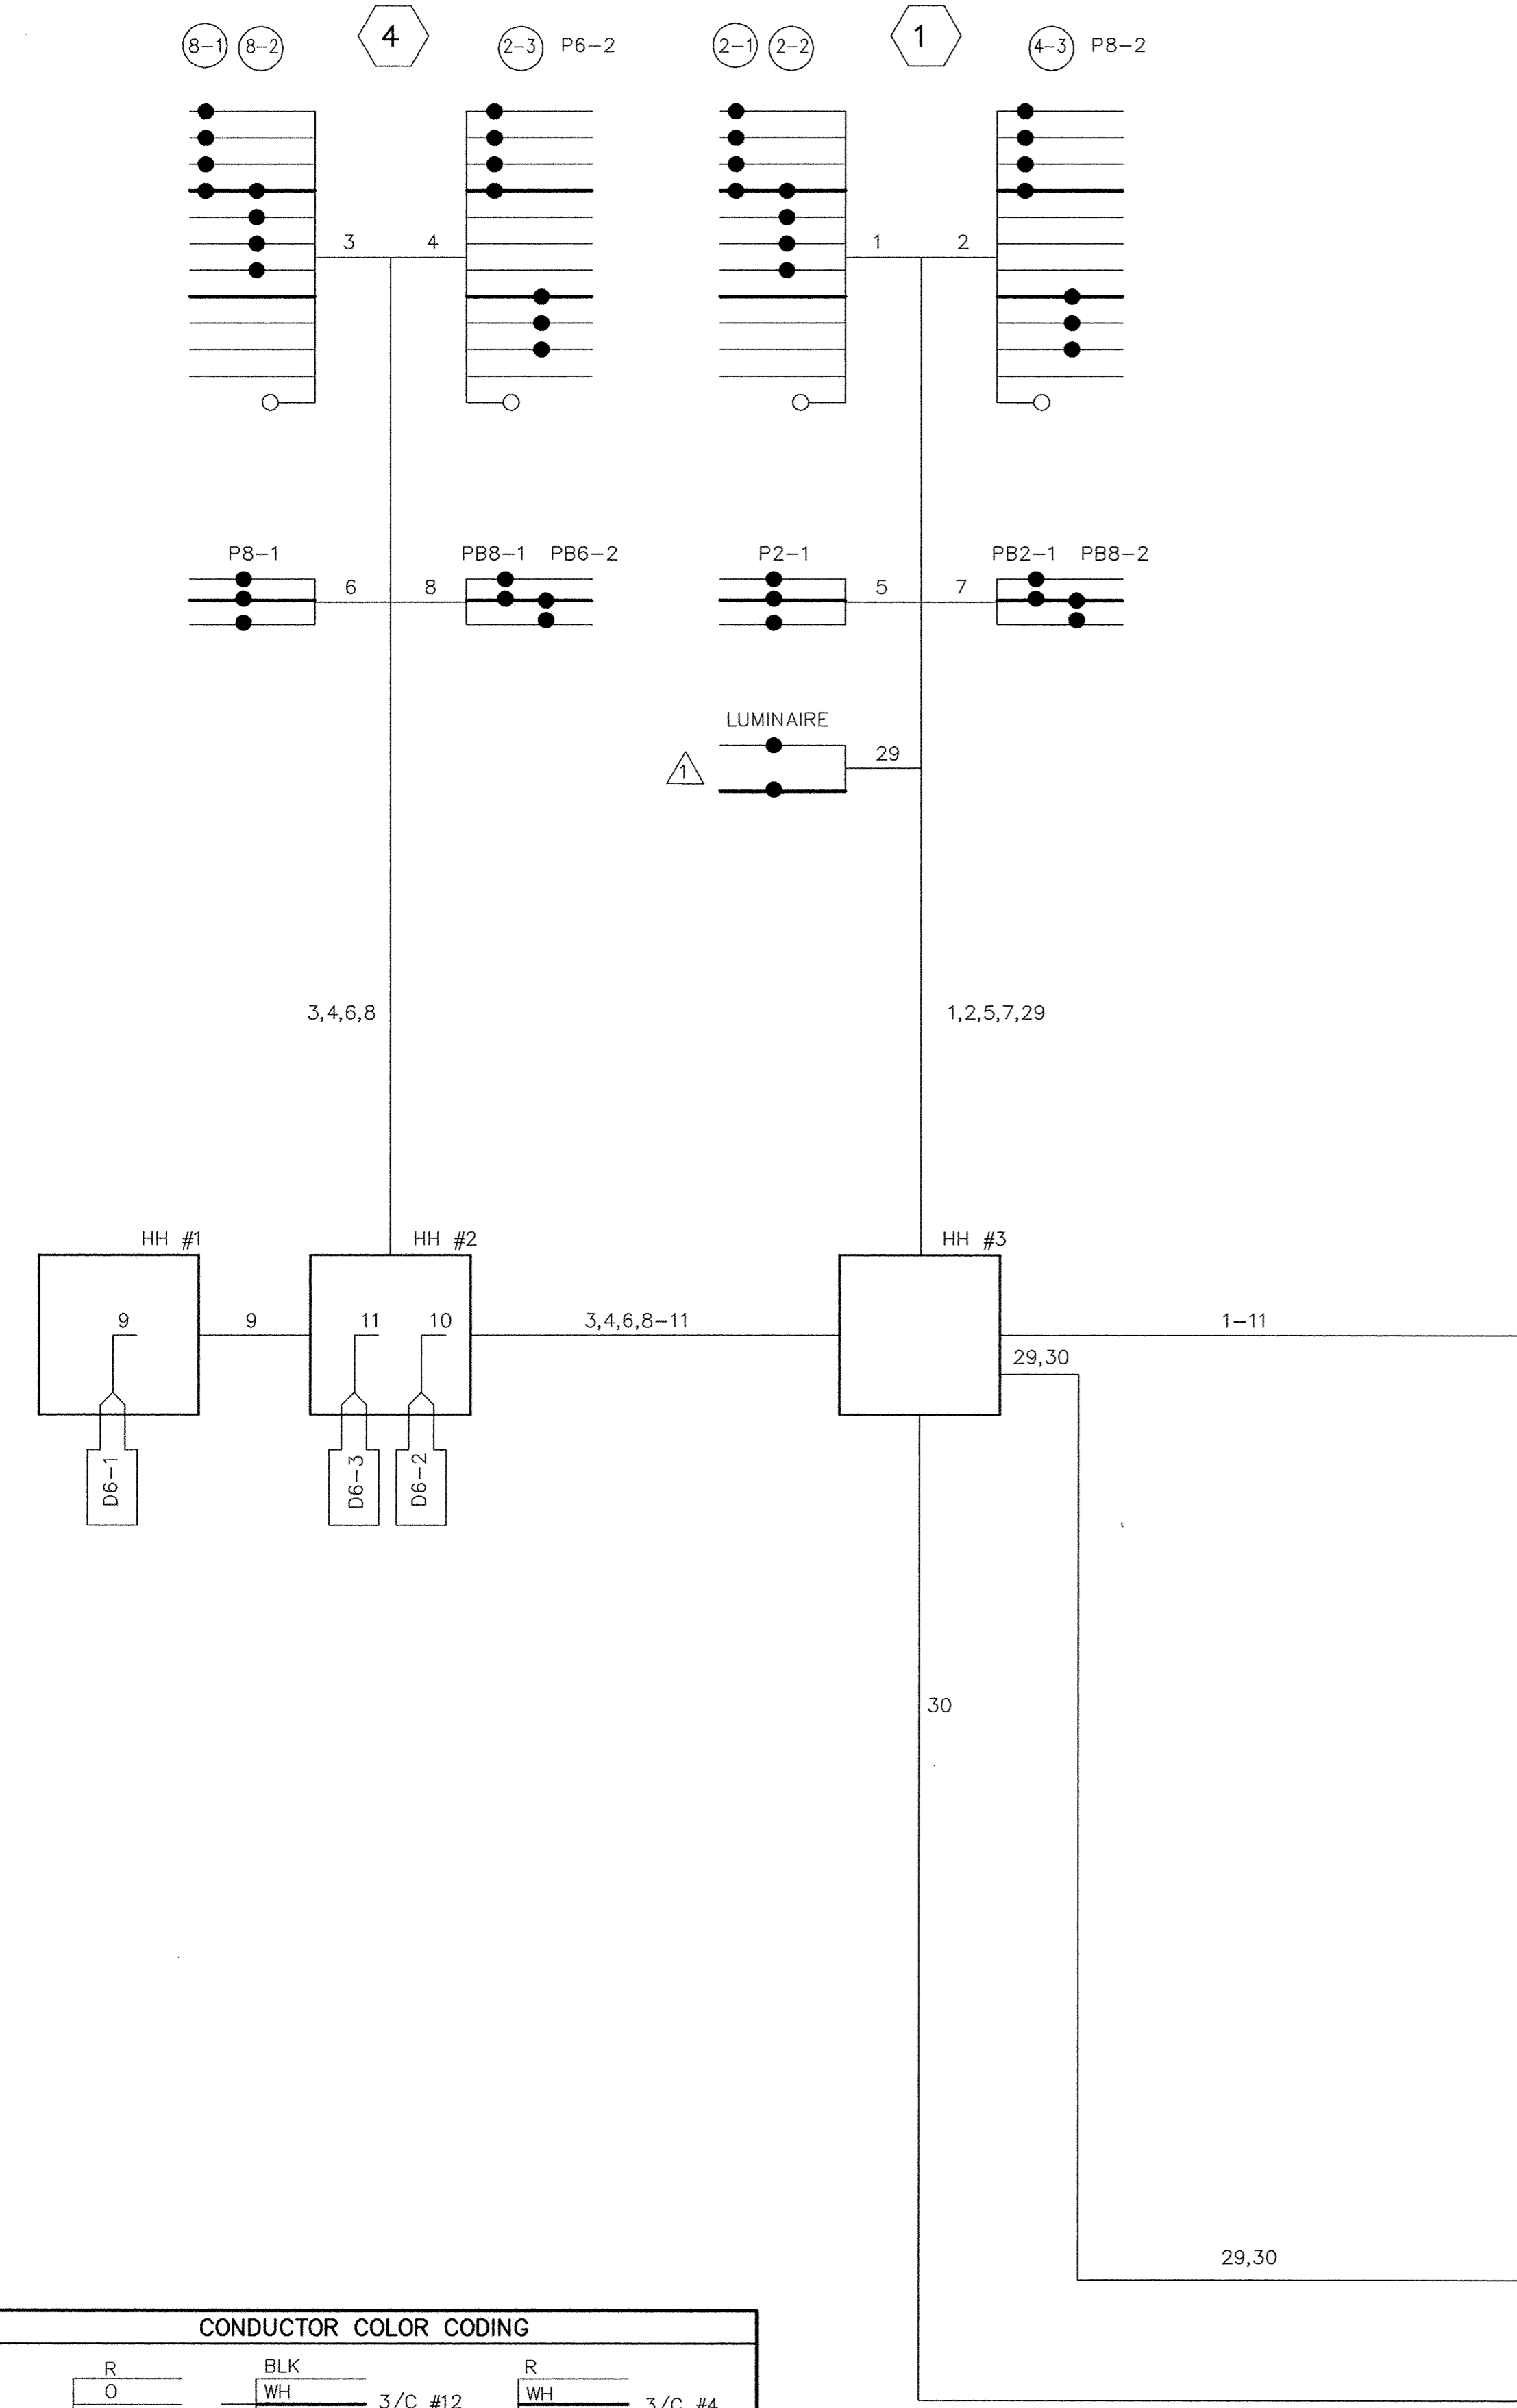


SAFCO PRODUCTS • NEW UPRR, MINNESOTA
REORDER BY PART NUMBER 6532

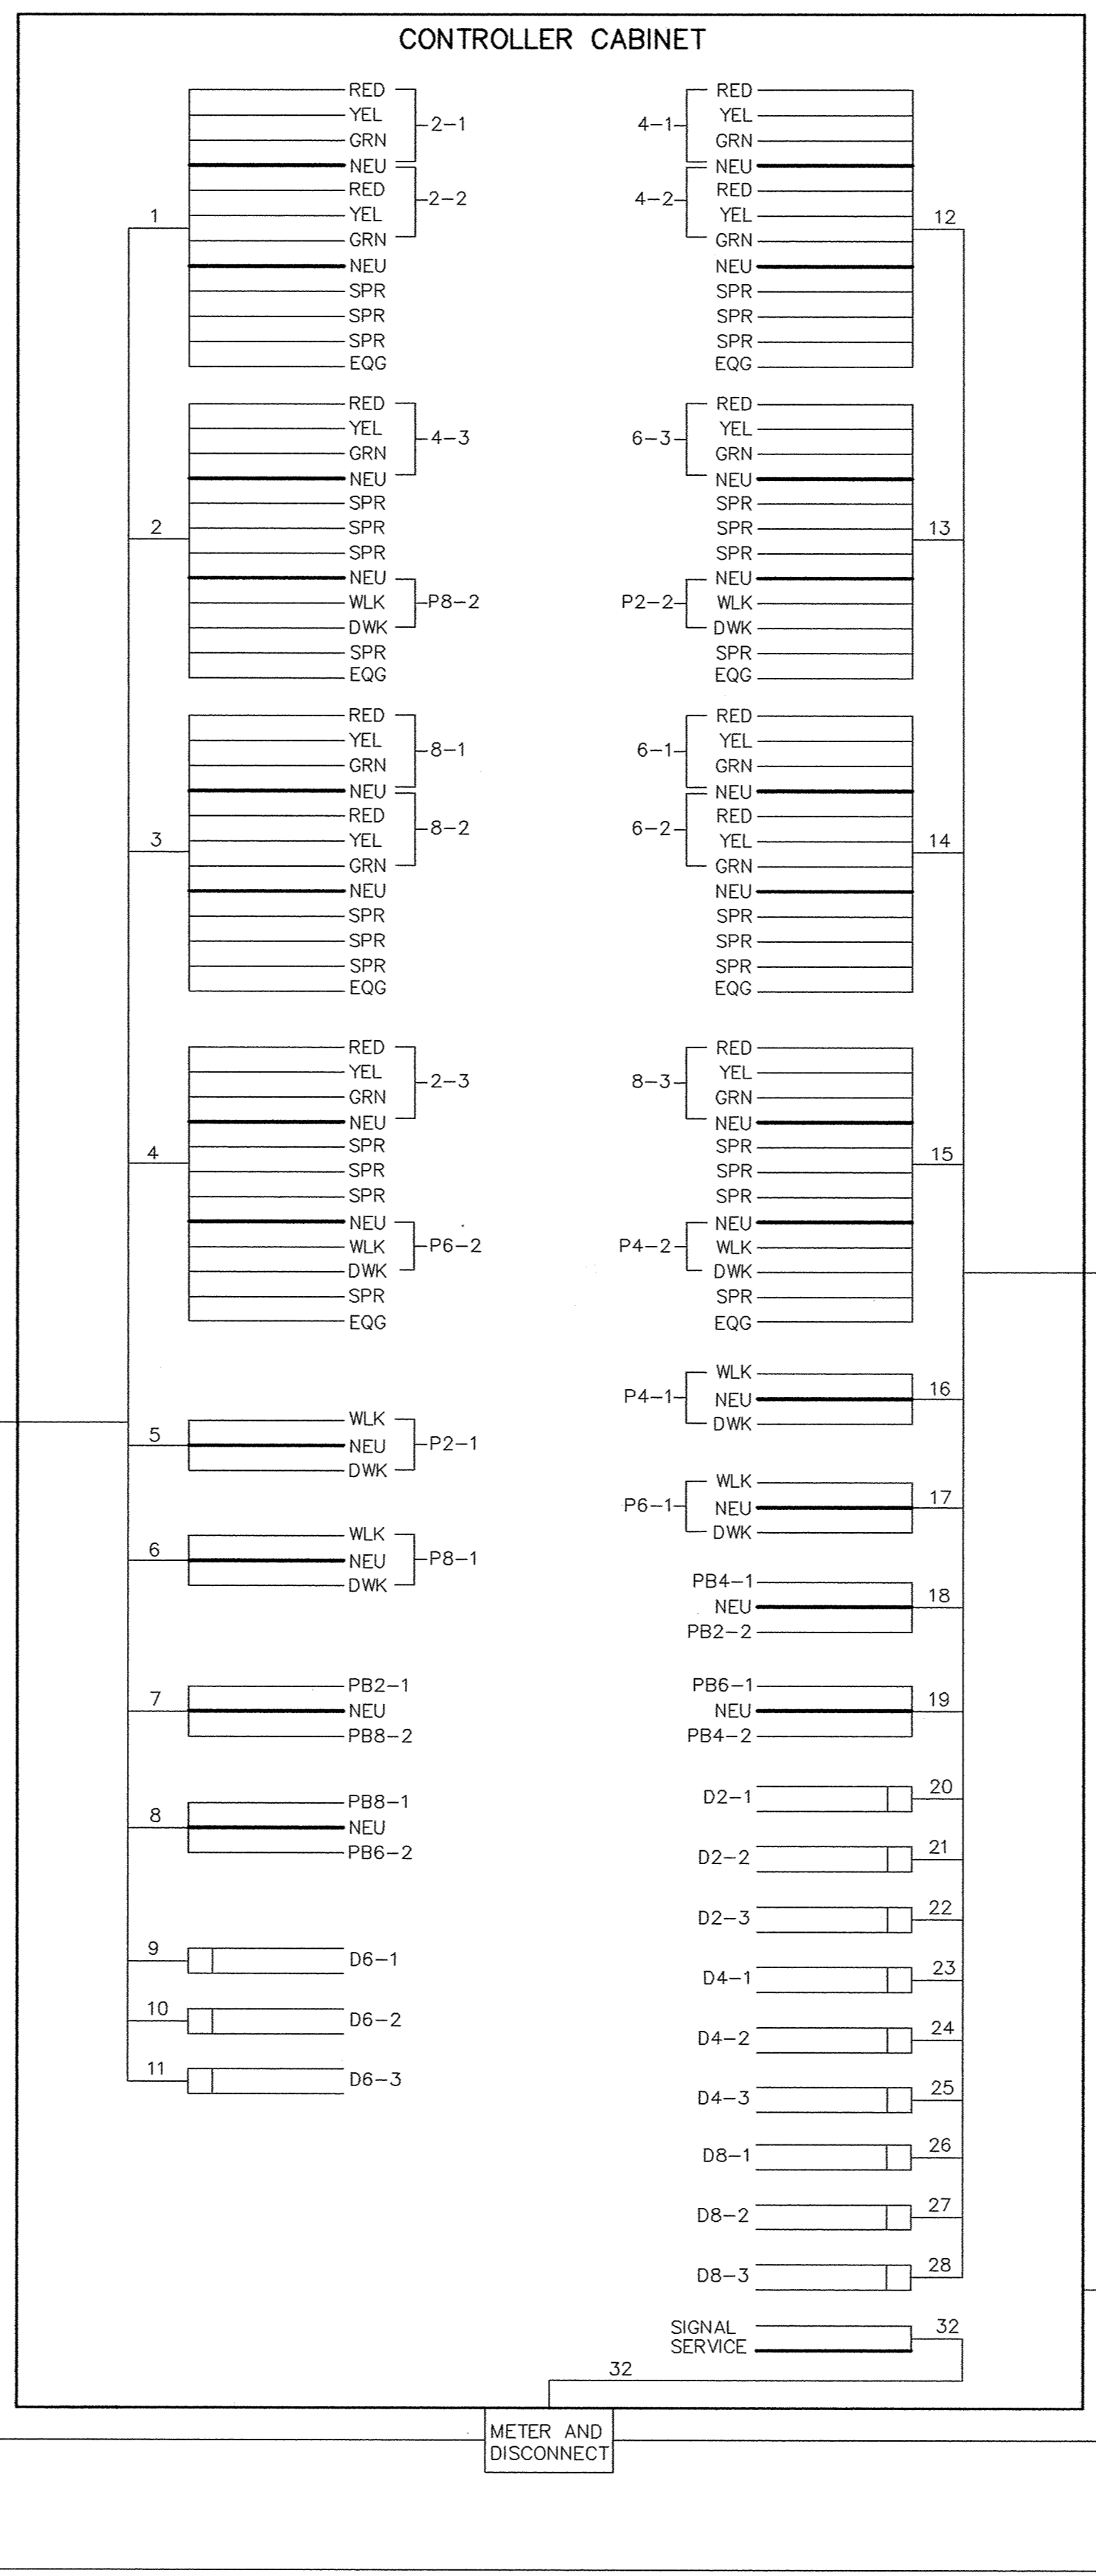

CONDUCTOR COLOR CODING

R	BLK	R
O	WH	3/C #12
BL	R	3/C #4
WH	CLR	ARMORED CABLE
R/BLK	BLK	SHIELD
O/BLK		
BL/BLK		
WH/BLK		
BLK	BLK	2/C #14
BLK/WH		
G/BLK		
G		
	BLK	2-1/C #6
	WH	
	R	2-1/C #10
	WH	

NOTE: ALL TERMINAL BLOCK CONNECTIONS SHALL BE ARRANGED AS SPECIFIED.

I HEREBY CERTIFY THAT THIS PLAN, SPECIFICATION, OR REPORT WAS PREPARED BY ME OR UNDER MY DIRECT SUPERVISION AND THAT I AM A DULY REGISTERED PROFESSIONAL ENGINEER UNDER THE LAWS OF THE STATE OF MINNESOTA.

Glenn Sorenson
DATE: 4/18/94 REG. NO. 18925



1326 ENERGY PARK DRIVE
ST. PAUL, MINNESOTA 55108
(612) 644-4389

9800 SHELARD PARKWAY
MINNEAPOLIS, MINNESOTA 55441
(612) 546-0432

REVISIONS	DATE	DESCRIPTION	DESIGNED GMS	CHECKED GMS	DRAWN EGY

RECORD PLAN 1995		
CITY OF ELK RIVER FIELD WIRING DIAGRAM SYSTEM "A"		
SCHOOL STREET @ JACKSON AVENUE S.A.P. 204-104-04 MTB, 204-107-04		
DATE: APRIL 1994	SHEET 60 OF 74 SHEETS	PROJECT NO. 230-216