



SAICO PRODUCTS - NEW HAVEN, MINNESOTA
RECEIVED BY PART NUMBER 0505
SAICO PRODUCTS - NEW HAVEN, MINNESOTA
RECEIVED BY PART NUMBER 0505
SAICO PRODUCTS - NEW HAVEN, MINNESOTA
RECEIVED BY PART NUMBER 0505

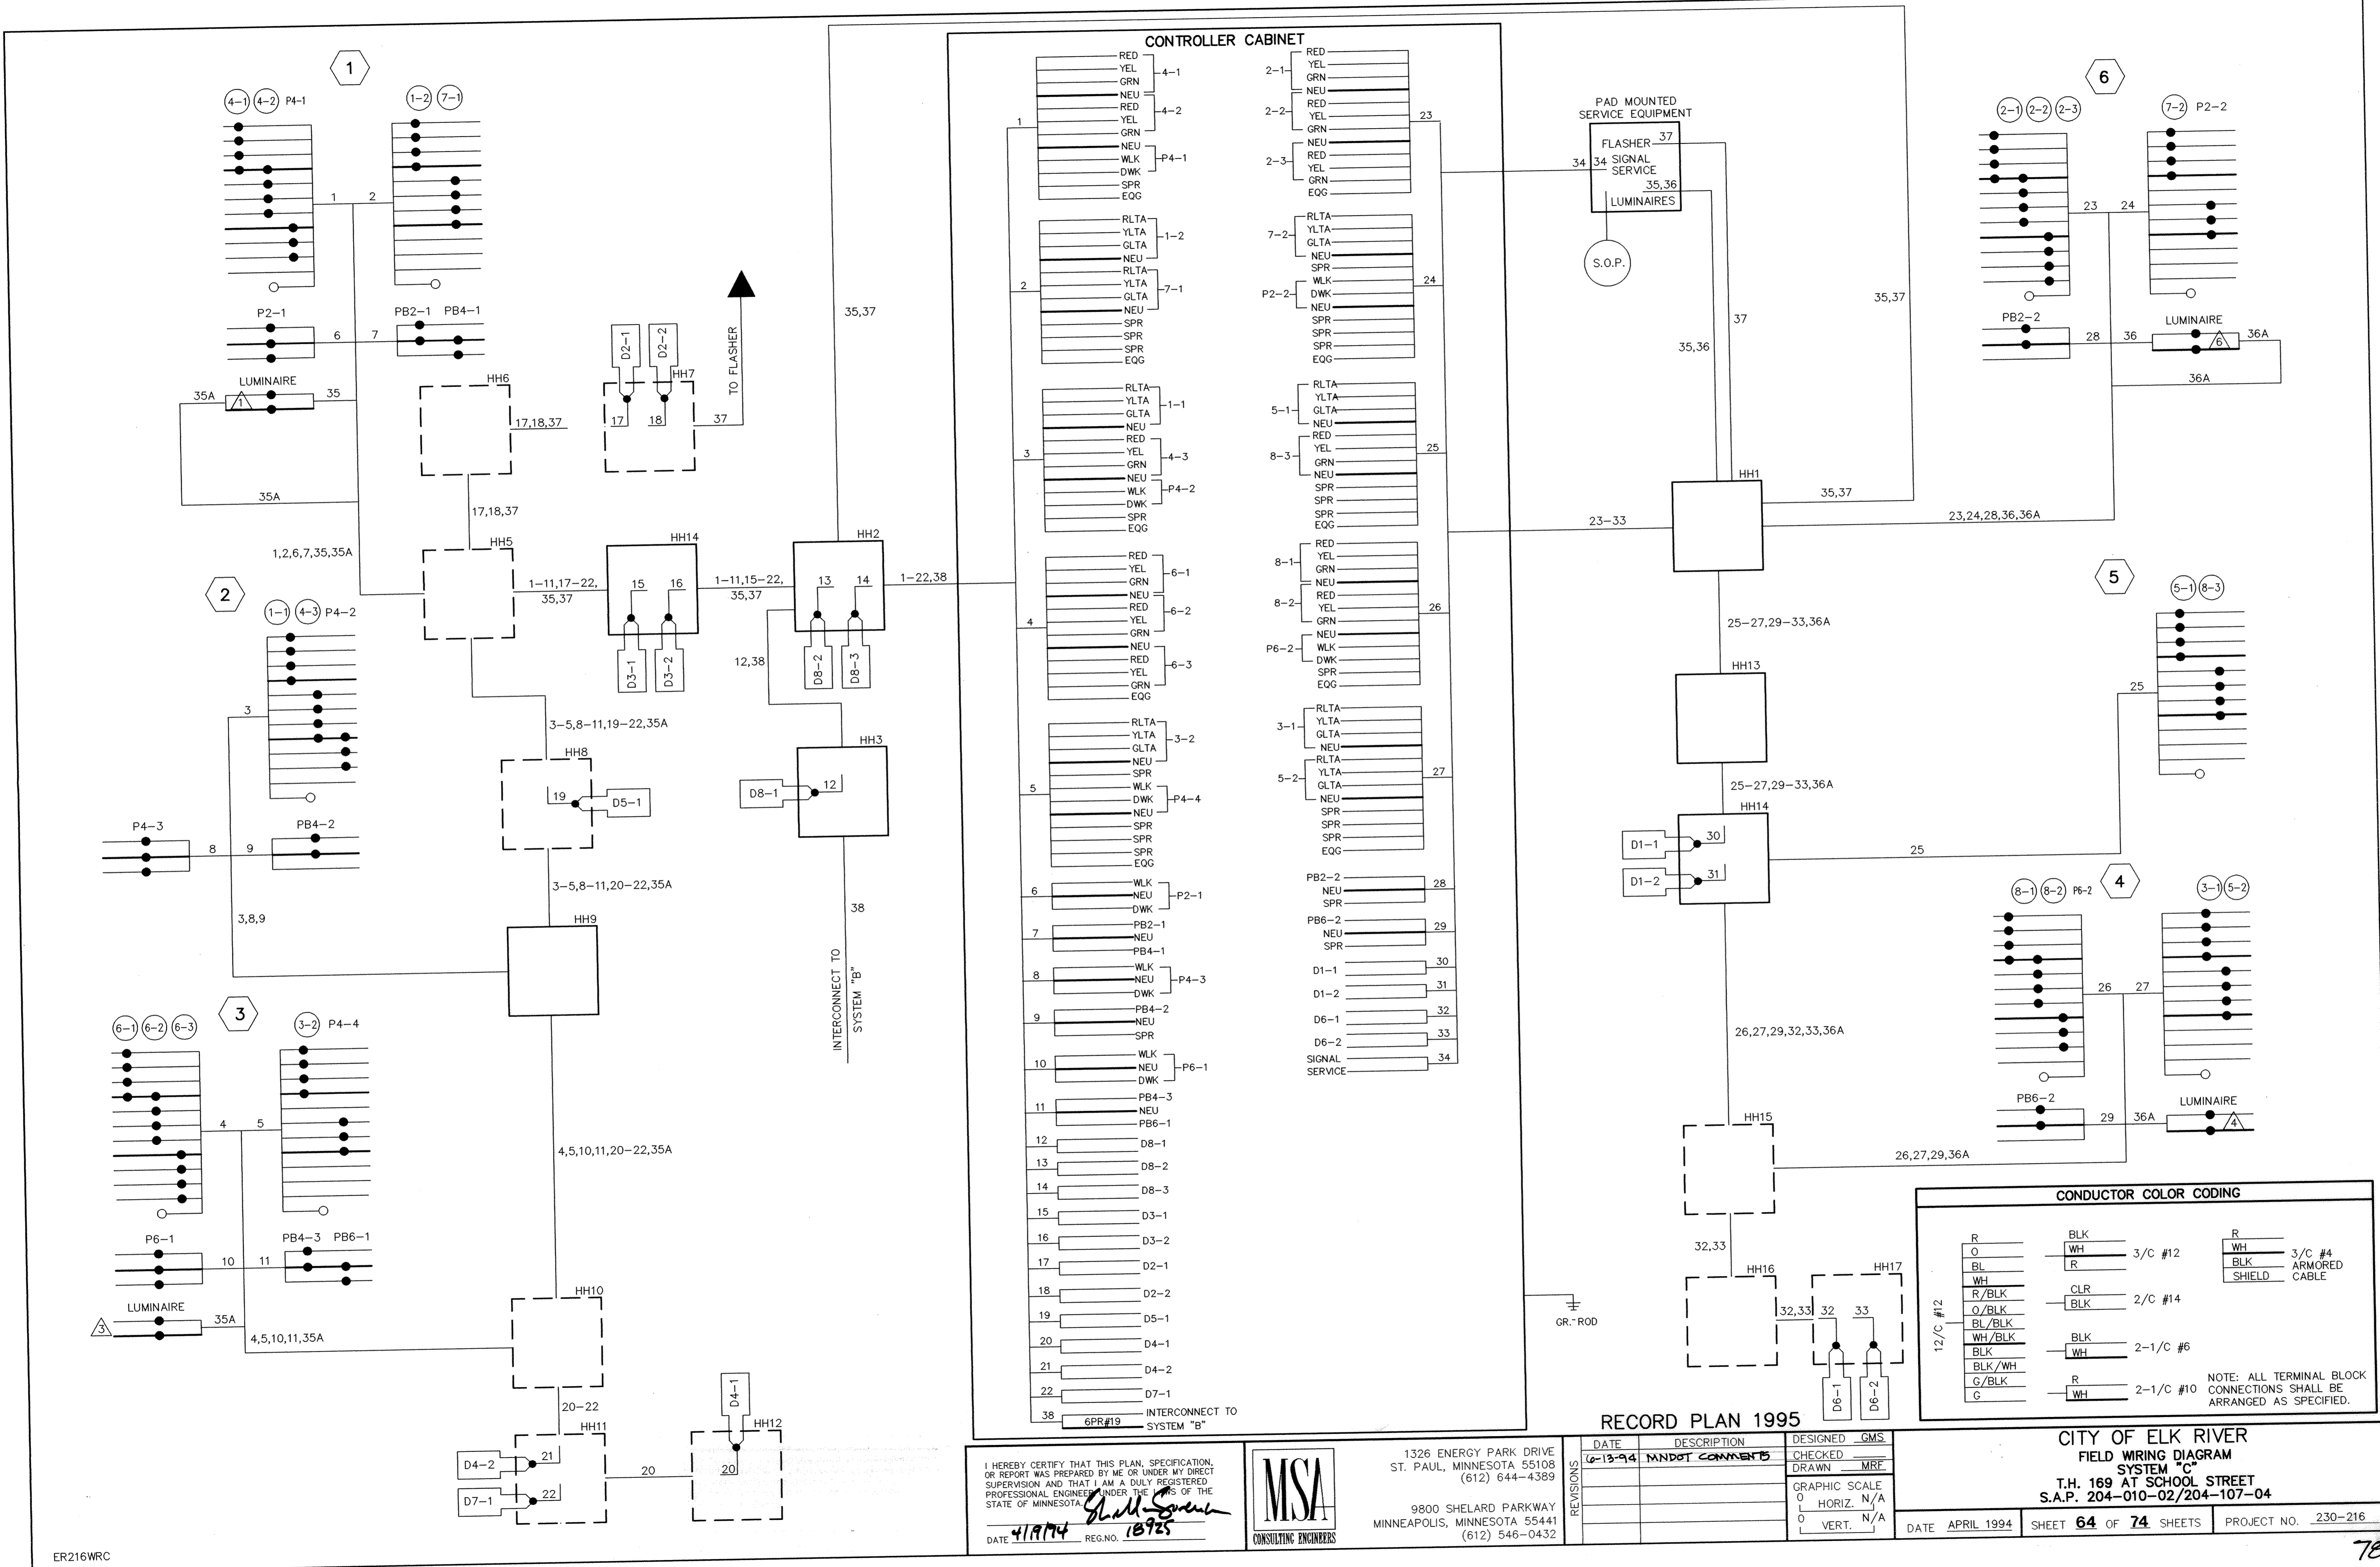

CONTROLLER CABINET

- 1 RED 4-1
- 1 YEL 4-1
- 1 GRN 4-1
- 1 NEU 4-2
- 1 RED 4-2
- 1 YEL 4-2
- 1 GRN 4-2
- 1 NEU P4-1
- 1 WLK P4-1
- 1 DWK P4-1
- 1 SPR P4-1
- 1 EGG P4-1
- 2 RLTA 1-2
- 2 YLTA 1-2
- 2 GLTA 1-2
- 2 NEU 7-1
- 2 RLTA 7-1
- 2 YLTA 7-1
- 2 GLTA 7-1
- 2 NEU P2-2
- 2 WLK P2-2
- 2 DWK P2-2
- 2 SPR P2-2
- 2 EGG P2-2
- 3 RLTA 1-1
- 3 YLTA 1-1
- 3 GLTA 1-1
- 3 NEU 4-3
- 3 RED 4-3
- 3 YEL 4-3
- 3 GRN 4-3
- 3 NEU P4-2
- 3 WLK P4-2
- 3 DWK P4-2
- 3 SPR P4-2
- 3 EGG P4-2
- 4 RED 6-1
- 4 YEL 6-1
- 4 GRN 6-1
- 4 NEU 6-2
- 4 RED 6-2
- 4 YEL 6-2
- 4 GRN 6-2
- 4 NEU 6-3
- 4 RED 6-3
- 4 YEL 6-3
- 4 GRN 6-3
- 5 RLTA 3-2
- 5 YLTA 3-2
- 5 GLTA 3-2
- 5 NEU P4-4
- 5 WLK P4-4
- 5 DWK P4-4
- 5 SPR P4-4
- 5 EGG P4-4
- 6 WLK P2-1
- 6 NEU P2-1
- 6 DWK P2-1
- 7 PB2-1
- 7 NEU PB4-1
- 7 PB4-1
- 8 WLK P4-3
- 8 NEU P4-3
- 8 DWK P4-3
- 9 PB4-2
- 9 NEU PB6-1
- 9 PB6-1
- 10 WLK P6-1
- 10 NEU P6-1
- 10 DWK P6-1
- 11 PB4-3
- 11 NEU PB6-1
- 11 PB6-1
- 12 D8-1
- 13 D8-2
- 14 D8-3
- 15 D3-1
- 16 D3-2
- 17 D2-1
- 18 D2-2
- 19 D5-1
- 20 D4-1
- 21 D4-2
- 22 D7-1
- 38 INTERCONNECT TO SYSTEM "B"

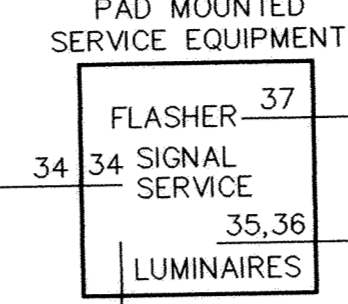

CONDUCTOR COLOR CODING

R	BLK	R
O	WH	WH
BL	R	BLK
WH	CLR	SHIELD
R/BLK	BLK	
O/BLK	WH	
BL/BLK	BLK	
WH/BLK	WH	
BLK	BLK	
G/BLK	R	
G	WH	

NOTE: ALL TERMINAL BLOCK CONNECTIONS SHALL BE ARRANGED AS SPECIFIED.

RECORD PLAN 1995


REVISIONS	DATE	DESCRIPTION	DESIGNED	GMS
	6-13-94	MANDOT COMMENTS	CHECKED	
			DRAWN	MRF
			GRAPHIC SCALE	
			0 HORIZ.	N/A
			0 VERT.	N/A

CITY OF ELK RIVER
FIELD WIRING DIAGRAM
SYSTEM "C"
T.H. 169 AT SCHOOL STREET
S.A.P. 204-010-02/204-107-04

DATE APRIL 1994 SHEET 64 OF 74 SHEETS PROJECT NO. 230-216

I HEREBY CERTIFY THAT THIS PLAN, SPECIFICATION, OR REPORT WAS PREPARED BY ME OR UNDER MY DIRECT SUPERVISION AND THAT I AM A DULY REGISTERED PROFESSIONAL ENGINEER UNDER THE LAWS OF THE STATE OF MINNESOTA.

G. H. Smith
 DATE 4/14/94 REG. NO. 18725

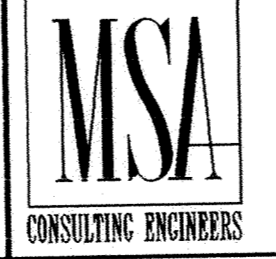

1326 ENERGY PARK DRIVE
 ST. PAUL, MINNESOTA 55108
 (612) 644-4389

9800 SHELARD PARKWAY
 MINNEAPOLIS, MINNESOTA 55441
 (612) 546-0432