

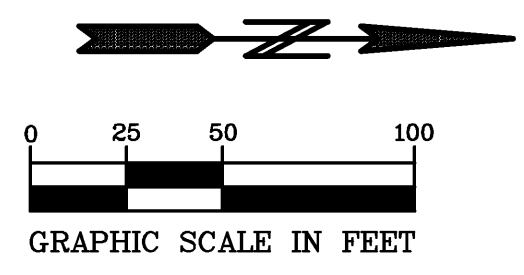


RECORD PLAN 2009
 CONTRACTOR
 RYAN CONTRACTING CO.
 PO BOX 246
 ELKO, MINNESOTA 55020
 (952) 894-3200

- GENERAL NOTES:
- 1.) SANITARY SEWER SERVICES SHALL BE 4" PVC SDR-35. RISERS TO BE 4" SDR-26
 - 2.) SANITARY SEWER SERVICE WYES ARE STATIONED FROM DOWN STREAM MANHOLE.
 - 3.) WATER SERVICES SHALL BE 1" COPPER TYPE "K" W/ 7.5' MINIMUM COVER.
 - 4.) SANITARY SEWER INVERTS ARE SHOWN AT THE SERVICE STUB NEAR CURB STOP.
 - 5.) SANITARY SEWER AND WATER SERVICES SHALL BE CONSTRUCTED 15' BEYOND RIGHT-OF-WAY.
 - 6.) CONCRETE UNDER ALL WYES W/RISERS.

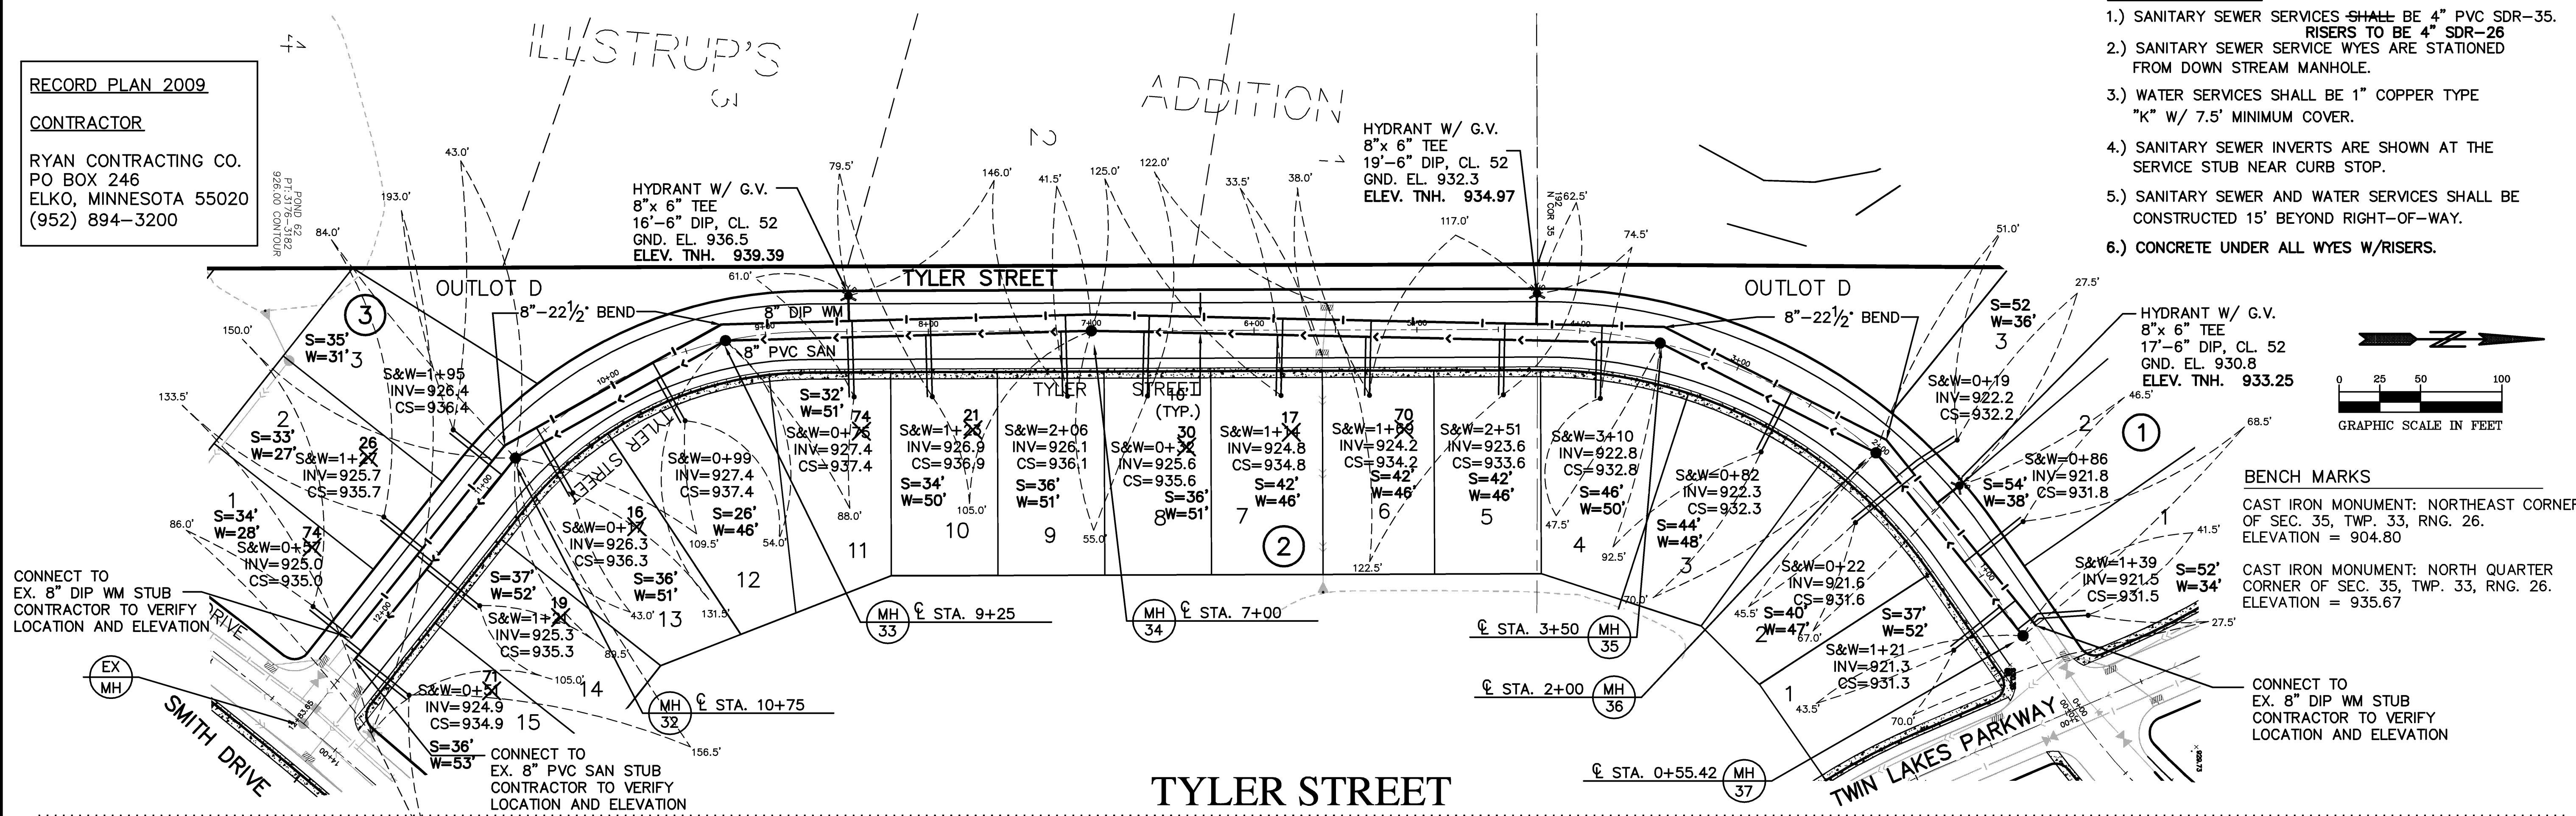

BENCH MARKS
 CAST IRON MONUMENT: NORTHEAST CORNER OF SEC. 35, TWP. 33, RNG. 26. ELEVATION = 904.80
 CAST IRON MONUMENT: NORTH QUARTER CORNER OF SEC. 35, TWP. 33, RNG. 26. ELEVATION = 935.67

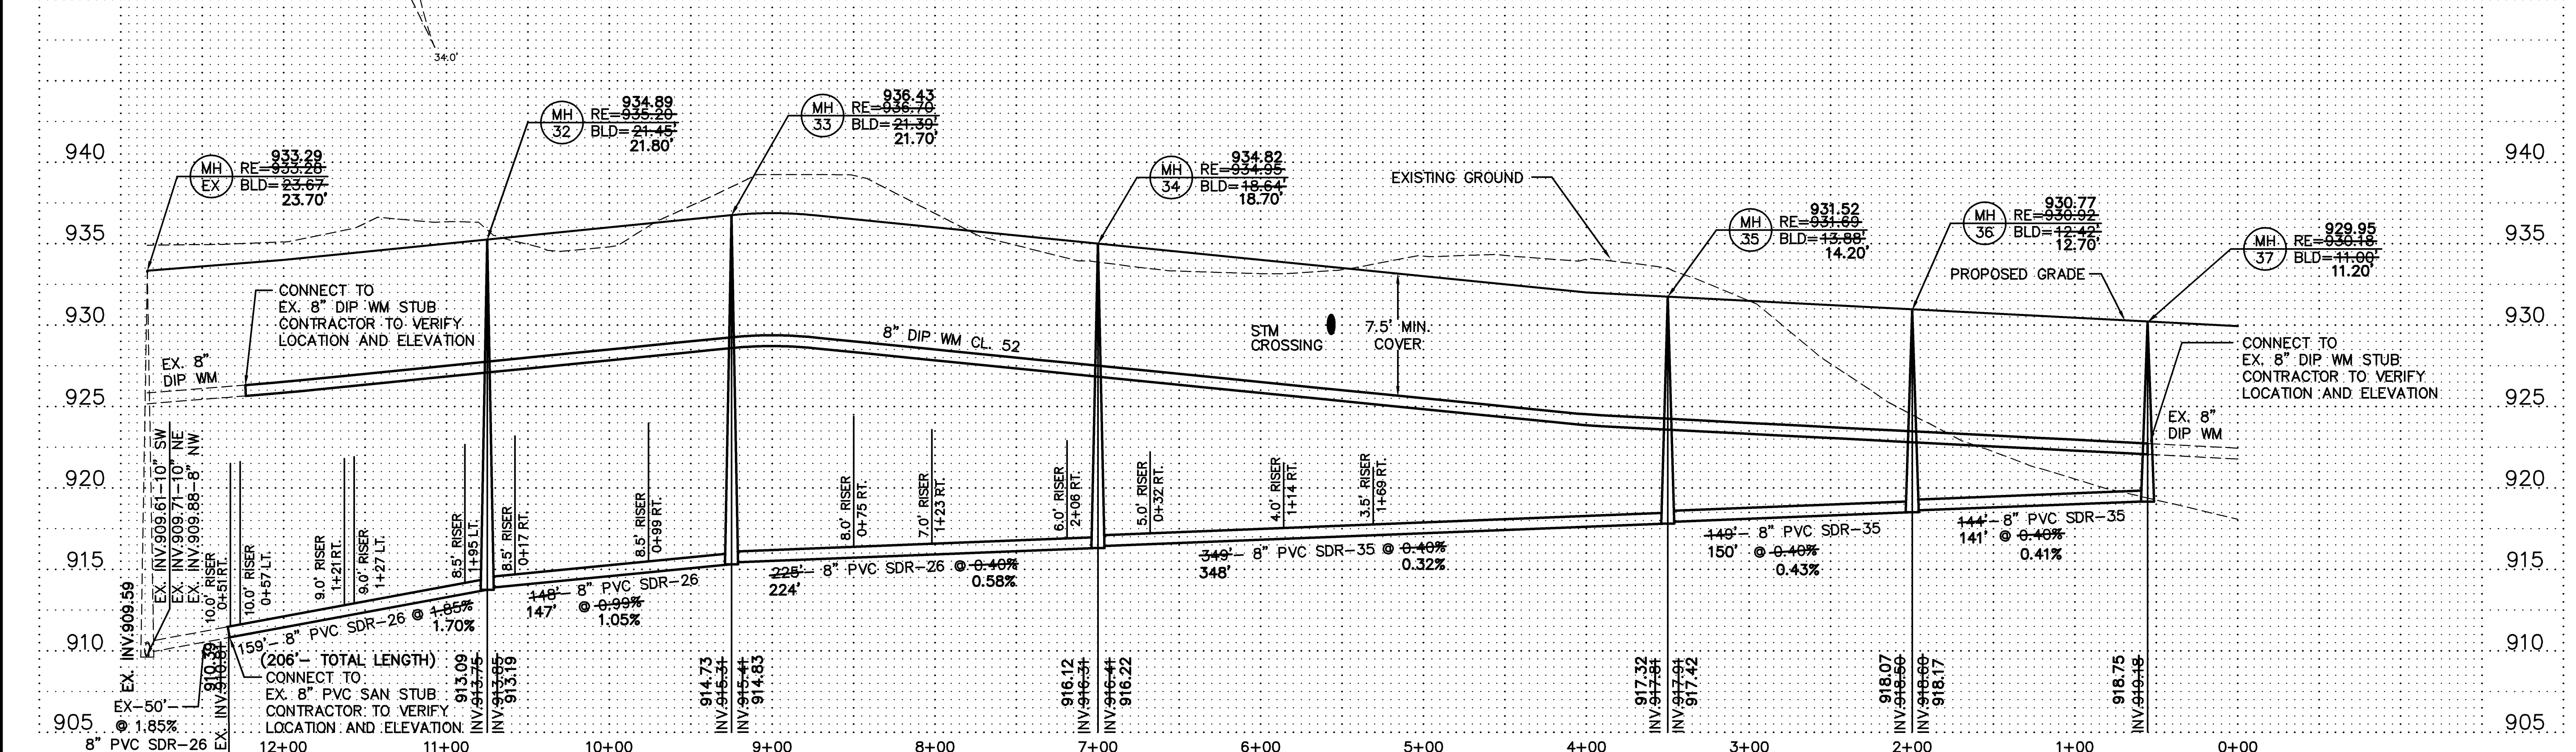

PIONEER engineering
 CIVIL ENGINEERS LAND PLANNERS LAND SURVEYORS LANDSCAPE ARCHITECTS

RECORD PLAN 10-5-09