


**RECORD PLAN 2009**


**CONTRACTOR**

RYAN CONTRACTING CO.  
PO BOX 246  
ELKO, MINNESOTA 55020  
(952) 894-3200

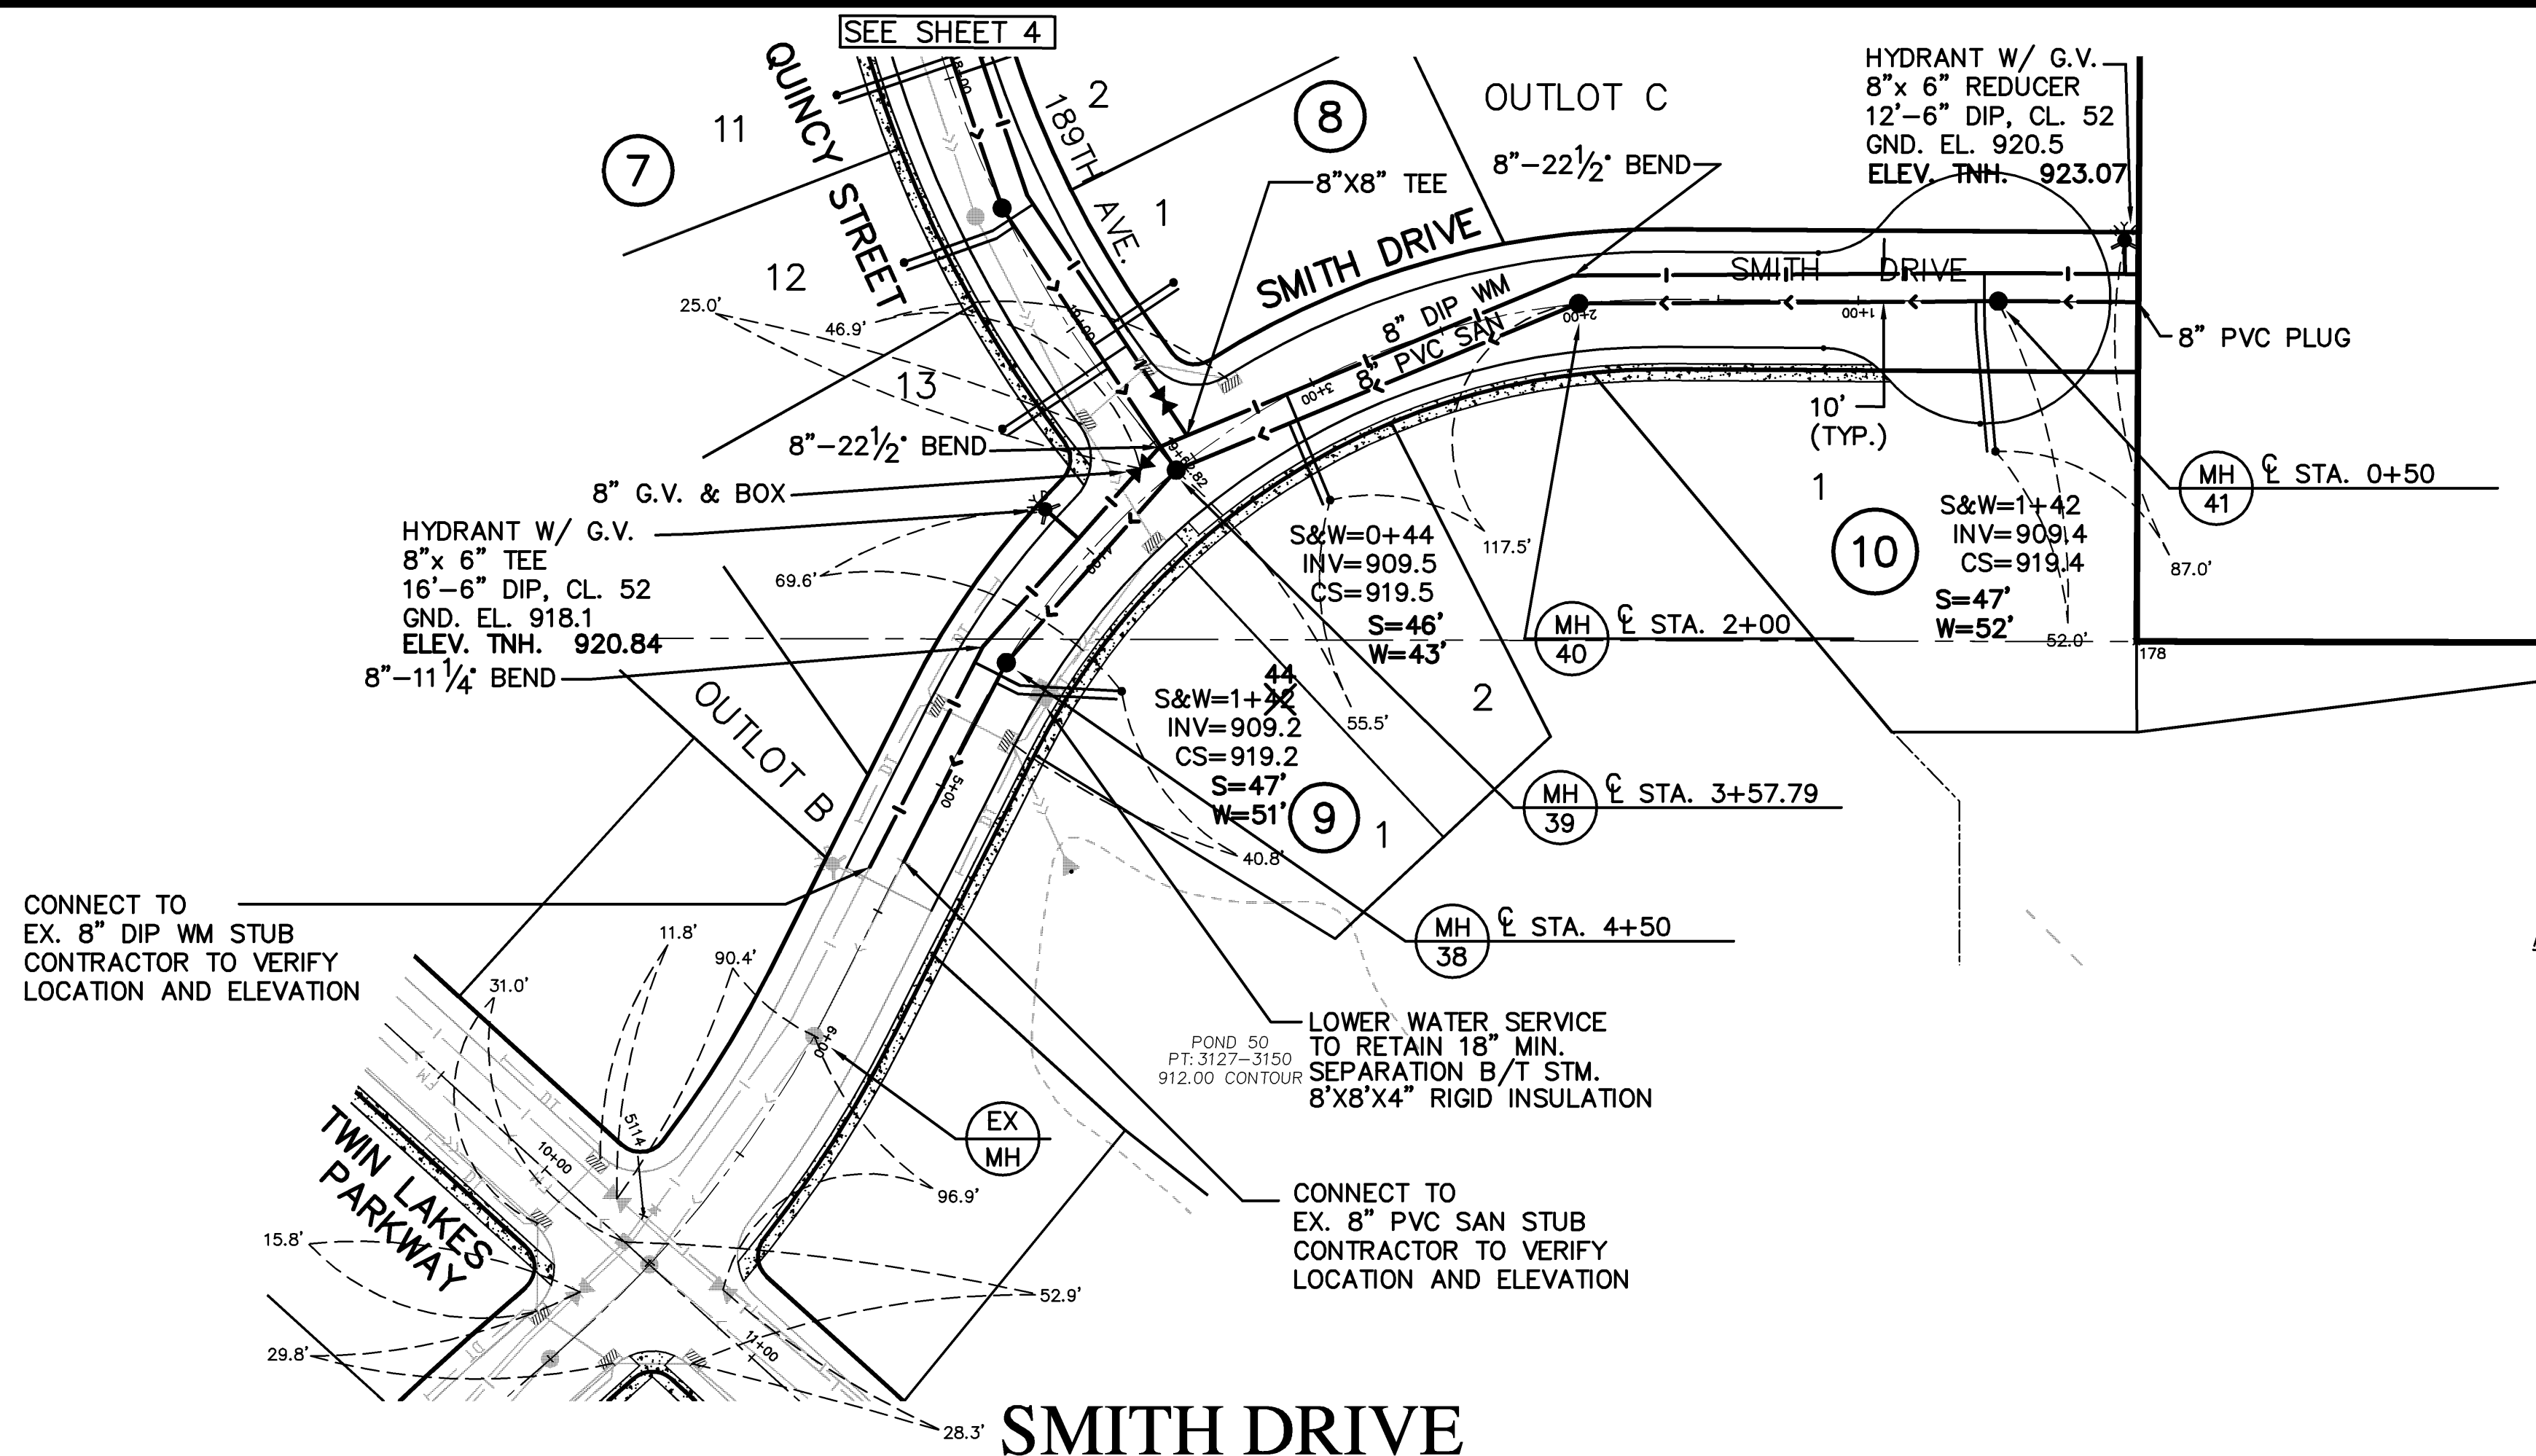

**GENERAL NOTES:**

- 1.) SANITARY SEWER SERVICES SHALL BE 4" PVC SDR-35.
- 2.) SANITARY SEWER SERVICE WYES ARE STATIONED FROM DOWN STREAM MANHOLE.
- 3.) WATER SERVICES SHALL BE 1" COPPER TYPE "K" W/ 7.5' MINIMUM COVER.
- 4.) SANITARY SEWER INVERTS ARE SHOWN AT THE SERVICE STUB NEAR CURB STOP.
- 5.) SANITARY SEWER AND WATER SERVICES SHALL BE CONSTRUCTED 15' BEYOND RIGHT-OF-WAY.

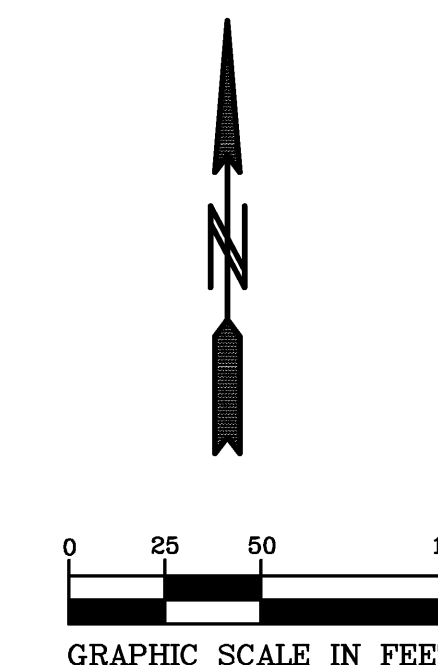

**BENCH MARKS**

CAST IRON MONUMENT: NORTHEAST CORNER OF SEC. 35, TWP. 33, RING. 26.  
ELEVATION = 904.80

CAST IRON MONUMENT: NORTH QUARTER CORNER OF SEC. 35, TWP. 33, RING. 26.  
ELEVATION = 935.67

