

# Construction Plans


for

## Sanitary Sewer, Water Main, Storm Sewer and Streets

for

# Trott Brook Farms

Elk River, Mn.

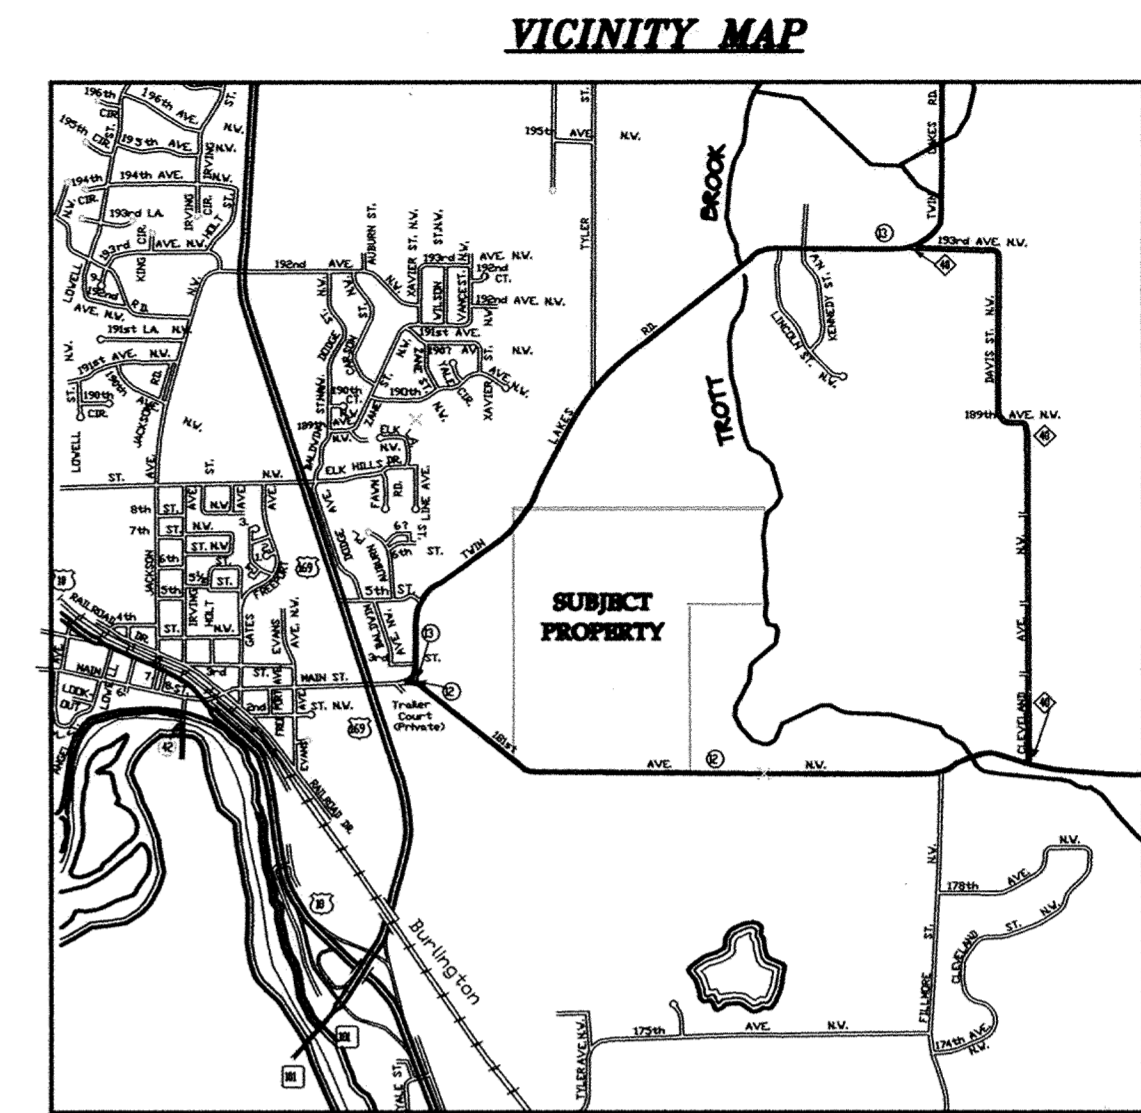

INDEX	
SHEET NO.	DESCRIPTION
1	COVER
2	OVERALL UTILITY PLAN
3 - 13	SANITARY SEWER & WATER MAIN CONSTRUCTION PLAN
14 - 25	STORM SEWER & STREET CONSTRUCTION PLAN
26	LIFT STATION DETAIL
27	LIFT STATION ELECTRICAL DETAILS
28	SANITARY SEWER DETAILS
29	WATER MAIN DETAILS
30	STORM SEWER DETAILS
31	STREET CONSTRUCTION DETAILS
32	MISCELLANEOUS DETAILS

NO.	DATE	REVISION
1	6/25/99	
2	7/23/99	PER CITY REDLINES
3	7/27/99	PER CITY REDLINES

CONTRACTOR: RYAN CONTRACTING, INC.  
**RECORD DRAWING**  
 CONFORMING TO CONSTRUCTION RECORDS.  
 BY S. HUTTNER DATE 7/20/01  
 WESTWOOD PROFESSIONAL SERVICES

prepared for:

### D.R. Horton. INC.

3459 Washington Drive, Suite 204  
Eagan, Minnesota 55122  
Contact: Don Patton  
Phone: (651) 454-4663

prepared by:



Westwood Professional Services, Inc.  
7599 Anagram Drive  
Eden Prairie, Minnesota 55344  
Contact: Fran Hagen, II  
Phone : (612) 937-5150  
PROJECT NO. 99605

### Construction Plans

for

## Sanitary Sewer, Water Main, Storm Sewer and Streets

for

# Trott Brook Farms

Elk River, Minnesota

DATE  
6/1/99

SHEET  
1 OF 32

DRAWING NUMBER

DRAWING NUMBER

DRAWING NUMBER

DRAWING NUMBER  
1

PROJECT NO. 99605 - SANITARY SEWER, WATER MAIN, STORM SEWER, AND STREETS - ELK RIVER, MN  
DRAWING NO. TROT11-4.99  
DATE 6/1/99  
SHEET 1 OF 32

Sheet 1 of 32

P:\96367\dwg\AS-BUILD\6367CVB1.dwg 01/26/2000 09:21:12 AM CST

96367 9805CVB1.dwg