

GENERAL NOTES:

(XXX.X) DENOTES SANITARY SEWER SERVICE INVERT @ ROW LINE. ALL SERVICES SHALL BE EXTENDED 9' INTO PROPERTY. WHERE SIDEWALK IS BEING CONSTRUCTED.




WYE=X+XX DENOTES SANITARY SEWER SERVICE WYE LOCATED ON MAINLINE FROM DOWN STREAM M.H.

FLAG HYDRANTS.
EXTEND RODS ON DEEP VALVES.


CONTRACTOR: RYAN CONTRACTING, INC.

RECORD DRAWING
CONFORMING TO CONSTRUCTION RECORDS.
BY S. HUTTNER DATE 7/20/01
WESTWOOD PROFESSIONAL SERVICES

Call 48 Hours before digging:
GOPHER STATE ONE CALL
Twin City Area 651-454-0002
Mn. Toll Free 1-800-252-1166

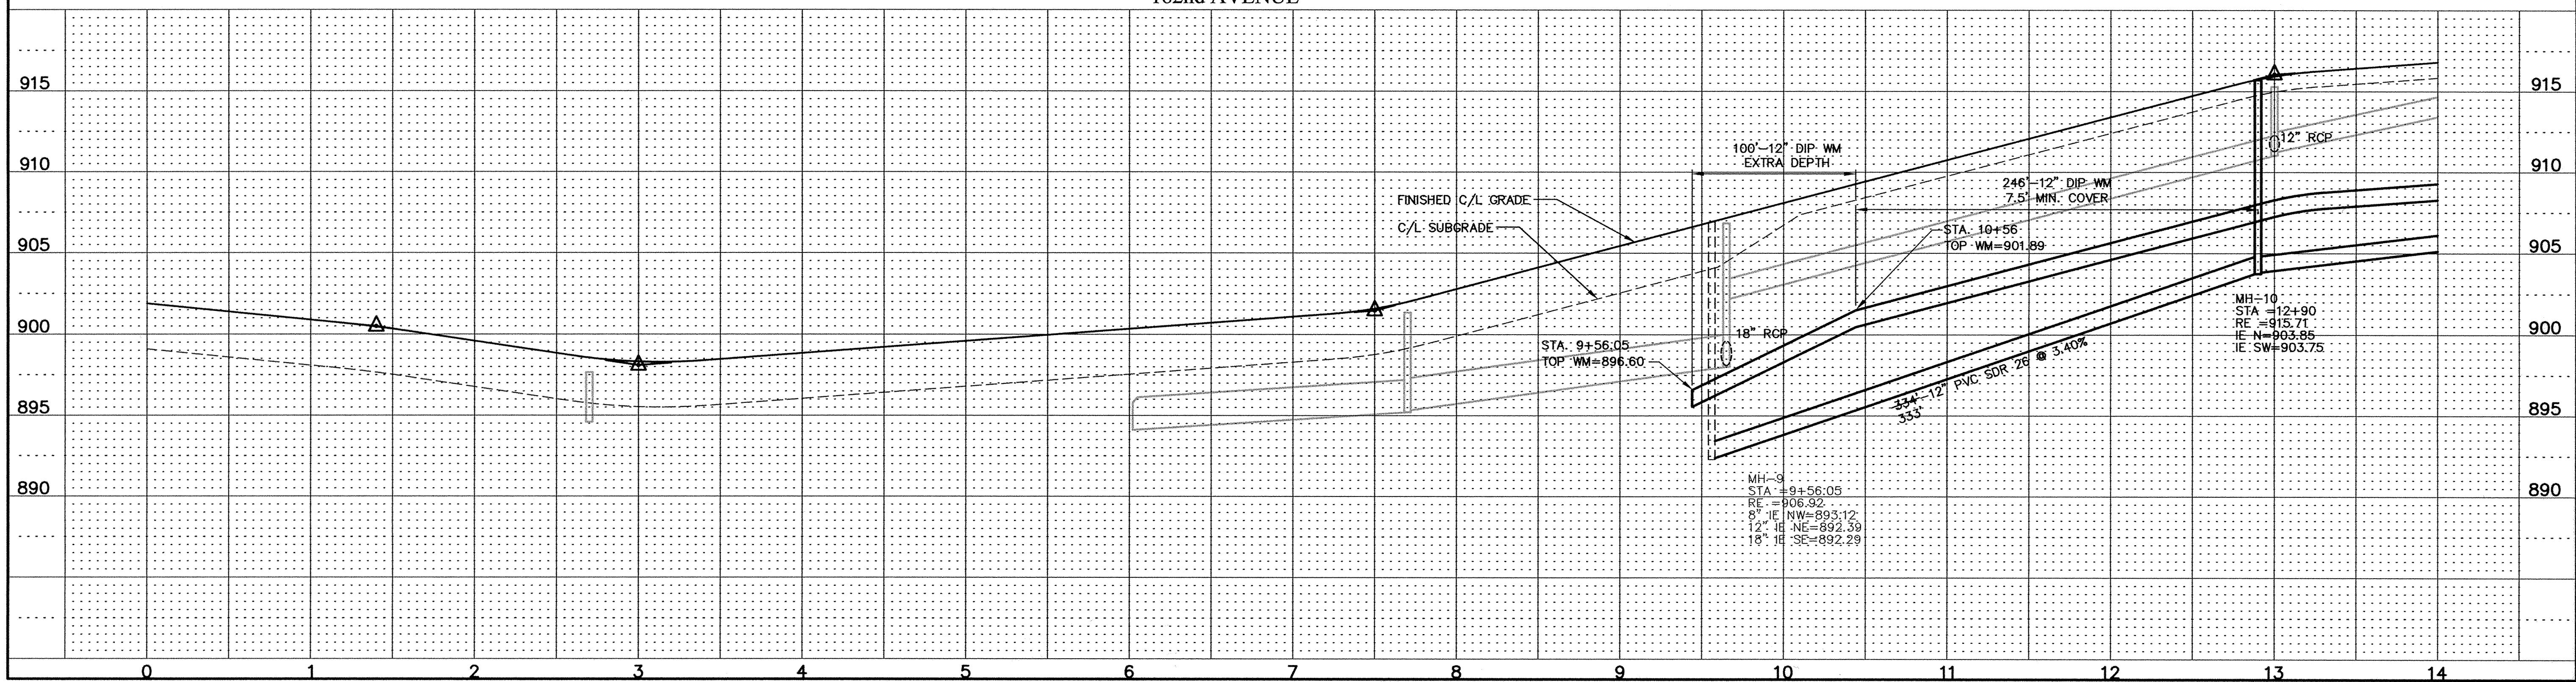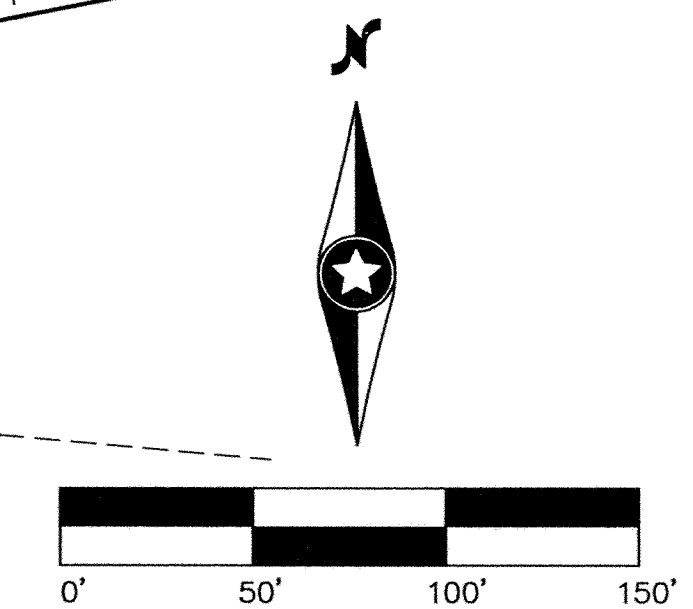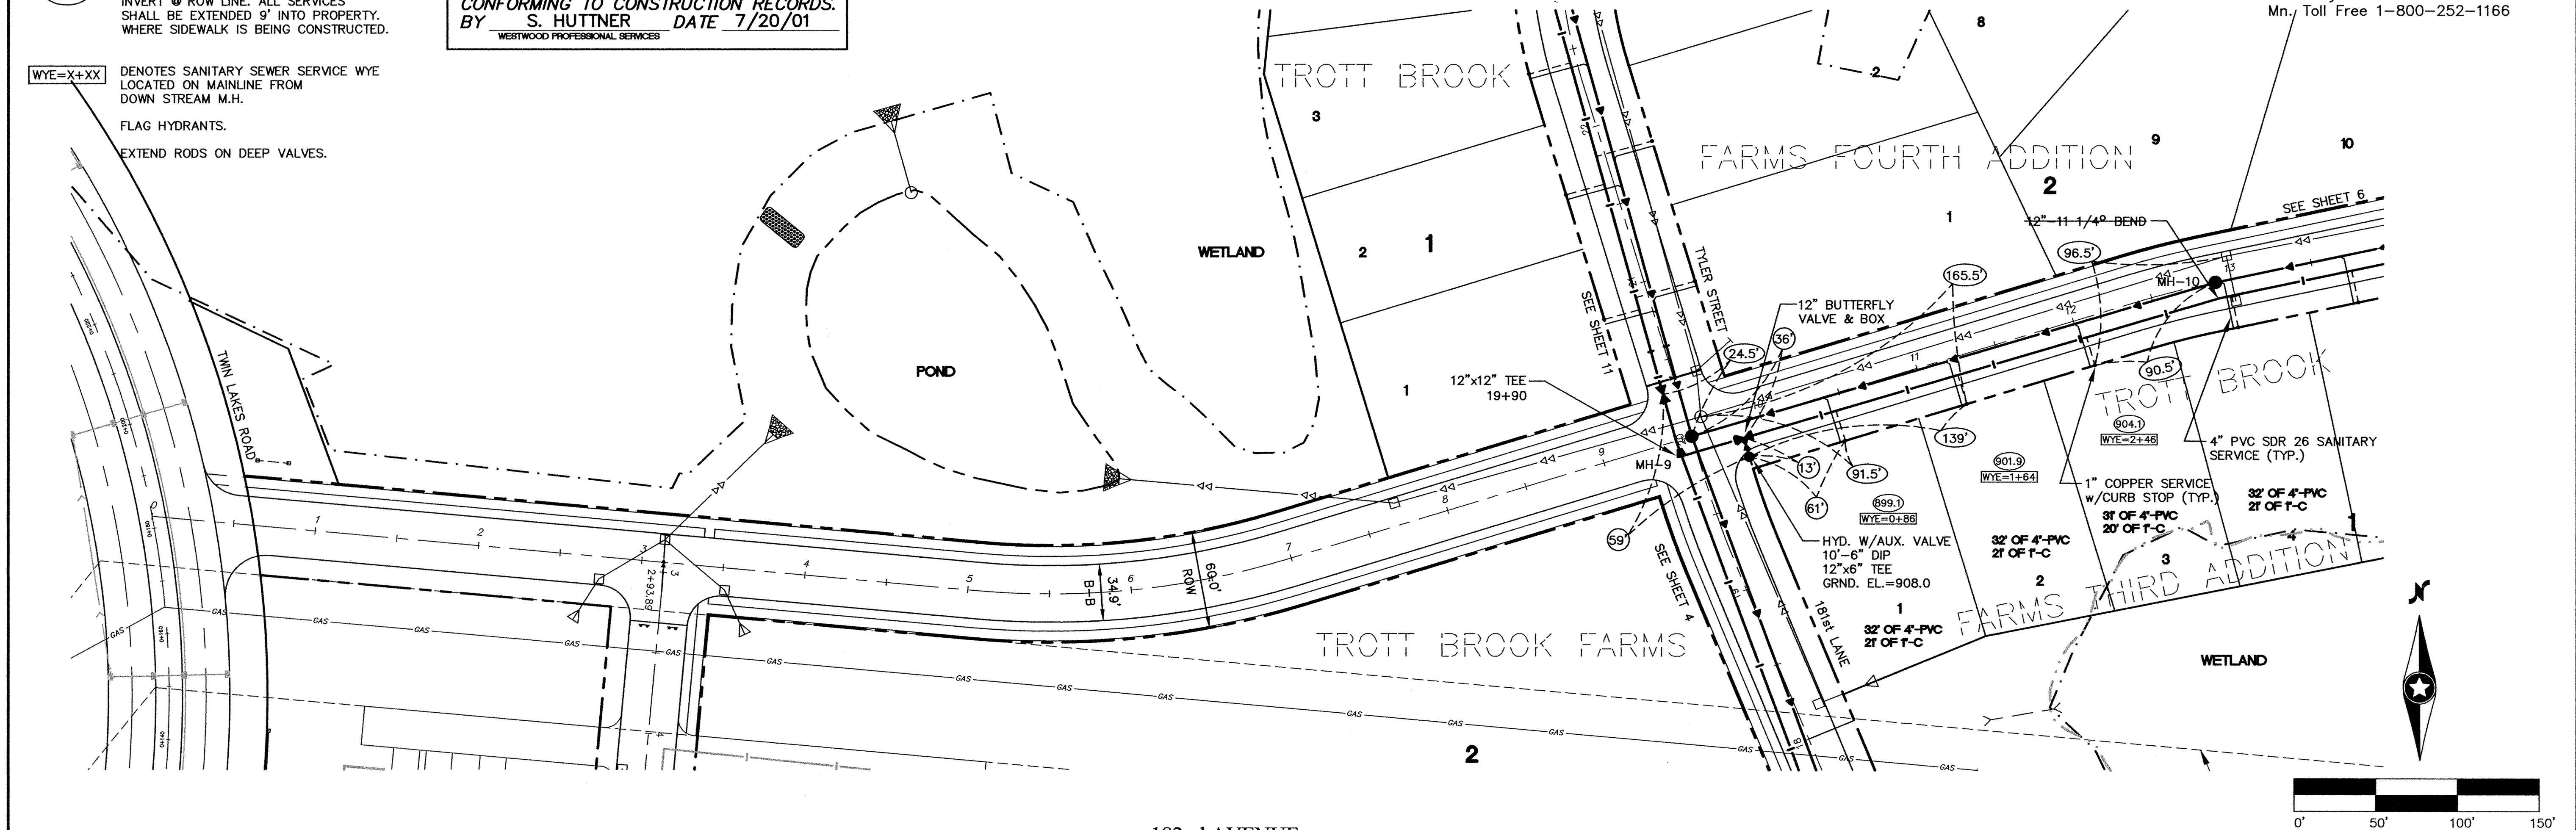

| REVISIONS |
|---------------------------|
| 6/28/99 |
| 7/23/99 PER CITY REDLINES |
| 7/27/99 PER CITY REDLINES |

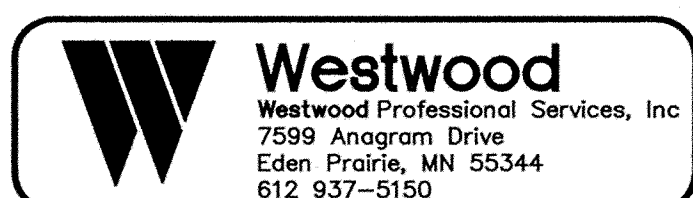

I hereby certify that this plan was prepared by me or under my direct supervision and that I am a duly registered PROFESSIONAL ENGINEER under the laws of the State of Minnesota.
DATE 7/27/99 REG. NO. 17716

DESIGNED FDH, II CHECKED FDH, II
DRAWN WH RECORD DRAWING BY/DATE

PREPARED FOR:
D.R. Horton, INC.
3459 Washington Drive
Suite 204
Eagan, Minnesota 55122

Trott Brook Farms
Elk River, Minnesota

Sanitary Sewer & Water Main Construction Plan

LATEST REVISION DATE: 7/27/99
DATE 6/1/99
SHEET 5 OF 32

DRAWING NUMBER TROTT14-99 5

P:\95657\dwg\6567\TIF3.dwg 07/27/99 04:09:44 PM CBT