

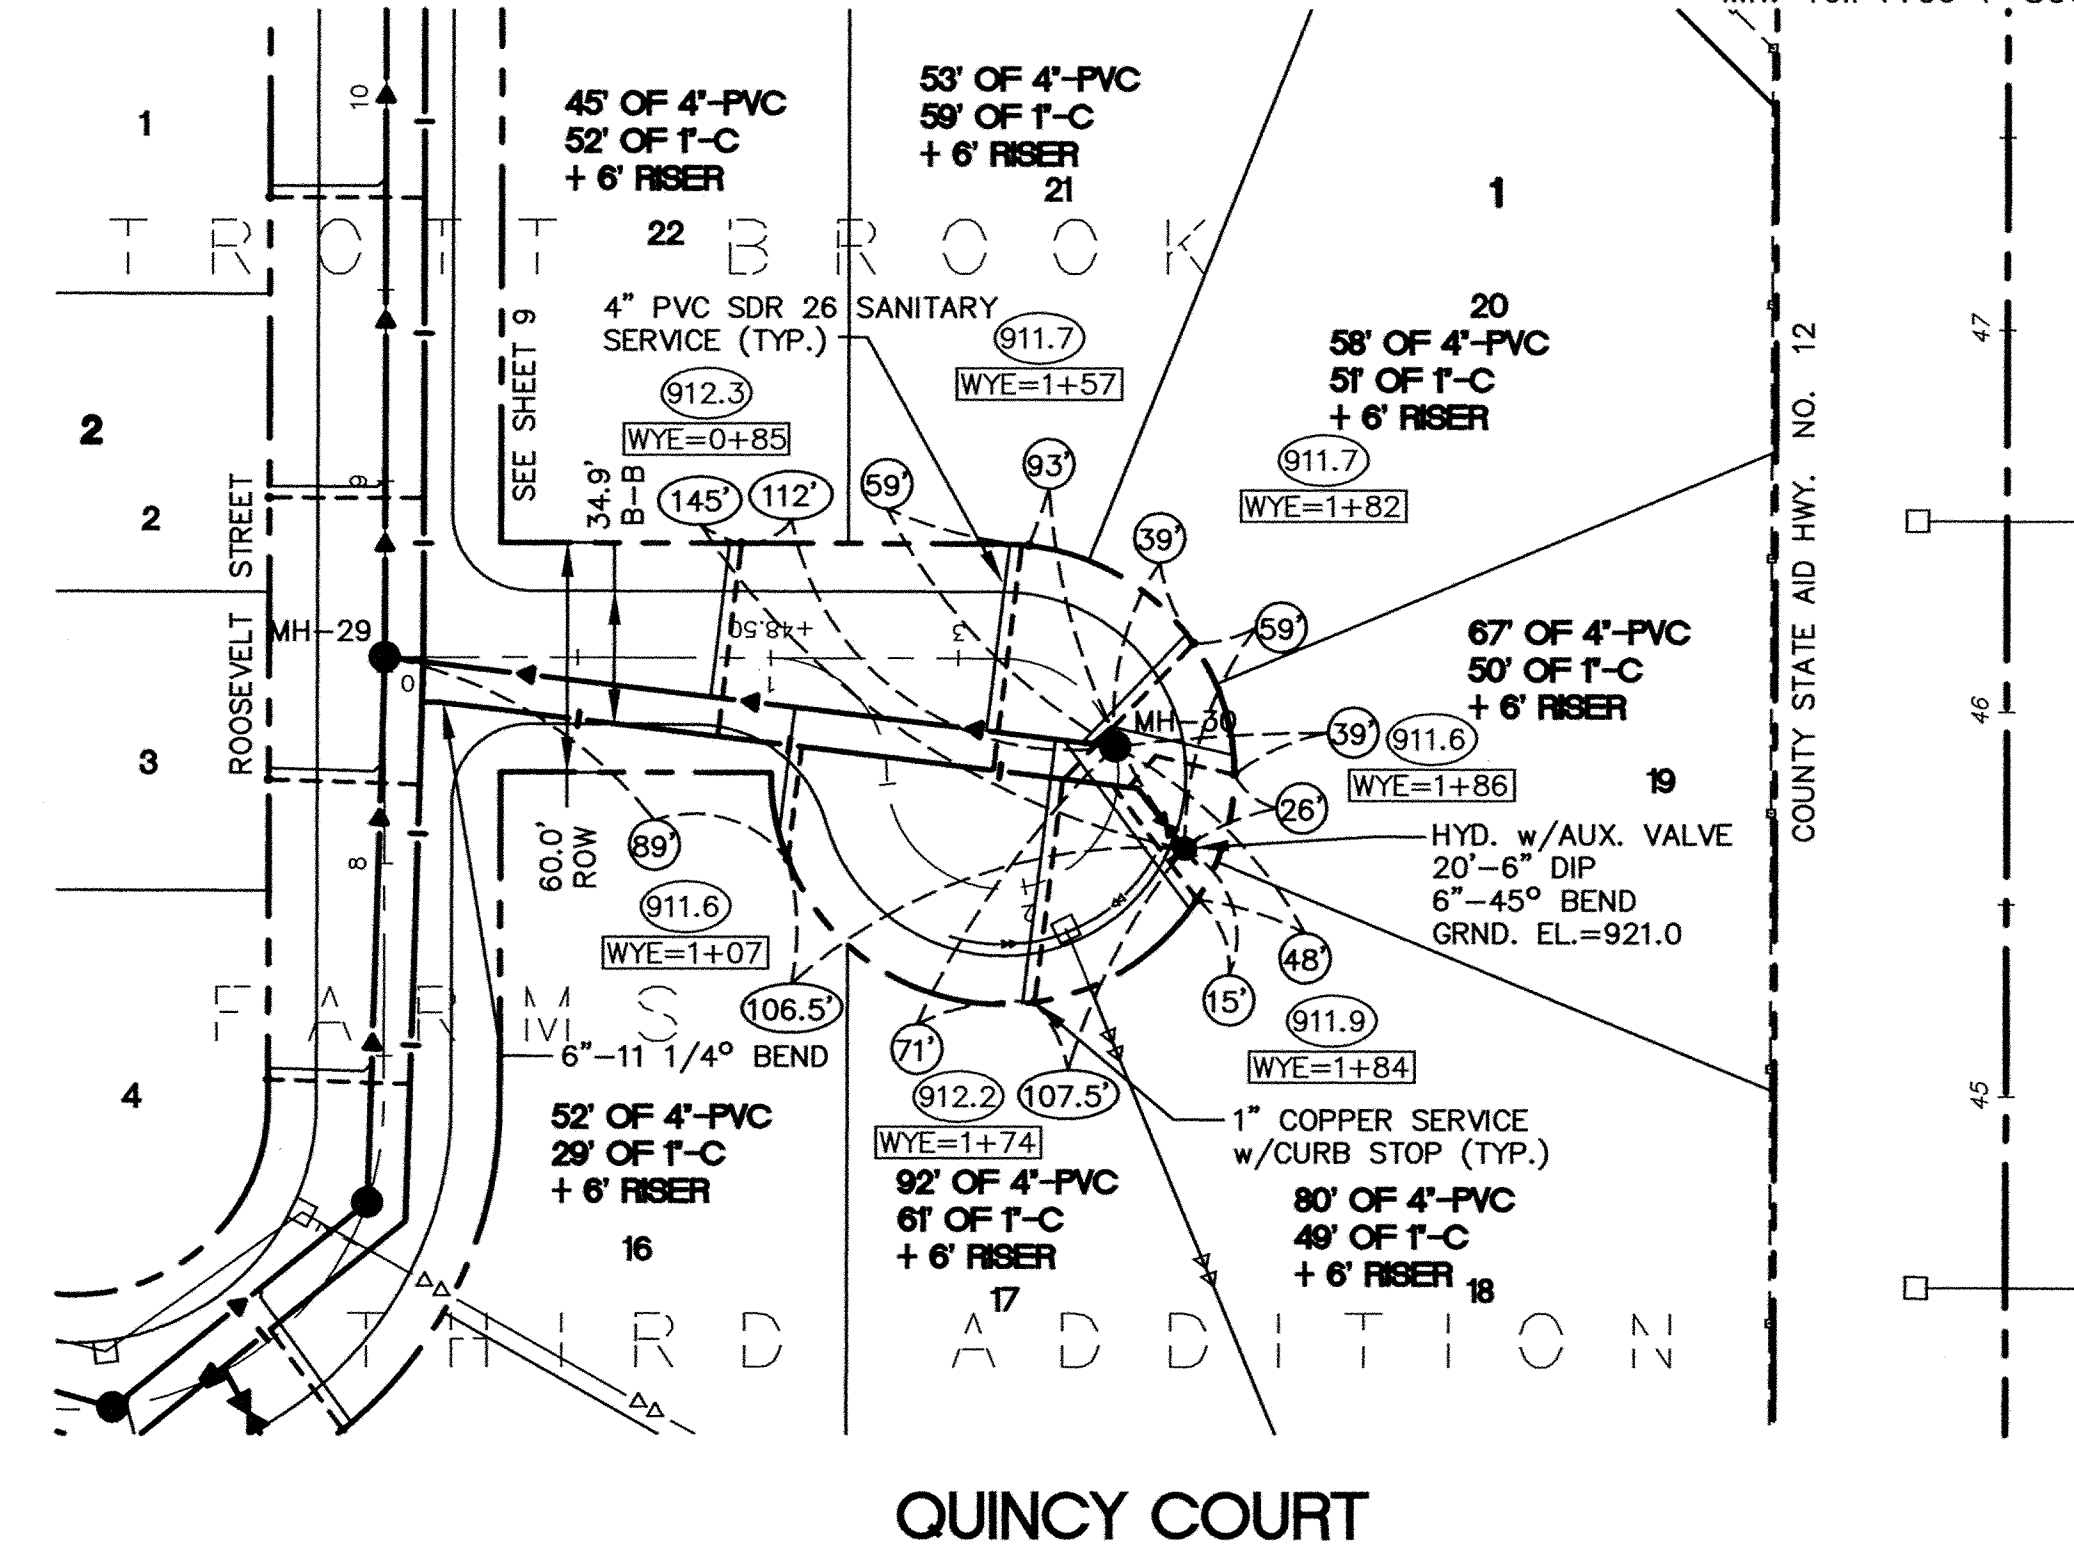


GENERAL NOTES:

- (XXX.X) DENOTES SANITARY SEWER SERVICE INVERT @ ROW LINE. ALL SERVICES SHALL BE EXTENDED 9' INTO PROPERTY. WHERE SIDEWALK IS BEING CONSTRUCTED.
- WYE=X+XX DENOTES SANITARY SEWER SERVICE WYE LOCATED ON MAINLINE FROM DOWN STREAM M.H.
- FLAG HYDRANTS.
- EXTEND RODS ON DEEP VALVES.
- ALL DROP MANHOLES TO BE CONSTRUCTED USING OUTSIDE DROPS.

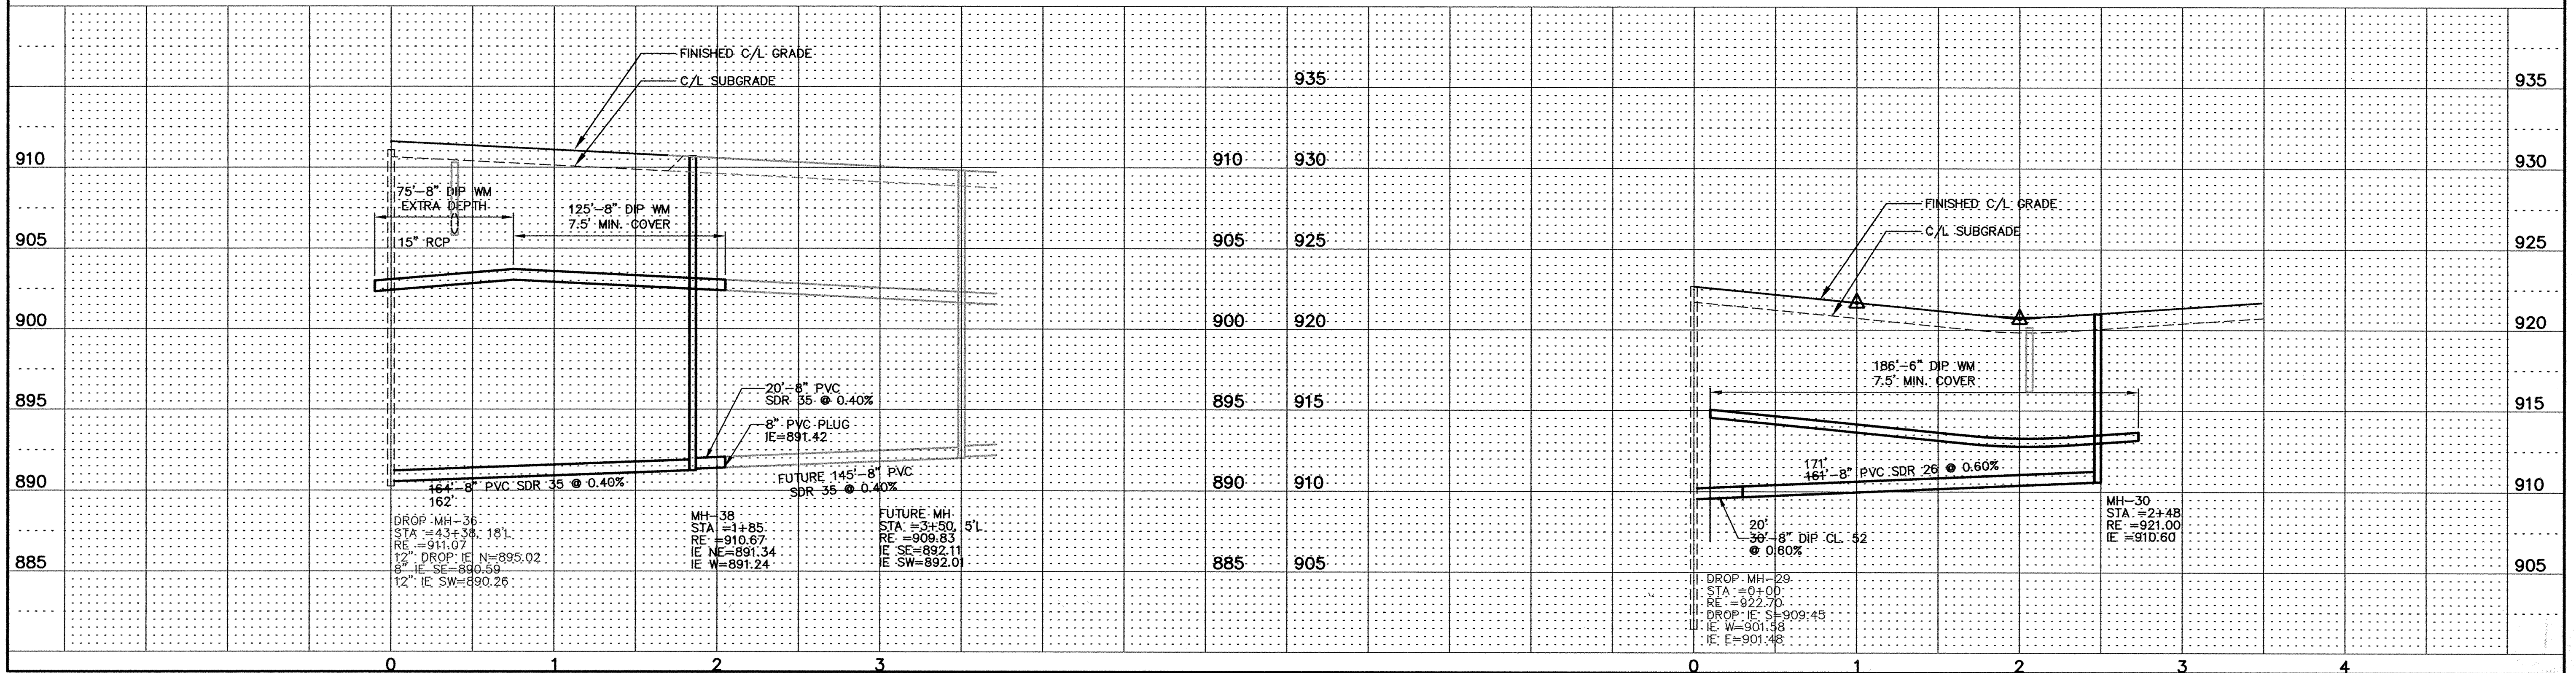

CONTRACTOR: RYAN CONTRACTING, INC.
 RECORD DRAWING
 CONFORMING TO CONSTRUCTION RECORDS.
 BY S. HUTTNER DATE 7/20/01
 WESTWOOD PROFESSIONAL SERVICES

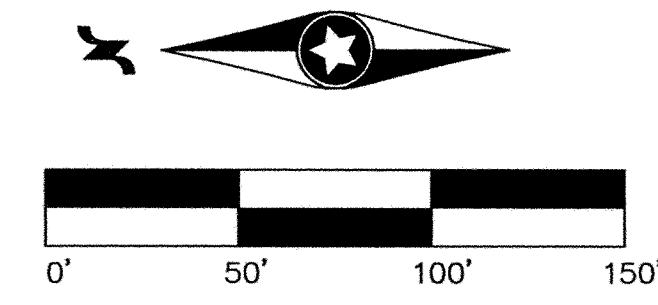

REVISIONS

6/28/99	PER CITY REDLINES
7/23/99	PER CITY REDLINES
7/27/99	PER CITY REDLINES



I hereby certify that this plan was prepared by me or under my direct supervision and that I am a duly registered PROFESSIONAL ENGINEER under the laws of the State of Minnesota.
 DATE 7/27/99 REG. NO. 17716

DESIGNED	FDH, II	CHECKED	FDH, II
DRAWN	WH	RECORD DRAWING BY/DATE	

PREPARED FOR:
D.R. Horton, INC.
 3459 Washington Drive
 Suite 204
 Eagan, Minnesota 55122

Trott Brook Farms
 Elk River, Minnesota

Sanitary Sewer & Water Main Construction Plan

DATE 6/1/99
 SHEET 10 OF 32