
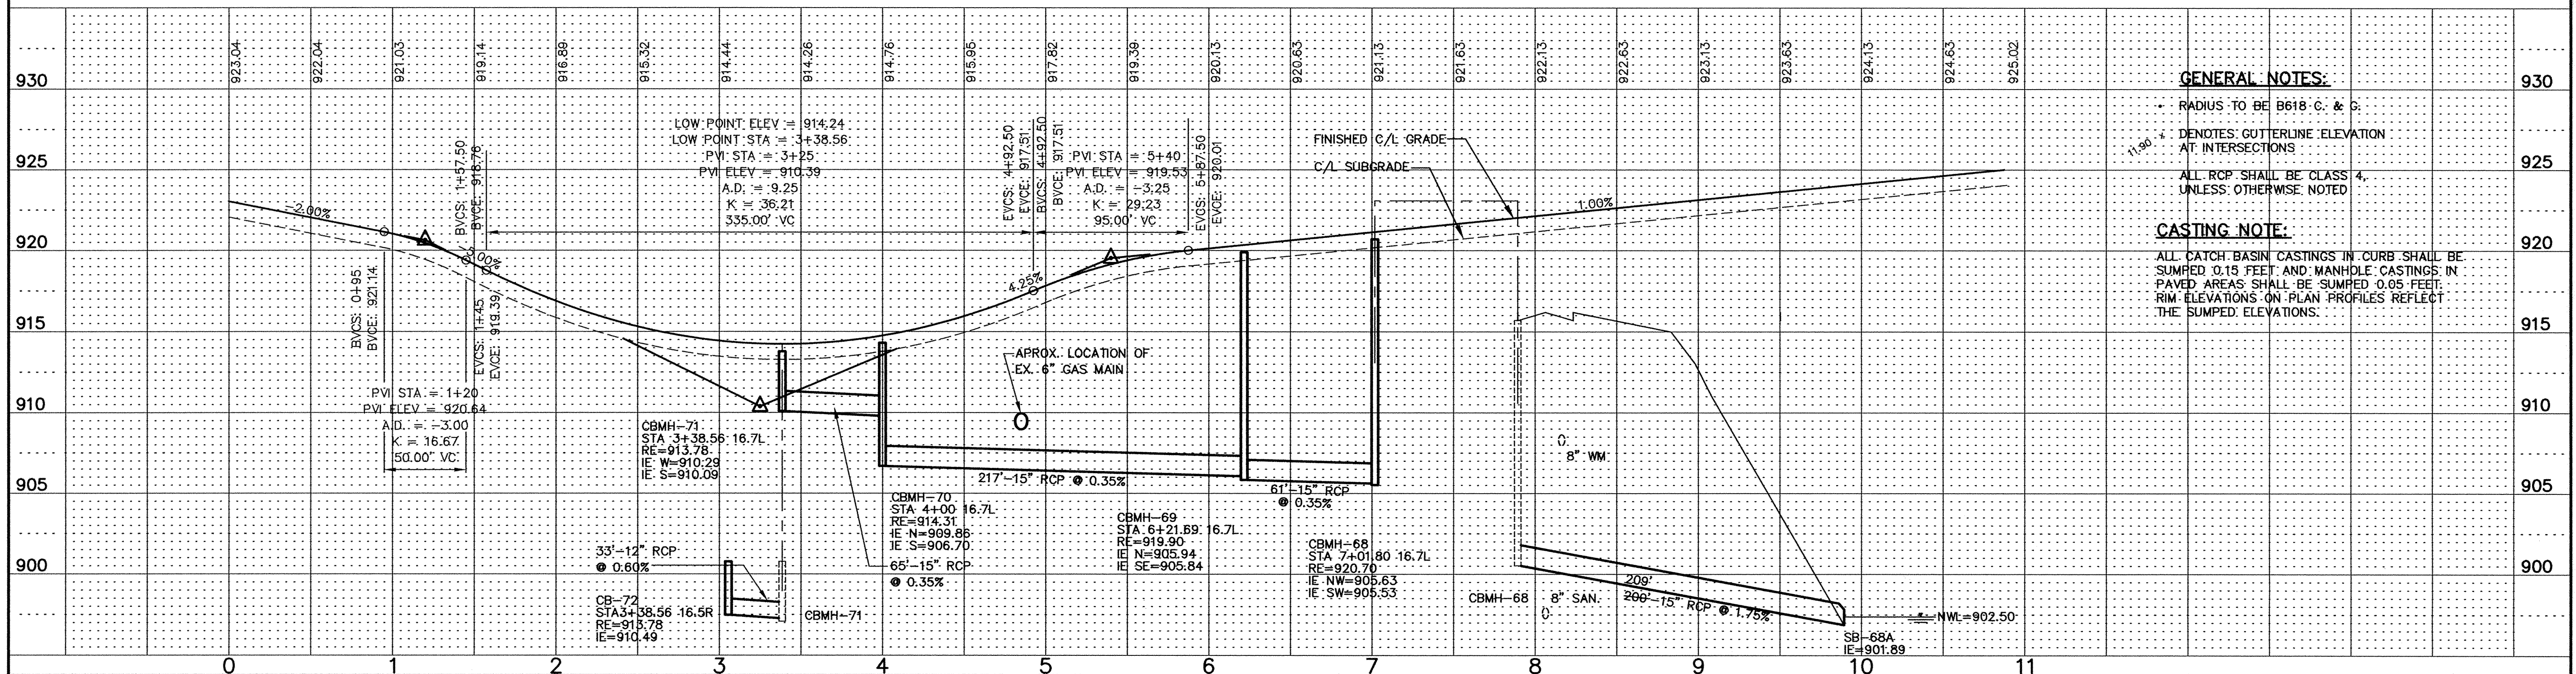


**ROOSEVELT STREET**

**CONTRACTOR: RYAN CONTRACTING, INC.**  
**RECORD DRAWING**  
 CONFORMING TO CONSTRUCTION RECORDS.  
 BY **S. HUTTNER** DATE **7/20/01**  
 WESTWOOD PROFESSIONAL SERVICES

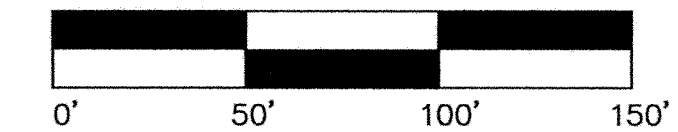

**GENERAL NOTES:**

- RADIUS TO BE B618-C & G.
- NOTES: GUTTERLINE ELEVATION AT INTERSECTIONS.
- ALL RCP SHALL BE CLASS 4, UNLESS OTHERWISE NOTED.

**CASTING NOTE:**

ALL CATCH BASIN CASTINGS IN CURB SHALL BE SUMPED 0.15 FEET AND MANHOLE CASTINGS IN PAVED AREAS SHALL BE SUMPED 0.05 FEET. RIM ELEVATIONS ON PLAN PROFILES REFLECT THE SUMPED ELEVATIONS.

P:\56367.dwg\6367STF7.dwg 07/27/99 05:58:24 PM CDT

| REVISIONS                 |
|---------------------------|
| 6/28/99                   |
| 7/23/99 PER CITY REDLINES |
| 7/27/99 PER CITY REDLINES |

I hereby certify that this plan was prepared by me or under my direct supervision and that I am a duly registered PROFESSIONAL ENGINEER under the laws of the State of Minnesota.  
 DATE 7/27/99 REG. NO. 17716

|          |         |                        |         |
|----------|---------|------------------------|---------|
| DESIGNED | FDH, II | CHECKED                | FDH, II |
| DRAWN    | WH      | RECORD DRAWING BY/DATE |         |

PREPARED FOR:  
**D.R. Horton, INC.**  
 3459 Washington Drive  
 Suite 204  
 Eagan, Minnesota 55122

**Trott Brook Farms**  
 Elk River, Minnesota

**Storm Sewer & Street Construction Plan**

DATE **6/1/99**  
 SHEET **20 OF 32**