

# Record Drawings

for

## Sanitary Sewer, Water Main, Storm Sewer and Streets


for

### Trott Brook Farms 12th Addition Elk River, Minnesota

Prepared for:

**D.R. Horton, Inc.**  
 20860 Kenbridge Court, Suite 100  
 Lakeville, MN 55044  
 Contact: Tom Bakritges  
 Phone: 952-985-7826  
 Fax: 952-985-7800


Prepared by:

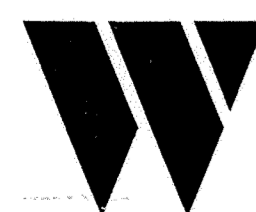

**Westwood** Professional Services, Inc.  
 7599 Anagram Drive  
 Eden Prairie, MN 55344  
 Phone: 952-937-5150 Fax: 952-937-5822

Project number: 20041210  
 Contact: Jason M. McCarty P.E.

### Vicinity Map

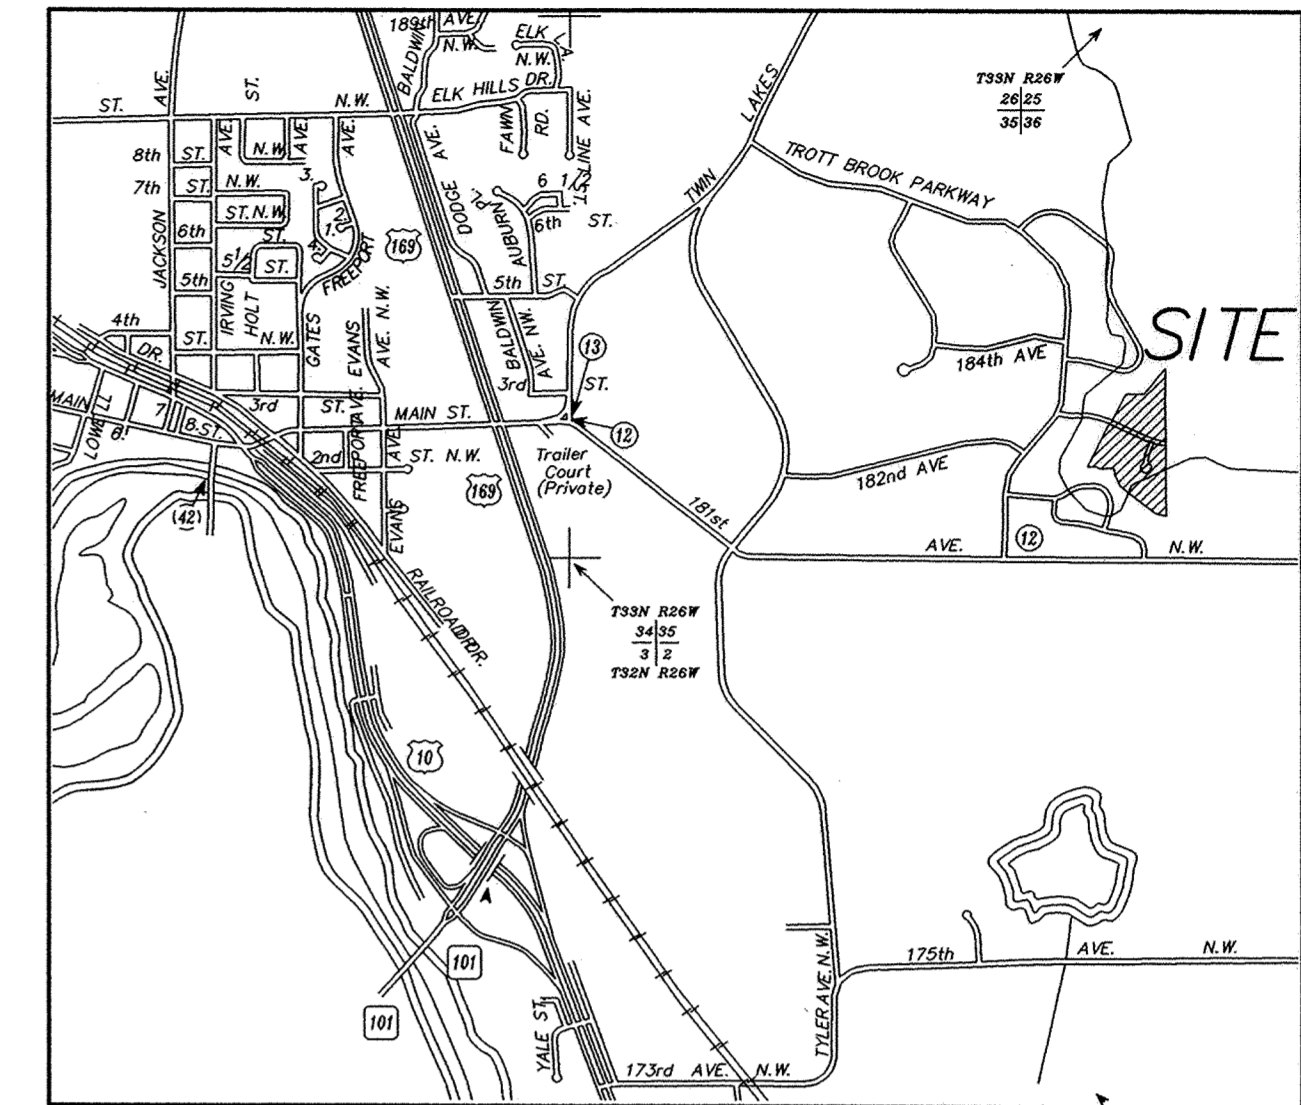

**ELK RIVER**  
No Scale

CONTRACTOR: Hennen Construction Co.  
 14520 Main Street  
 Rogers, MN 55374  
 # 763-428-4177

RECORD DRAWING  
 CONFORMING TO CONSTRUCTION RECORDS.  
 BY Zak Spang DATE 04/25/07  
 WESTWOOD PROFESSIONAL SERVICES

NO.	DATE	REVISION	SHEETS
1	04/14/06	REVISED GRADING CHANGES	ALL
2	04/21/06	CLIENT REVIEW	ALL
3	05/05/06	CLIENT REVIEW	ALL
4	05/18/06	LOT 8/9 LINE ADJUSTMENT	ALL
5	07/05/06	CITY COMMENTS	ALL
6	03/05/07	RECORD DRAWINGS	ALL
7	04/25/07	FINAL RECORD DRAWINGS	ALL

INDEX	
SHEET NO.	DESCRIPTION
1	COVER
2	OVERALL PLAN
3	SANITARY SEWER & WATER MAIN – 183rd AVENUE & MONROE COURT
4	STORM SEWER & STREET CONST. – 183rd AVENUE
5	STORM SEWER & STREET CONST. – MONROE COURT
6	STORM SEWER & STREET CONST. – BOX CULVERT
7-10	DETAILS

### Construction Plans

for  
**Sanitary Sewer, Water Main, Storm Sewer  
 and Streets**  
 for  
**Trott Brook Farms 12th Addition**  
 Elk River, Minnesota