

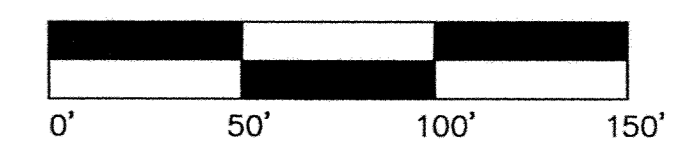


GENERAL NOTES:
XXX.X DENOTES SANITARY SEWER SERVICE INVERT @ TOWNHOME PROPERTY LINE.
WYE=X+XX DENOTES SANITARY SEWER SERVICE WYE LOCATED ON MAINLINE FROM DOWN STREAM M.H.
FLAG HYDRANTS.
EXTEND RODS ON DEEP VALVES.
ALL DROP MANHOLES TO BE CONSTRUCTED USING OUTSIDE DROPS.
ALL SANITARY SEWER MAIN SHALL BE SDR 35 UNLESS OTHERWISE NOTED.

CONTRACTOR: RYAN CONTRACTING, INC.
RECORD DRAWING
CONFORMING TO CONSTRUCTION RECORDS.
BY K. WOOD DATE 3/14/01
WESTWOOD PROFESSIONAL SERVICES

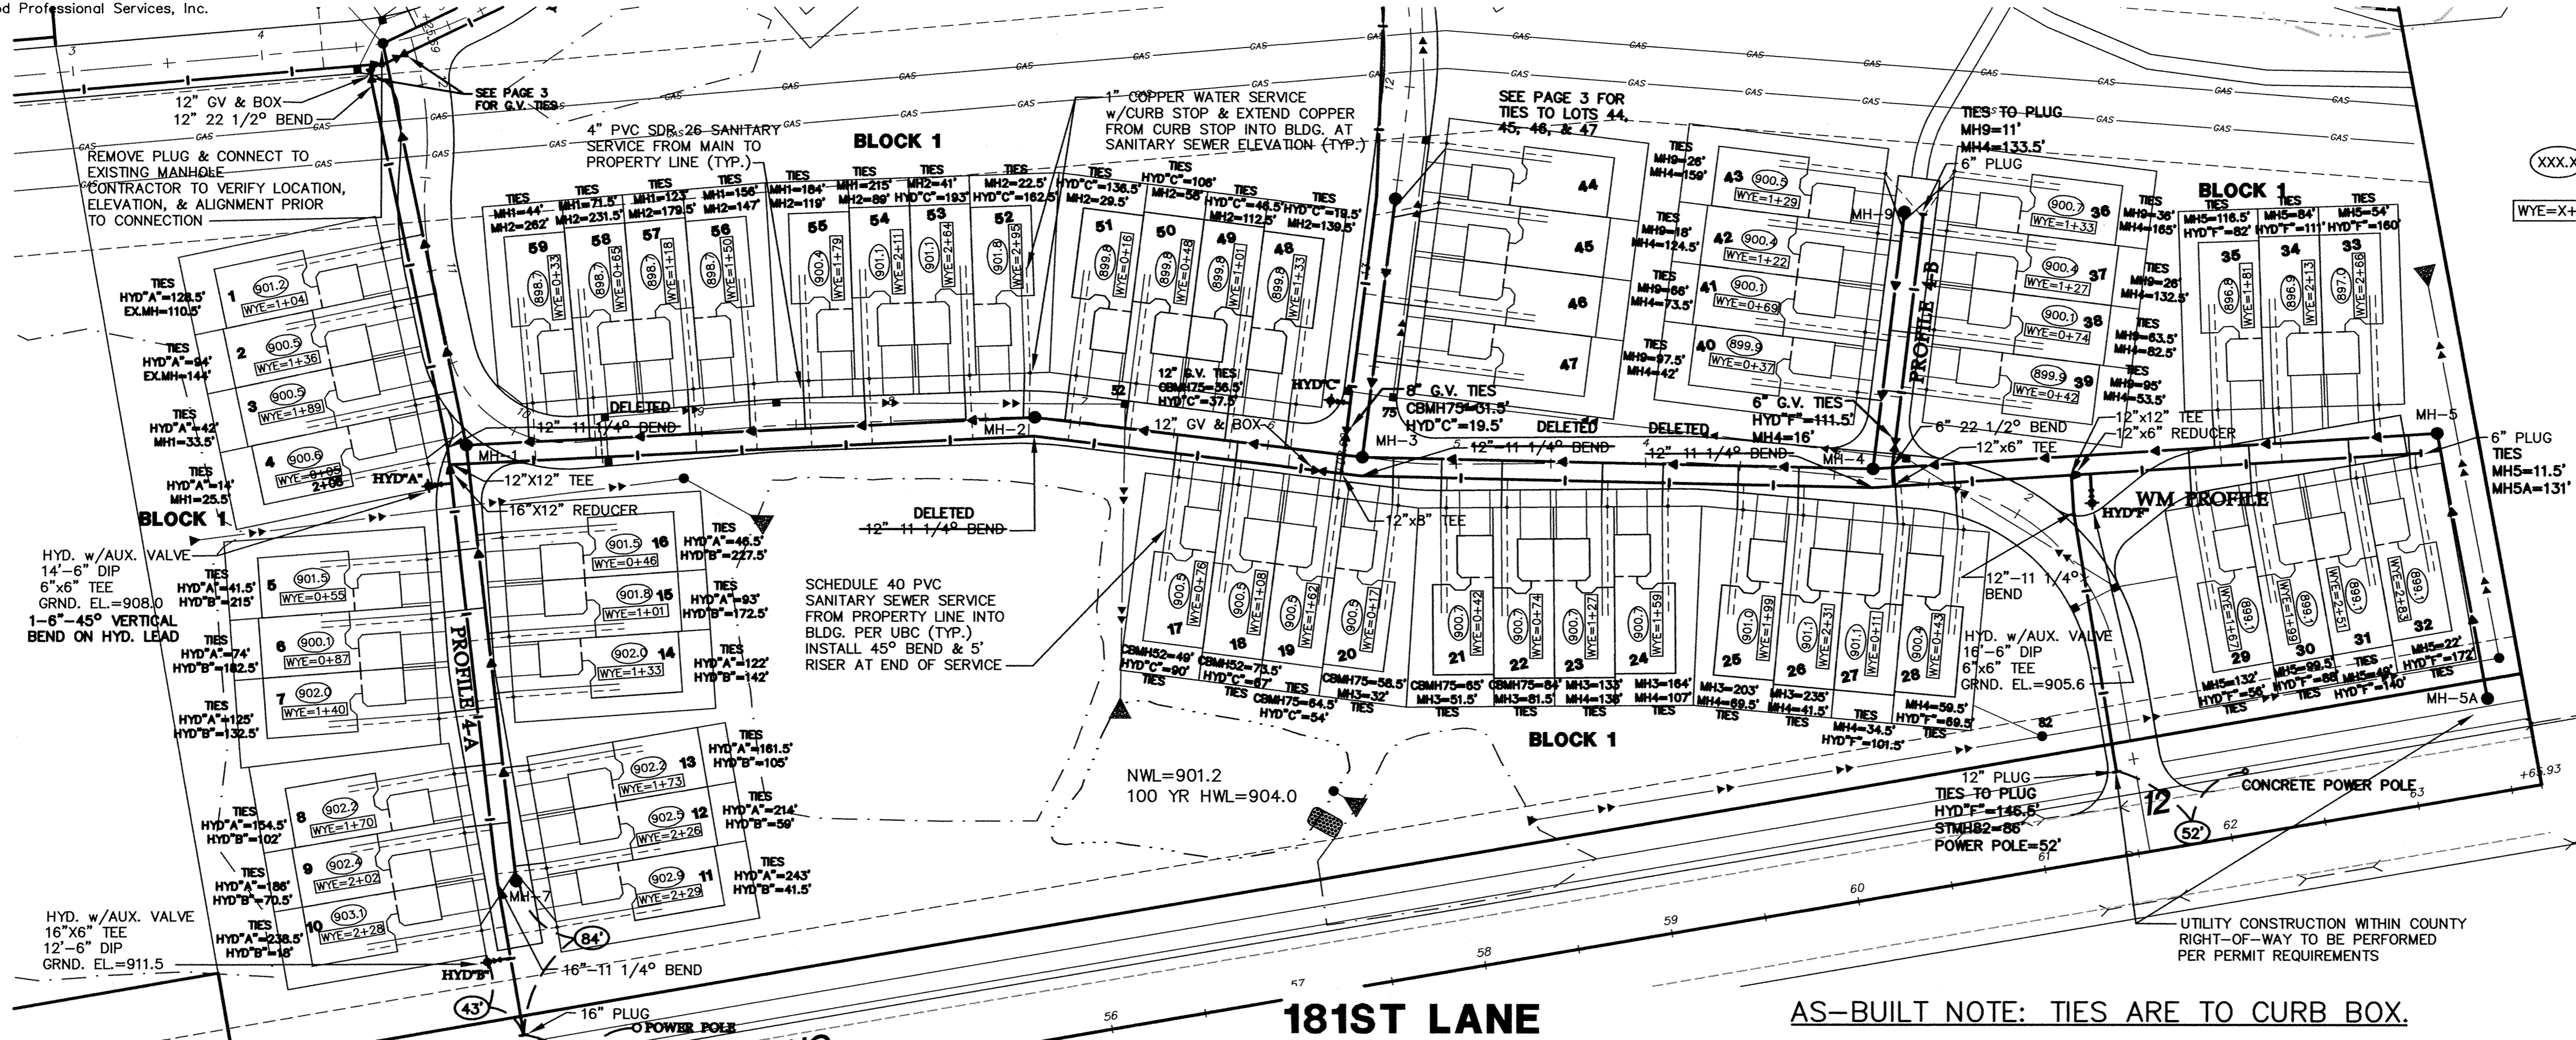

AS-BUILT NOTE: TIES ARE TO CURB BOX.

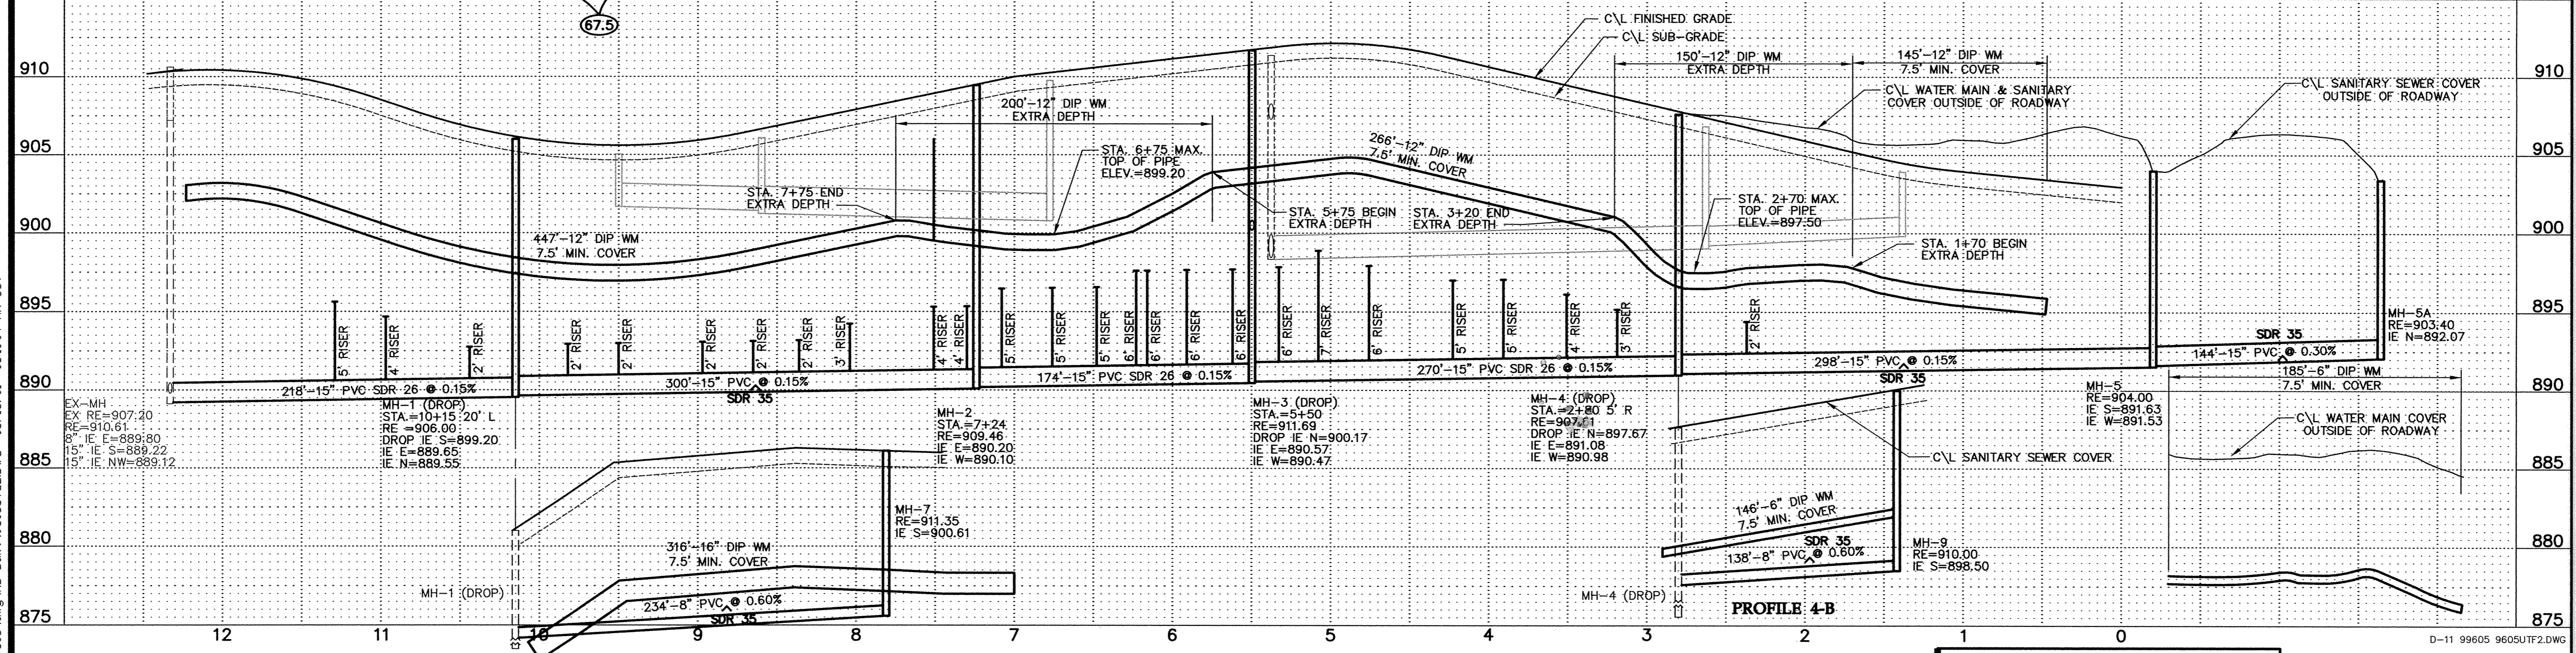

P:\99605\dwg\As-Built\9605UTB2.DWG 03/16/01 08:10:04 AM CST

DRAWING NUMBER
4

DRAWING NUMBER
4

DRAWING NUMBER
4

DRAWING NUMBER
4