

Construction Plans

for

Sanitary Sewer, Water Main, Storm Sewer and Streets

for

Trott Brook Farms 6th Addition Elk River, Minnesota

Prepared for:


D. R. Horton, Inc. - Minnesota
3459 Washington Drive, Suite 204
Eagan, Minnesota 55122
Contact: Don Patton
Phone: 651-454-4663
Fax: 651-454-0460

Prepared by:

Westwood Professional Services, Inc.
 7599 Anagram Drive
 Eden Prairie, MN 55344
 Phone: 952/937-5150 Fax: 952/937-5822

Project number: 99403
 Contact: Fran Hagen, II

Vicinity Map

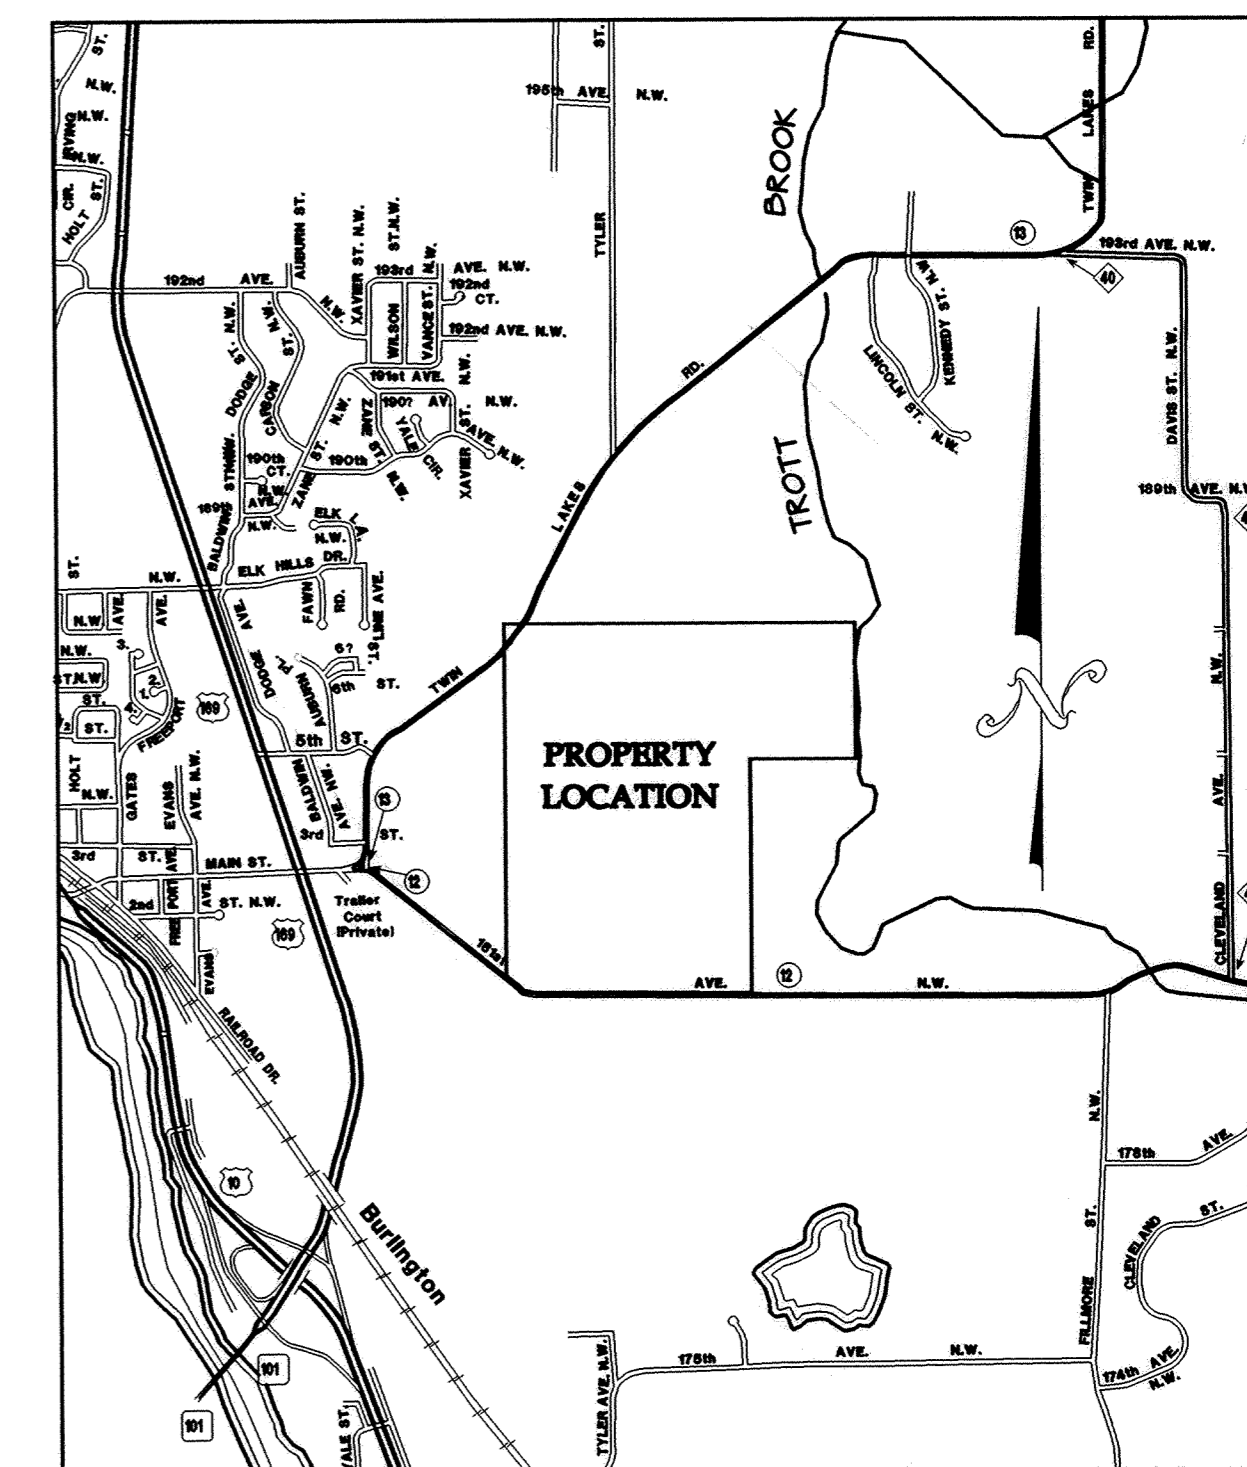

(Not to Scale)

RECORD TESTING

08/13/01 WM HYDROSTATIC - PASSED
 08/14/01 CONDUCTIVITY - PASSED
 08/16/01 BUG-TEST WM - PASSED
 08/1,3,6/01 PRESSURE TEST SAN. ALL LINES - PASSED
 12-12-01 MANDREL TEST - PASSED

NOTE:

HAVE RECEIVED HYD. WRENCHES/HYD. FLAGS, TROTT BROOK 5th & 6th.

NO.	DATE	REVISION	SHEETS
1	04/02/01	PER CITY REVIEW	ALL
2	05/03/01	PER CITY REVIEW	ALL
3	06/4/01	PER CITY REVIEW	ALL
4	06/14/01	CITY WATER MAIN REVISION	1,3,5,7
5	06/25/01	SANITARY SEWER REVISION	1,3,5
6	05/29/03	RECORD DRAWINGS	ALL

CONTRACTOR: RYAN CONTRACTING CO.

RECORD DRAWING
 CONFORMING TO CONSTRUCTION RECORDS.
 BY AL SPILLES DATE 05/29/03
 WESTWOOD PROFESSIONAL SERVICES, INC.

INDEX	
SHEET NO.	DESCRIPTION
1	COVER
2	OVERALL PLAN
3	SANITARY SEWER & WATER MAIN - TROTT BROOK PARKWAY
4	SANITARY SEWER & WATER MAIN - 184TH AVENUE NORTH
5	SANITARY SEWER & WATER MAIN - SMITH COURT & OLSON STREET
6	SANITARY SEWER & WATER MAIN - POLK CIRCLE
7	SANITARY SEWER & WATER MAIN - 184TH COURT
8	STORM SEWER & STREET CONST. - TROTT BROOK PARKWAY
9	STORM SEWER & STREET CONST. - 184TH AVENUE NORTH
10	STORM SEWER & STREET CONST. - SMITH COURT
11	STORM SEWER & STREET CONST. - POLK CIRCLE
12	STORM SEWER & STREET CONST. - 184TH COURT
13	STORM SEWER & STREET CONST. - OLSON STREET
14	SANITARY SEWER DETAILS
15	WATERMAIN DETAILS
16	STORM SEWER DETAILS
17	STREET CONSTRUCTION DETAILS
18	MISCELLANEOUS DETAILS

Construction Plans

for

Sanitary Sewer, Water Main, Storm Sewer and Streets

for

Trott Brook Farms 6th Addition
 Elk River, Minnesota

Date: 1/10/01 Sheet: 1 of 18

DRAWING NUMBER TROTTE 02 1