



GENERAL NOTES:

- 28.09 * DENOTES GUTTERLINE ELEVATION
AT INTERSECTIONS


CASTING NOTE:

ALL CATCH BASIN CASTINGS IN CURB SHALL BE SUMPED 0.15 FEET AND MANHOLE CASTINGS IN PAVED AREAS SHALL BE SUMPED 0.05 FEET. RIM ELEVATIONS ON PLAN PROFILES REFLECT THE SUMPED ELEVATIONS.

DRAIN TILE SHALL BE SDR 35 6" PVC

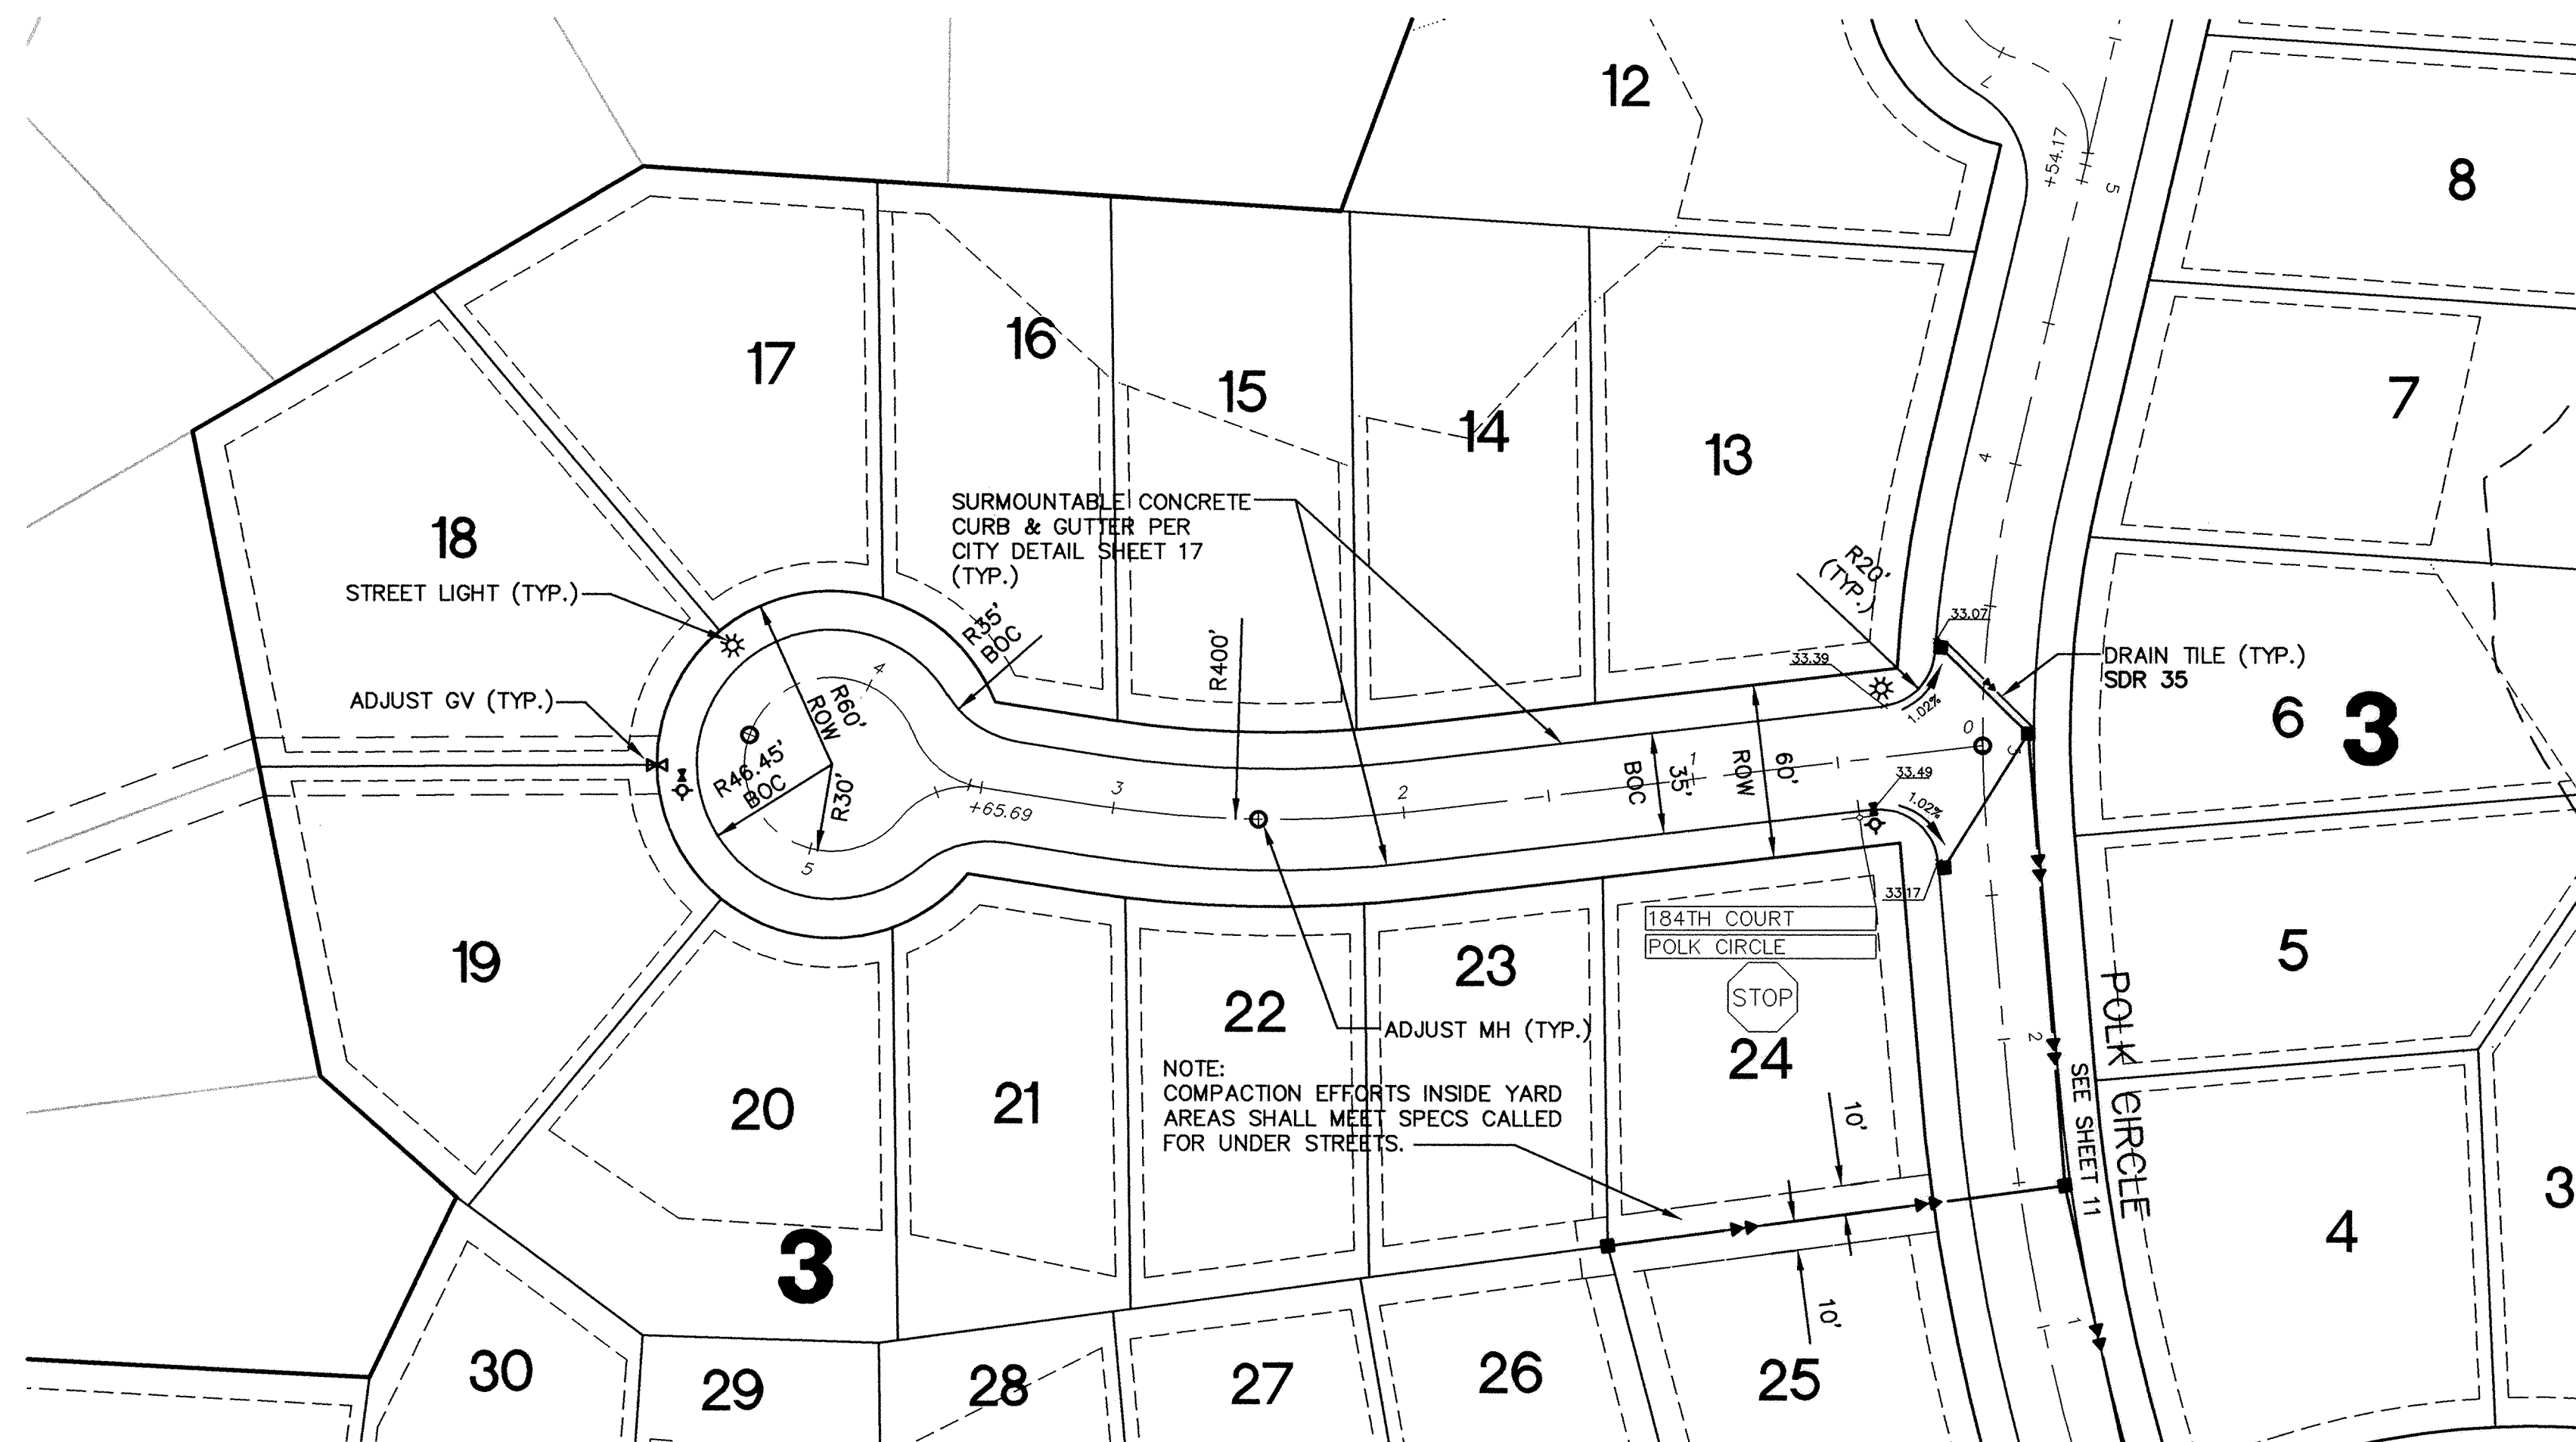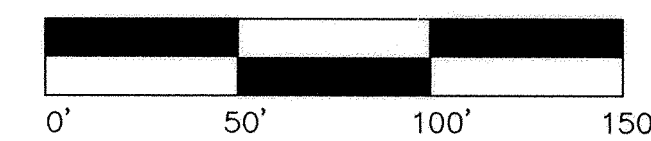

184th Court

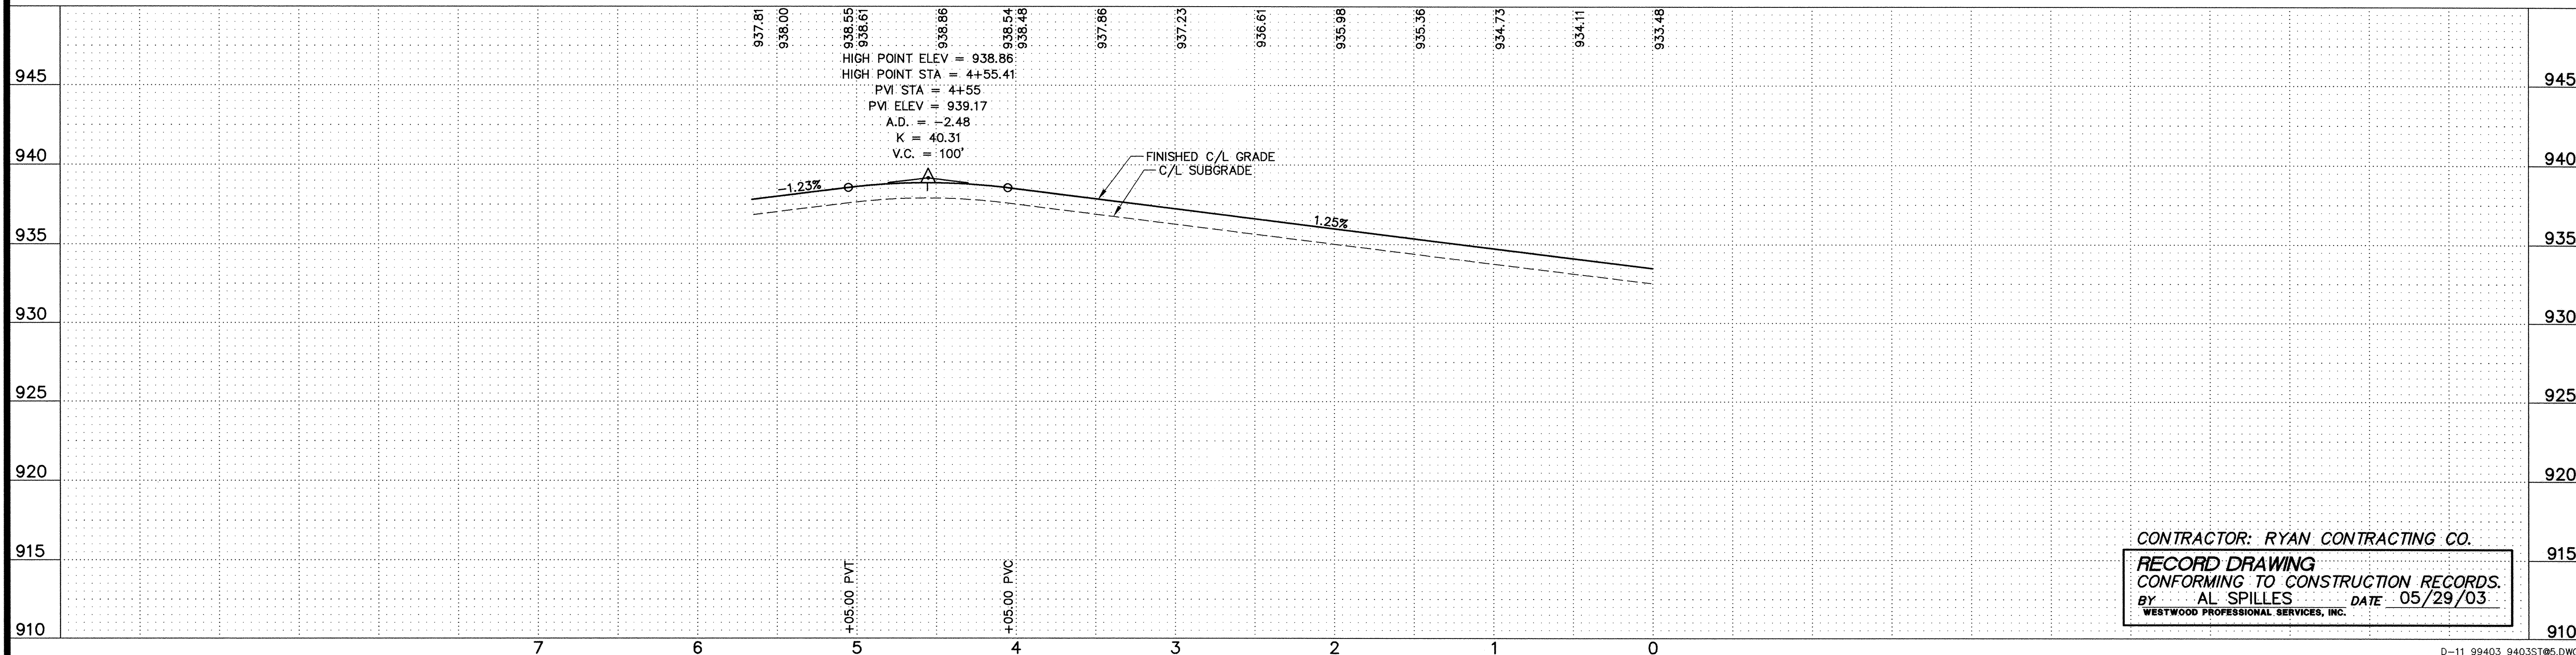

CONTRACTOR: RYAN CONTRACTING CO.

RECORD DRAWING	
CONFORMING TO CONSTRUCTION RECORDS.	
BY AL SPILLES	DATE 05/29/03
WESTWOOD PROFESSIONAL SERVICES, INC.	

D-11 99403 9403ST@5.DWG
LATEST REVISION DATE: 6/4/01
 Date: **1/10/01** Sheet: **12 OF 18**

Storm Sewer and Street Construction Plans

Trott Brook Farms 6th Addition

Elk River, Minnesota

Prepared for:

D.R. Horton, Inc. - Minnesota

3459 Washington Drive, Suite 204
Eagan, Minnesota 55122

Designed: JMM
Checked: FDH, II
Drawn: WH / KMW
Record Drawing by/date: 5/29/03 AS

Revisions:	
4/2/01	PER CITY REVIEW
5/3/01	PER CITY REVIEW
6/4/01	PER CITY REVIEW
05/29/03 RECORD DRAWINGS (AS/GKB)	

I hereby certify that this plan was prepared by me or under my direct supervision and that I am a duly licensed PROFESSIONAL ENGINEER under the laws of the State of Minnesota.

Francis D. Hagen, II

Date: 05/29/03 License No. 17716



Westwood Professional Services, Inc.
 7599 Anagram Drive
 Eden Prairie, MN 55344
 Phone: 952/937-5150 Fax: 952/937-5822