

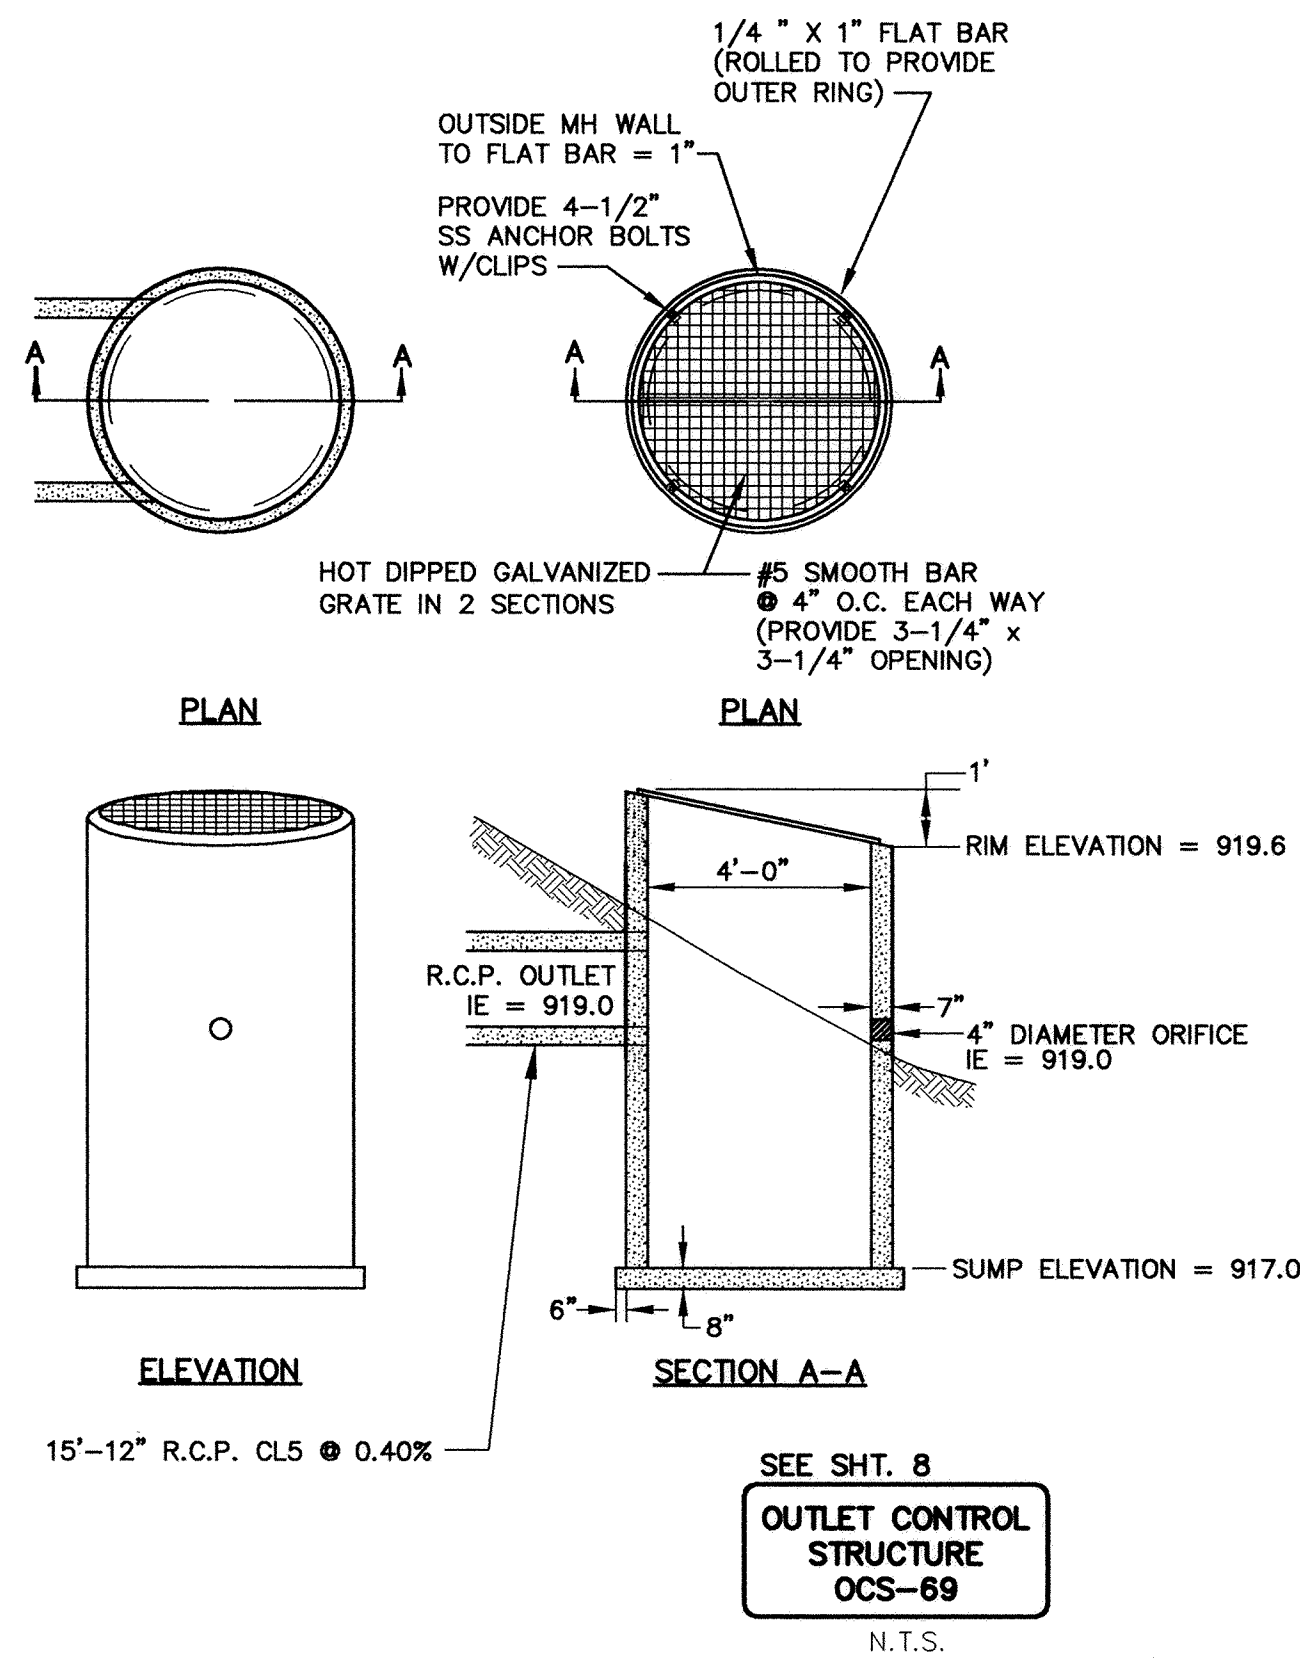


DRAWING NUMBER

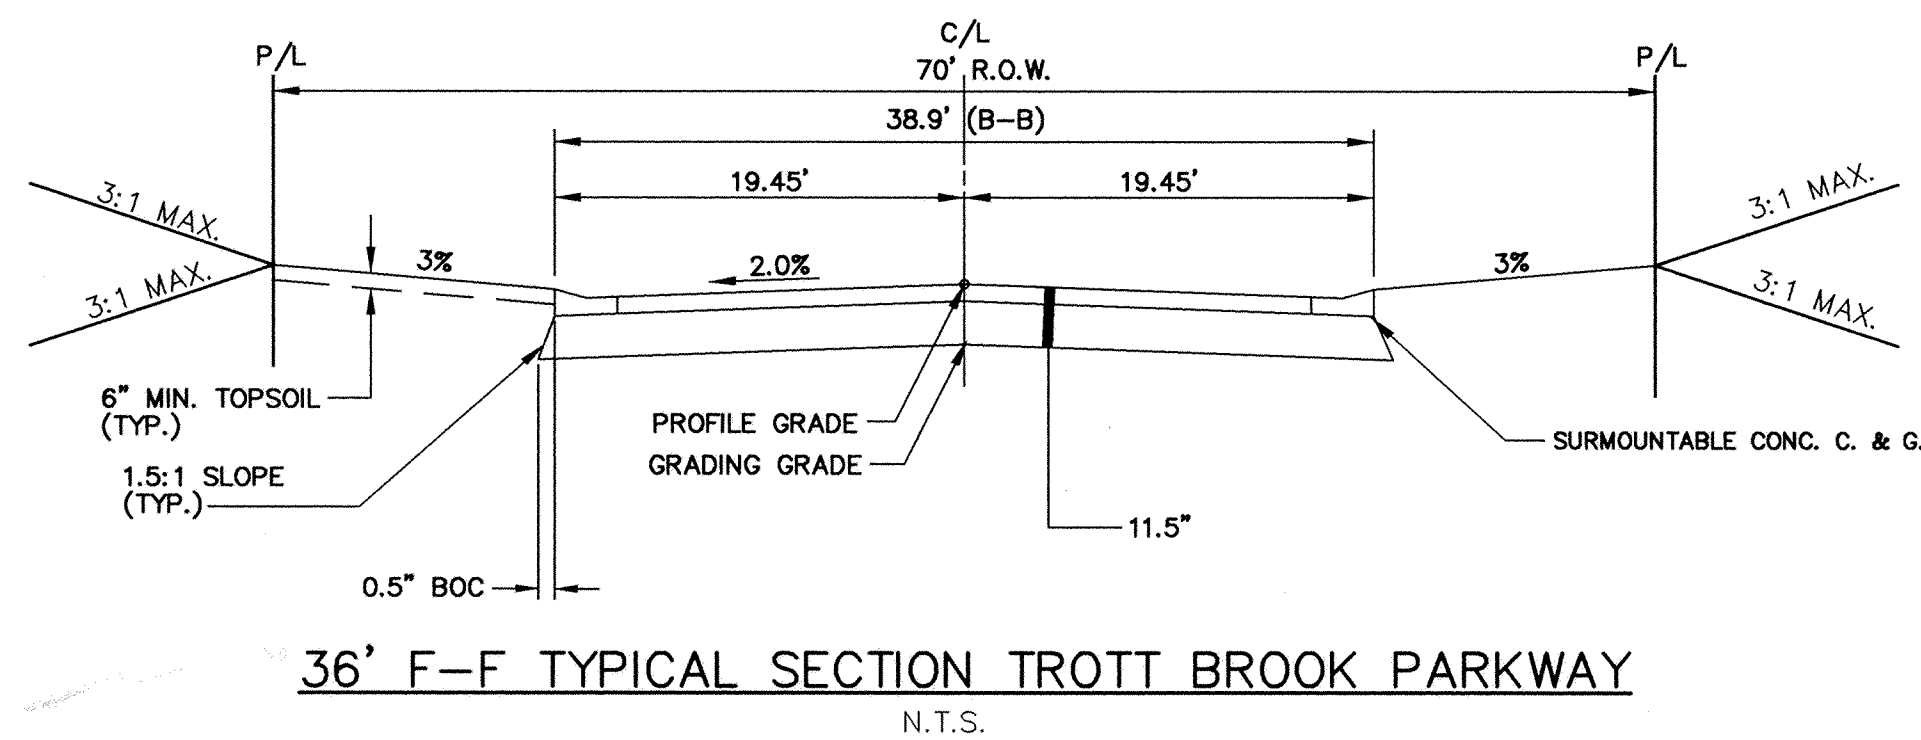

STORM SEWER CASTING SCHEDULE		
STRUCTURE NO.	STRUCTURE TYPE	CASTING TYPE
50	12" FES	
51	48" CBMH	R-3067-V
52	2'x3' CB	R-3067-V
53	2'x3' CB	R-3508-A2
54	48" CBMH	R-3067-V
55	48" CBMH	R-3067-V
56	2'x3' CB	R-3067-V
57	24" FES	
58	48" CBMH	R-3067-V
59	48" CBMH	R-3067-V
60	48" CBMH	R-3508-A2
61	48" CBMH	R-3067-V
63	48" CBMH	R-3508-A2
64	27" CB	R-4342
65	48" CBMH	R-3508-A2
66	2'x3' CB	R-3067-V
67	2'x3' CB	R-3067-V
68	12" FES	
69	48" OCS	SEE DETAIL
70	21" FES	
71	48" STMH	R-1733
72	48" CBMH	R-3508-A2
73	2'x3' CB	R-3067-V
74	48" CBMH	R-3067-V
75	12" FES	
76	48" CBMH	R-3067-V
78	48" CBMH	R-3067-V
79	48" CBMH	R-3067-V
80	48" CBMH	R-3067-V
81	2'x3' CB	R-3067-V
82	12" FES	
83	27" CBMH	R-4342
84	15" FES	
85	48" CBMH	R-3067-V
86	2'x3' CB	R-3508-A2
90	18" FES	
91	48" OCS	SEE DETAIL

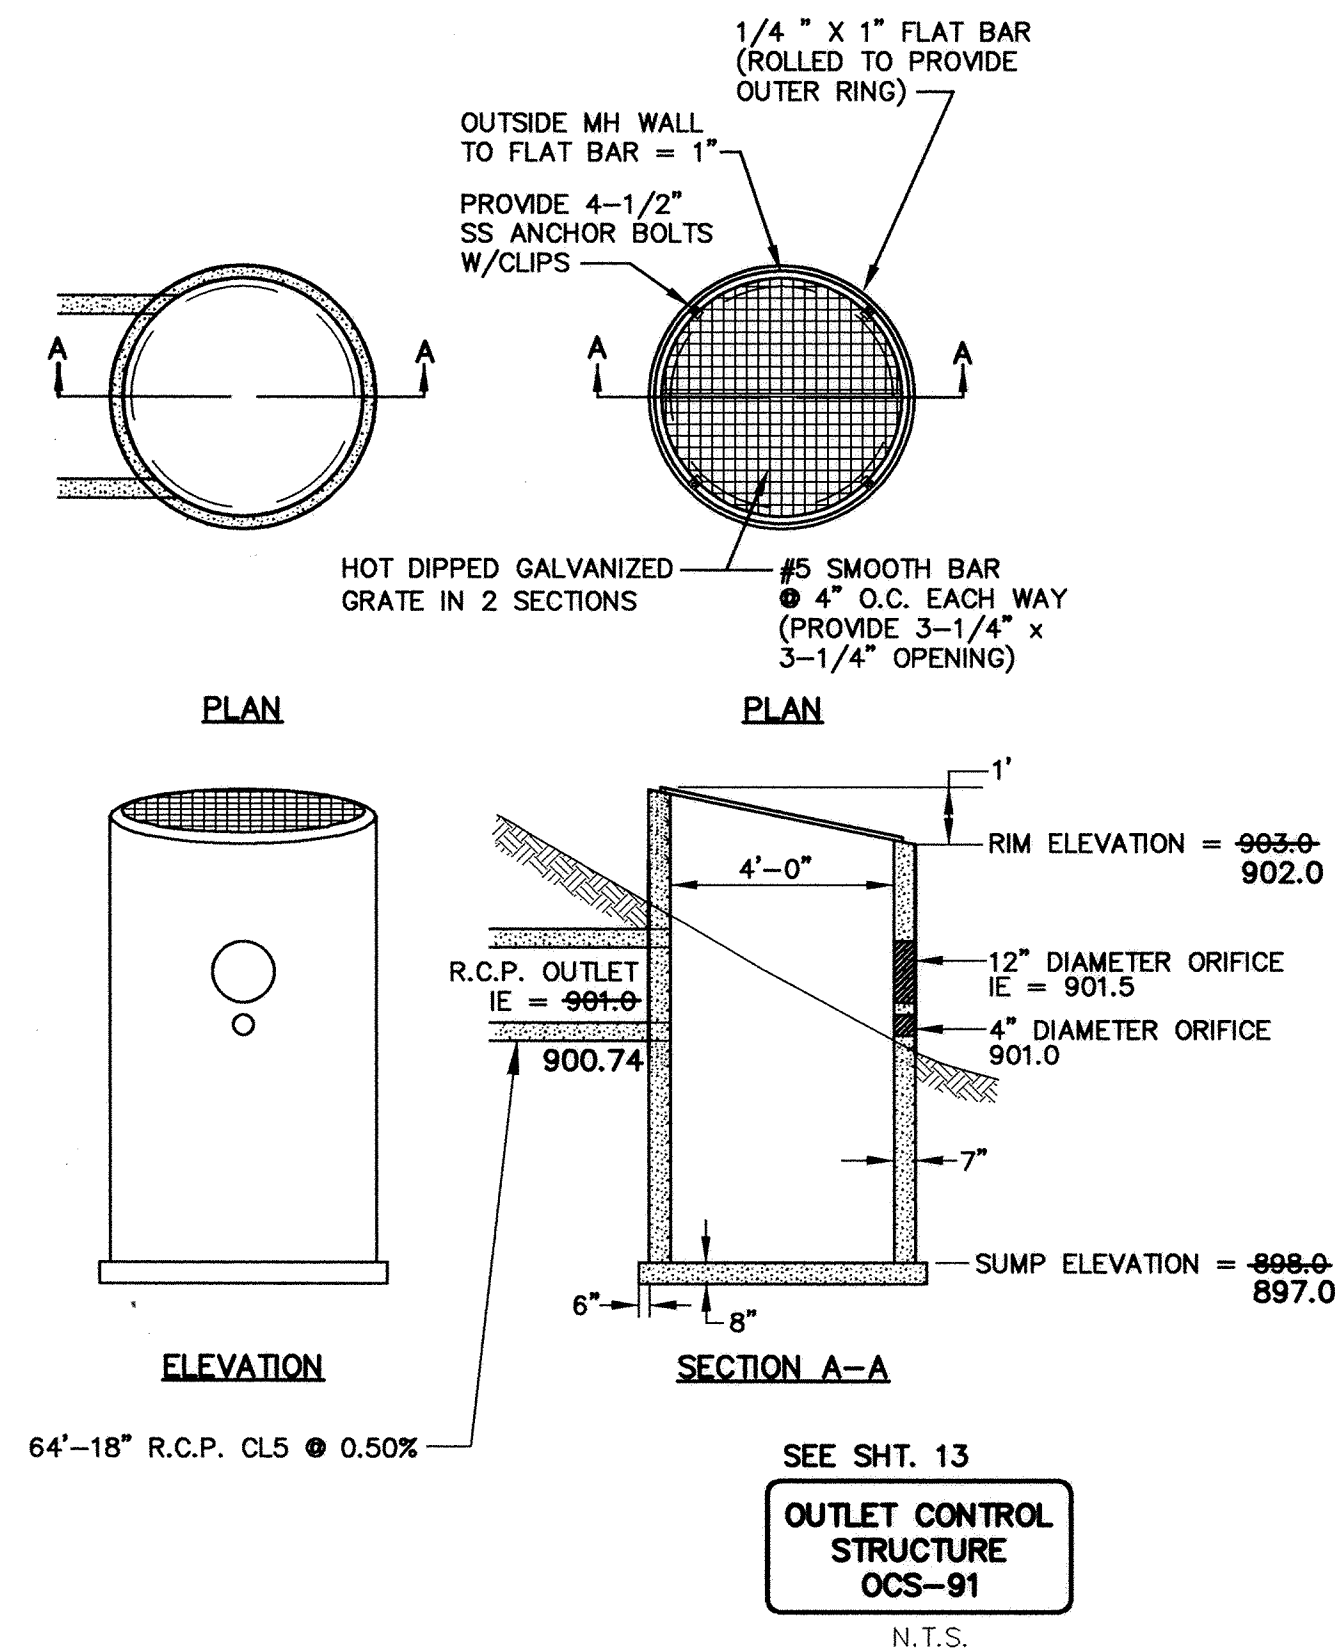

RECORD DRAWING
CONFORMING TO CONSTRUCTION RECORDS.
 BY AL SPILLES DATE 05/29/03
WESTWOOD PROFESSIONAL SERVICES, INC.

Date: 1/10/01 Sheet: 18 OF 18

Miscellaneous Details

Elk River, Minnesota

DRAWING NUMBER
TROT6.02
18