

Construction Plans

for

Sanitary Sewer, Water Main, Storm Sewer and Streets

for

Trott Brook Farms Seventh Addition Elk River, Minnesota

Prepared for:

D.R. Horton. Inc. - Minnesota
20860 Kenbridge Court
Lakeville, Minnesota 55044
Contact: Don Patton
Phone: (952) 985-7823
Fax: (952) 985-7800


Prepared by:

Westwood Professional Services, Inc.
7599 Anagram Drive
Eden Prairie, MN 55344
Phone: 952/937-5150 Fax: 952/937-5822

Project Number: 20011059
Contact: Fran Hagen, II

INDEX	
SHEET NO.	DESCRIPTION
1	COVER
2	OVERALL PLAN
3	SANITARY SEWER & WATER MAIN – 183RD AVENUE
4 & 5	SANITARY SEWER & WATER MAIN – OLSON STREET
6	STORM SEWER & STREET CONSTRUCTION – 183RD AVENUE
7 & 8	STORM SEWER & STREET CONSTRUCTION – OLSON STREET
9	SANITARY SEWER DETAILS
10	WATER MAIN DETAILS
11	STORM SEWER DETAILS
12	STREET DETAILS

Vicinity Map

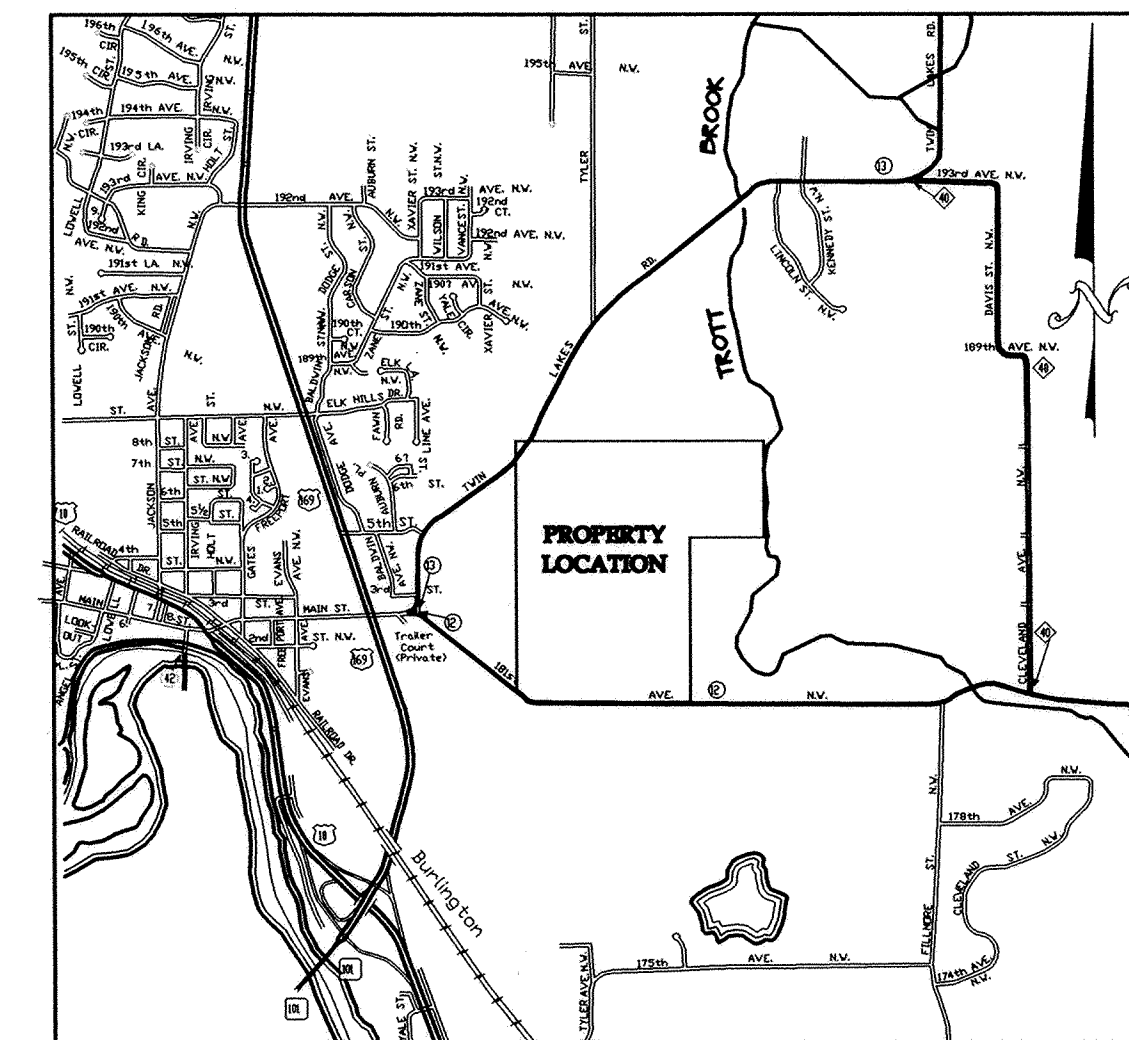

(Not to Scale)

NO.	DATE	REVISION	SHEETS
1	8/23/01	PER CITY REVIEW	ALL
2	10/19/01	POND 4 REVISION	1,2,5,8
3	10/30/01	STORM SEWER (CBMH-61 TO FES-60)	1,8
4	05/04/05	RECORD DRAWINGS	ALL

Construction Plans

for

**Sanitary Sewer, Water Main, Storm Sewer
and Streets**

for

Trott Brook Farms Seventh Addition
Elk River, Minnesota

Date: 07/24/01 Sheet: 1 of 12

CONTRACTOR: RYAN CONTRACTING CO.
RECORD DRAWING
CONFORMING TO CONSTRUCTION RECORDS.
BY AL SPILLES DATE 05/04/05
WESTWOOD PROFESSIONAL SERVICES