


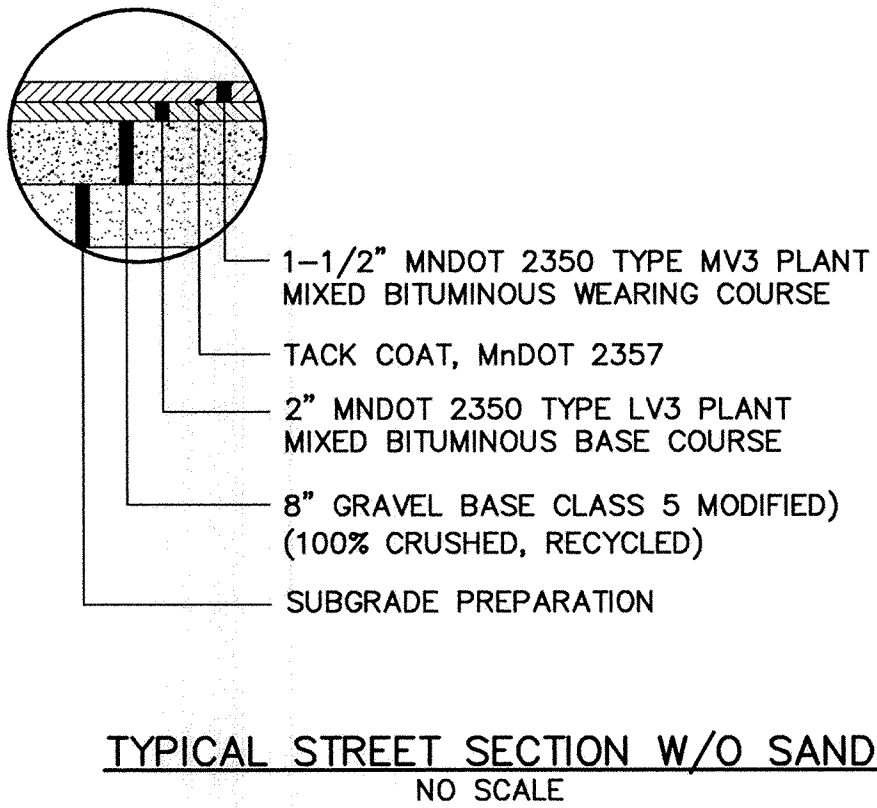


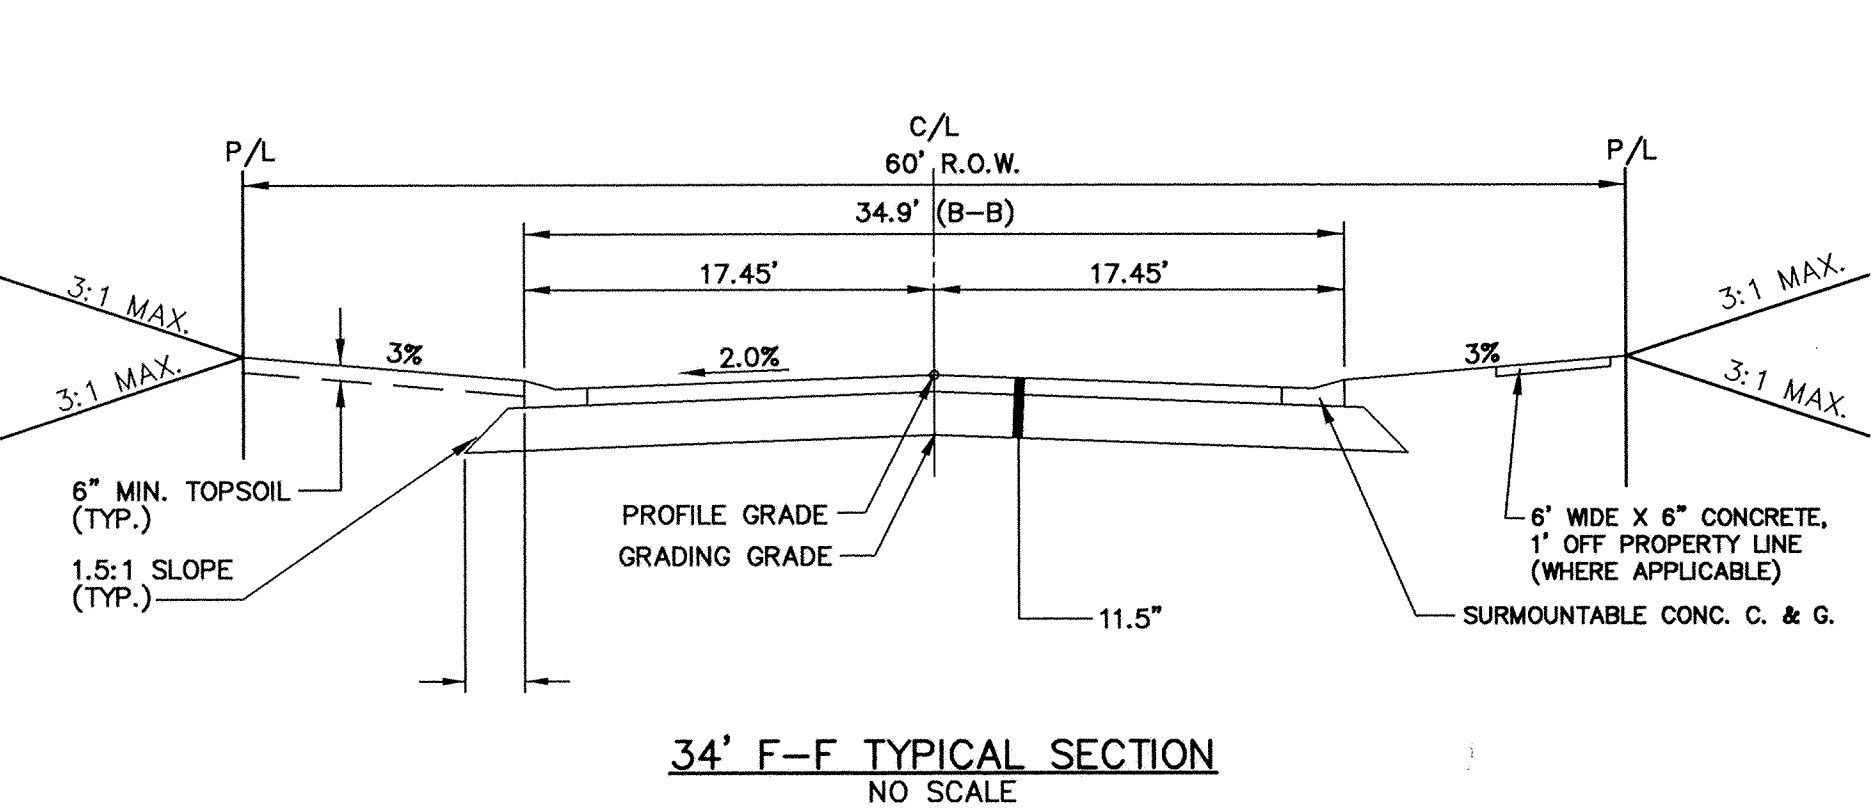

STORM SEWER CASTING SCHEDULE		
STRUCTURE NO.	STRUCTURE TYPE	CASTING TYPE
52	15" FES	
53	48" CBMH	R-3067-V
54	48" CBMH	R-3508-A2
55	2'x3' CB	R-3508-A2
60	21" FES	
61	48" CBMH	R-3067-V
62	48" CBMH	R-3508-A2
63	48" CBMH	R-3067-V
65	12" FES	
66	48" OCS	SEE DETAIL

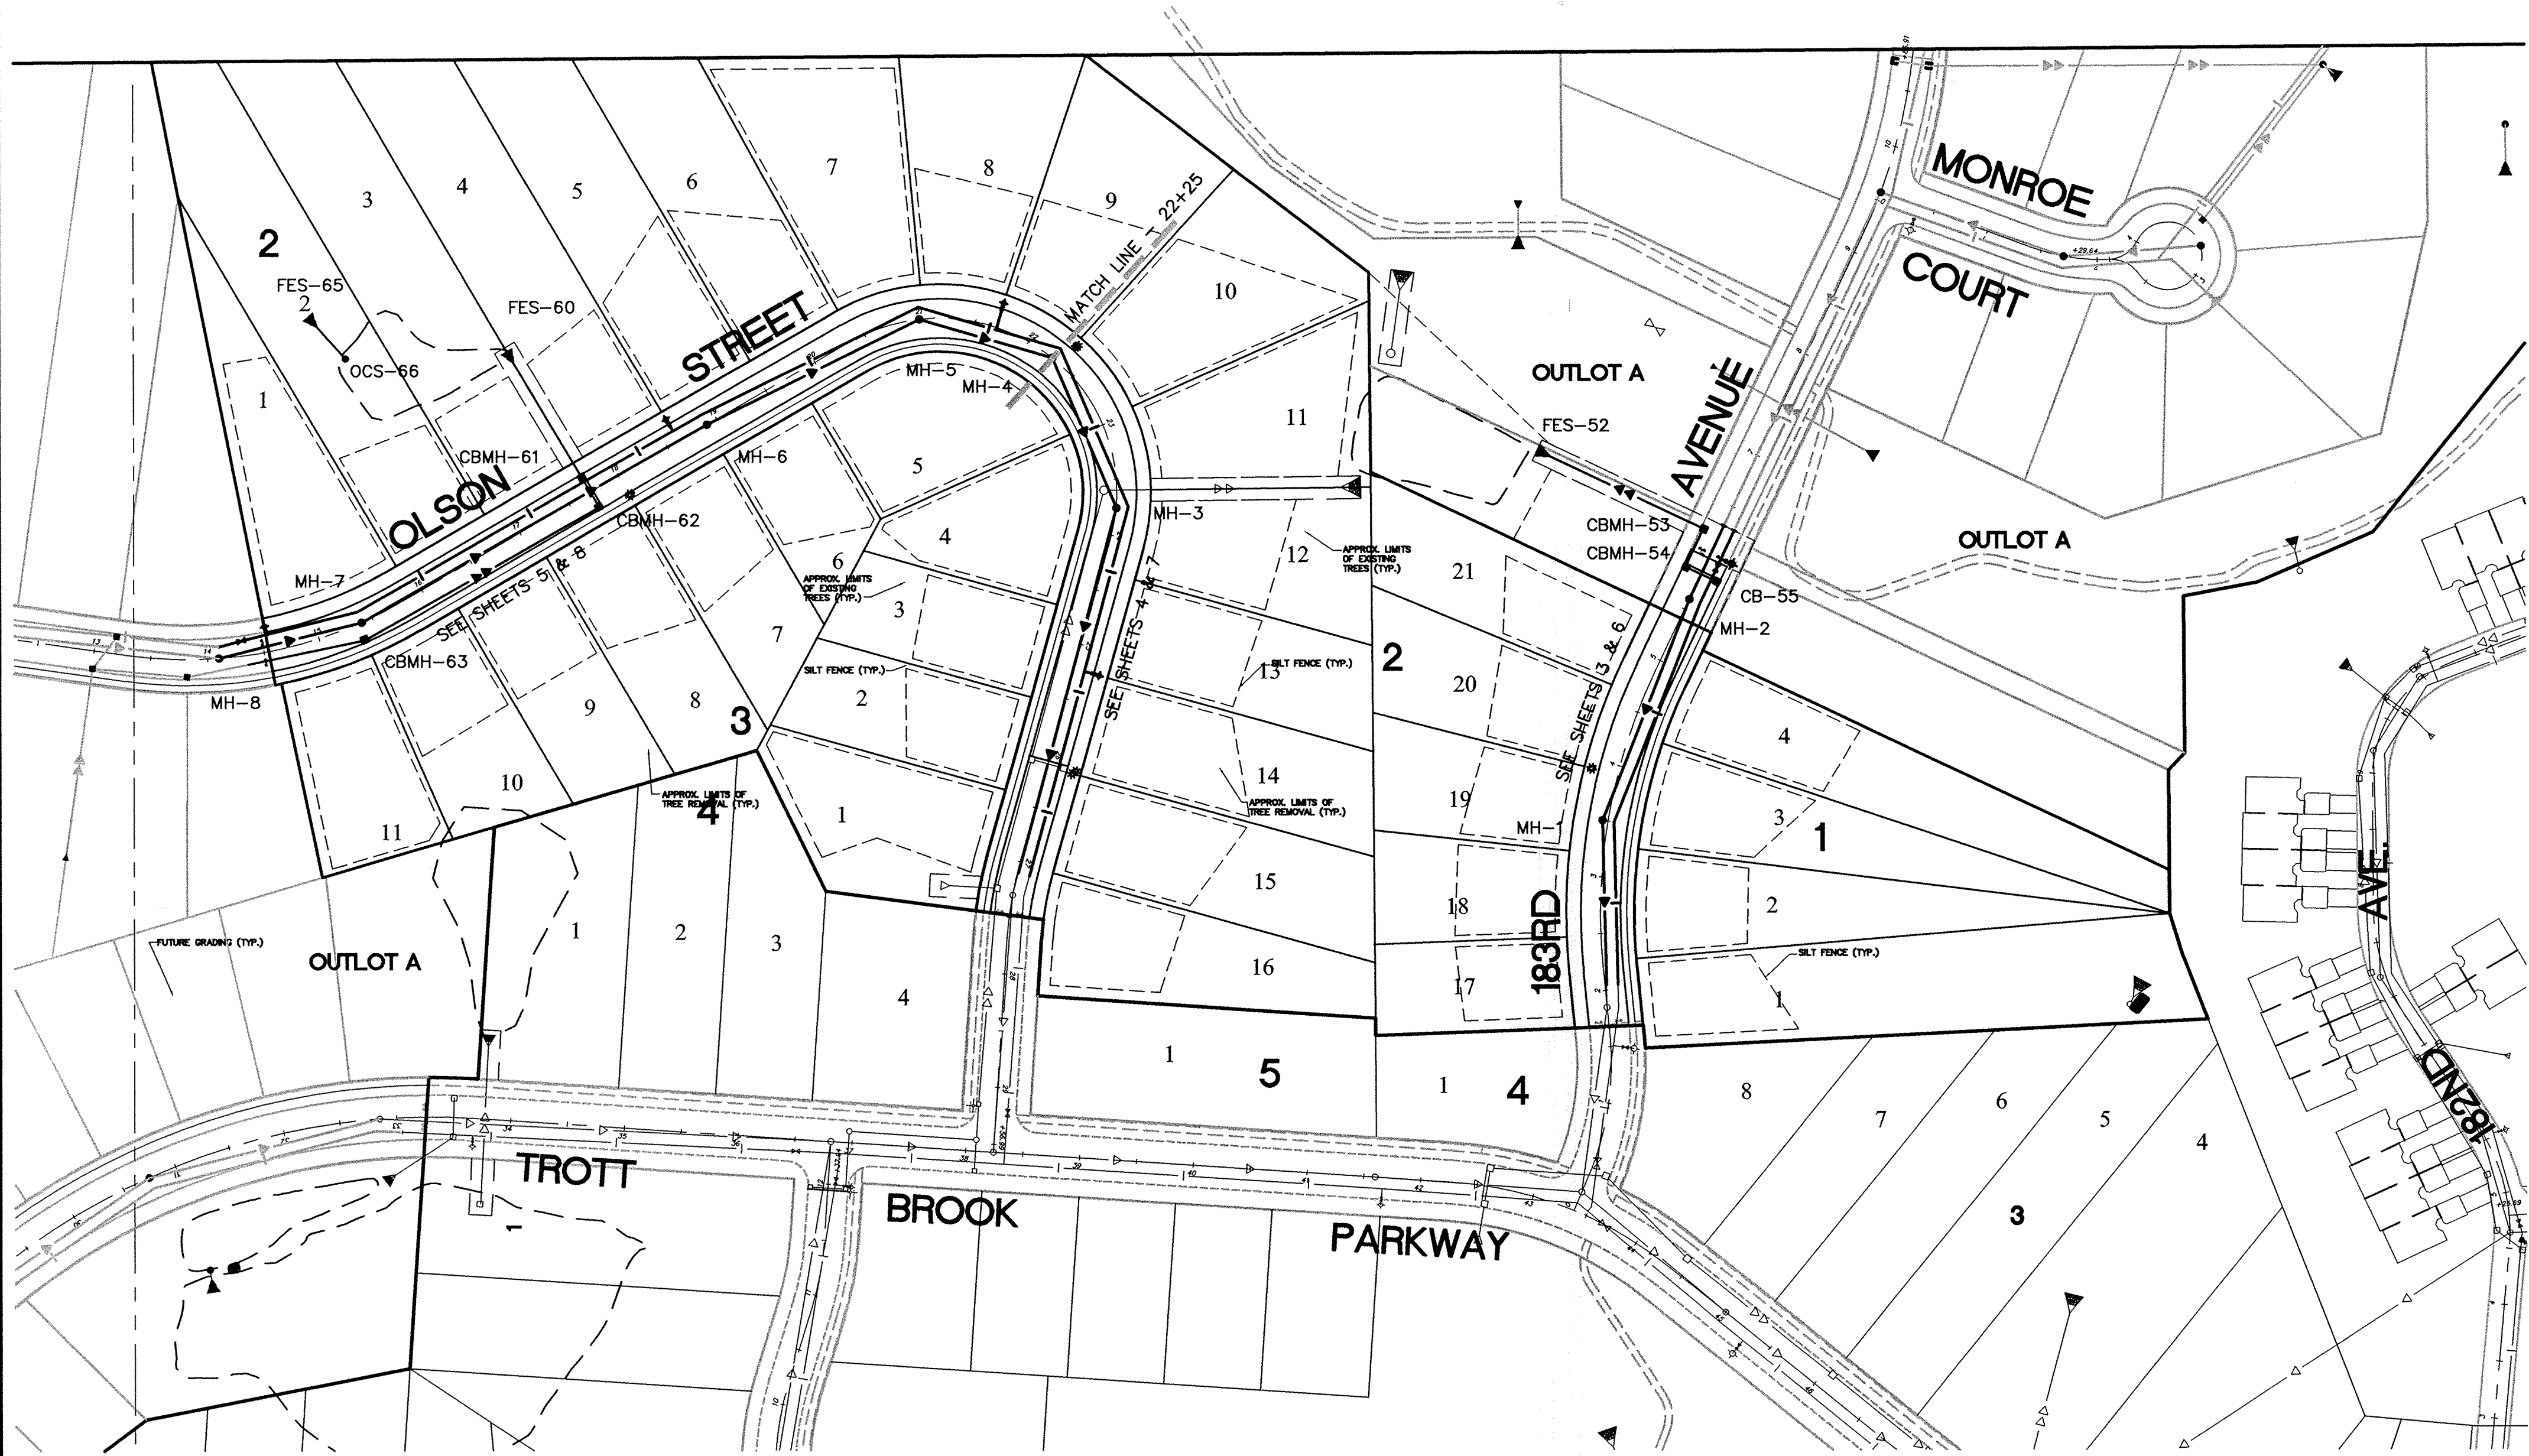

CONTRACTOR: RYAN CONTRACTING CO.
RECORD DRAWING
CONFORMING TO CONSTRUCTION RECORDS.
BY AL SPILLES DATE 05/04/05
WESTWOOD PROFESSIONAL SERVICES

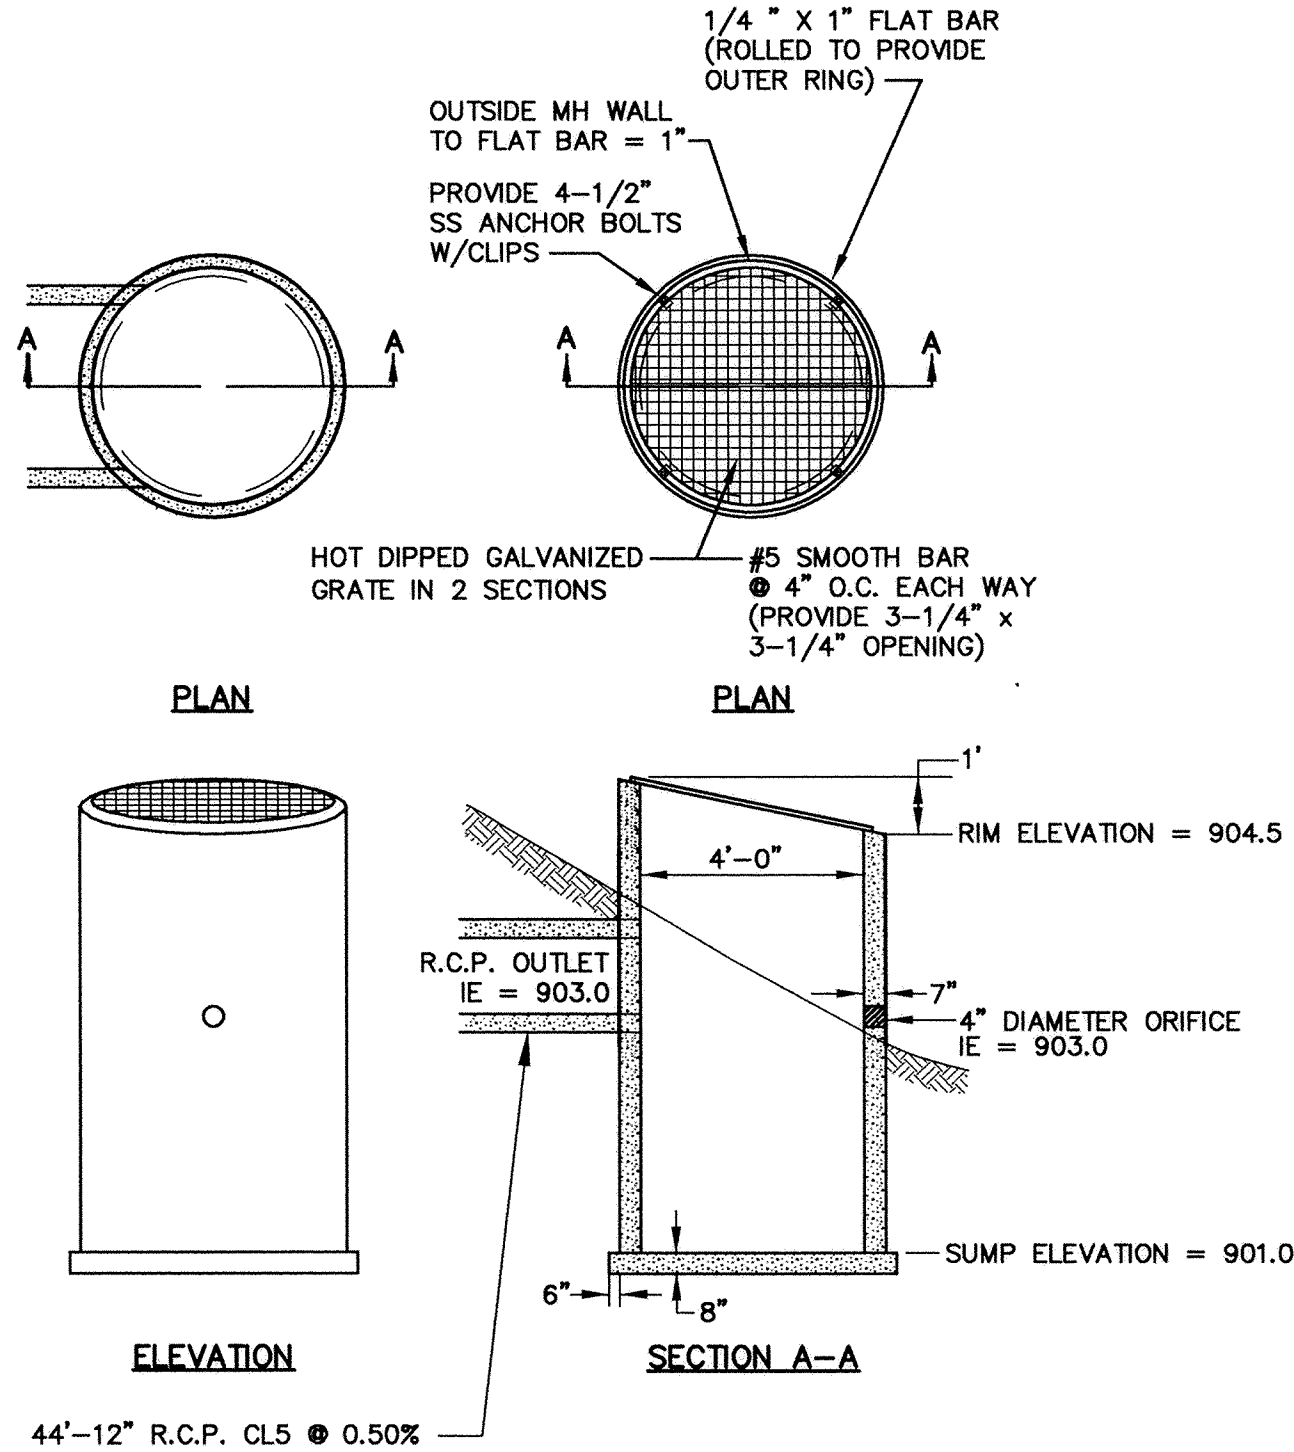