

GENERAL NOTES:

XXX.X

DENOTES SANITARY SEWER SERVICE
INVERT @ ROW LINE. ALL SERVICES
SHALL BE EXTENDED 9' INTO PROPERTY
WHERE SIDEWALK IS BEING CONSTRUCTED.

WYE=X+XX




DENOTES SANITARY SEWER SERVICE WYE
LOCATED ON MAINLINE FROM
DOWN STREAM M.H.

FLAG HYDRANTS.

EXTEND RODS ON DEEP VALVES.

ALL DROP MANHOLES TO BE CONSTRUCTED
USING OUTSIDE DROPS.

SANITARY SEWER & WATER SERVICES TO BE
EXTENDED 10' PAST R.O.W. ON ALL LOTS

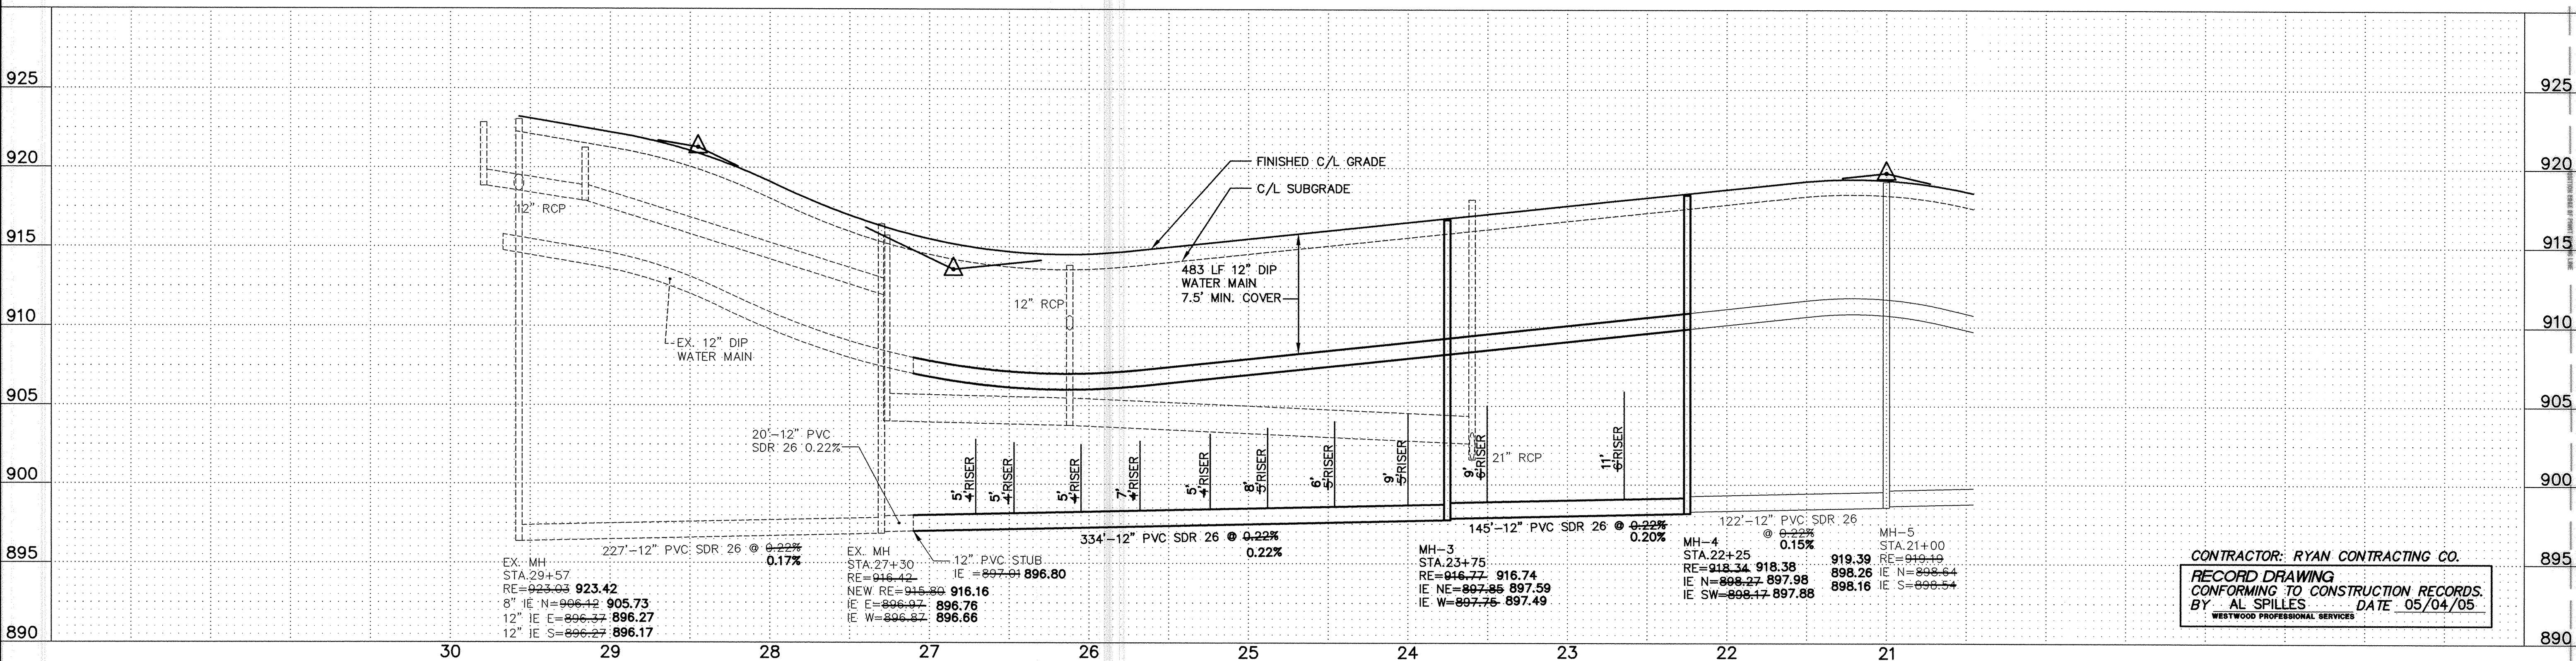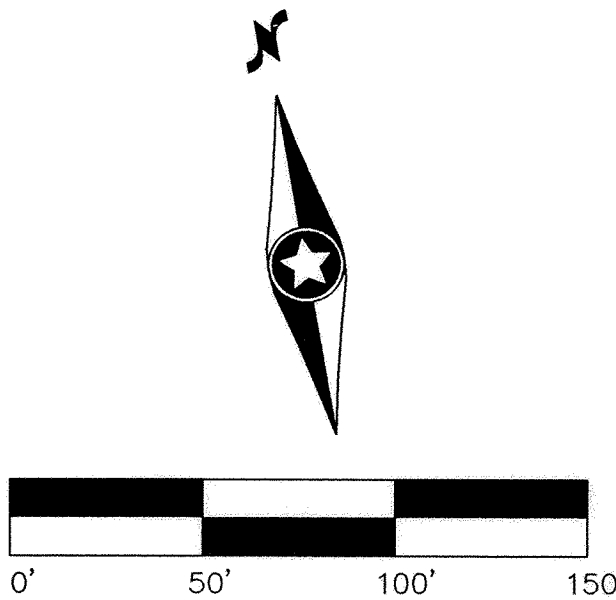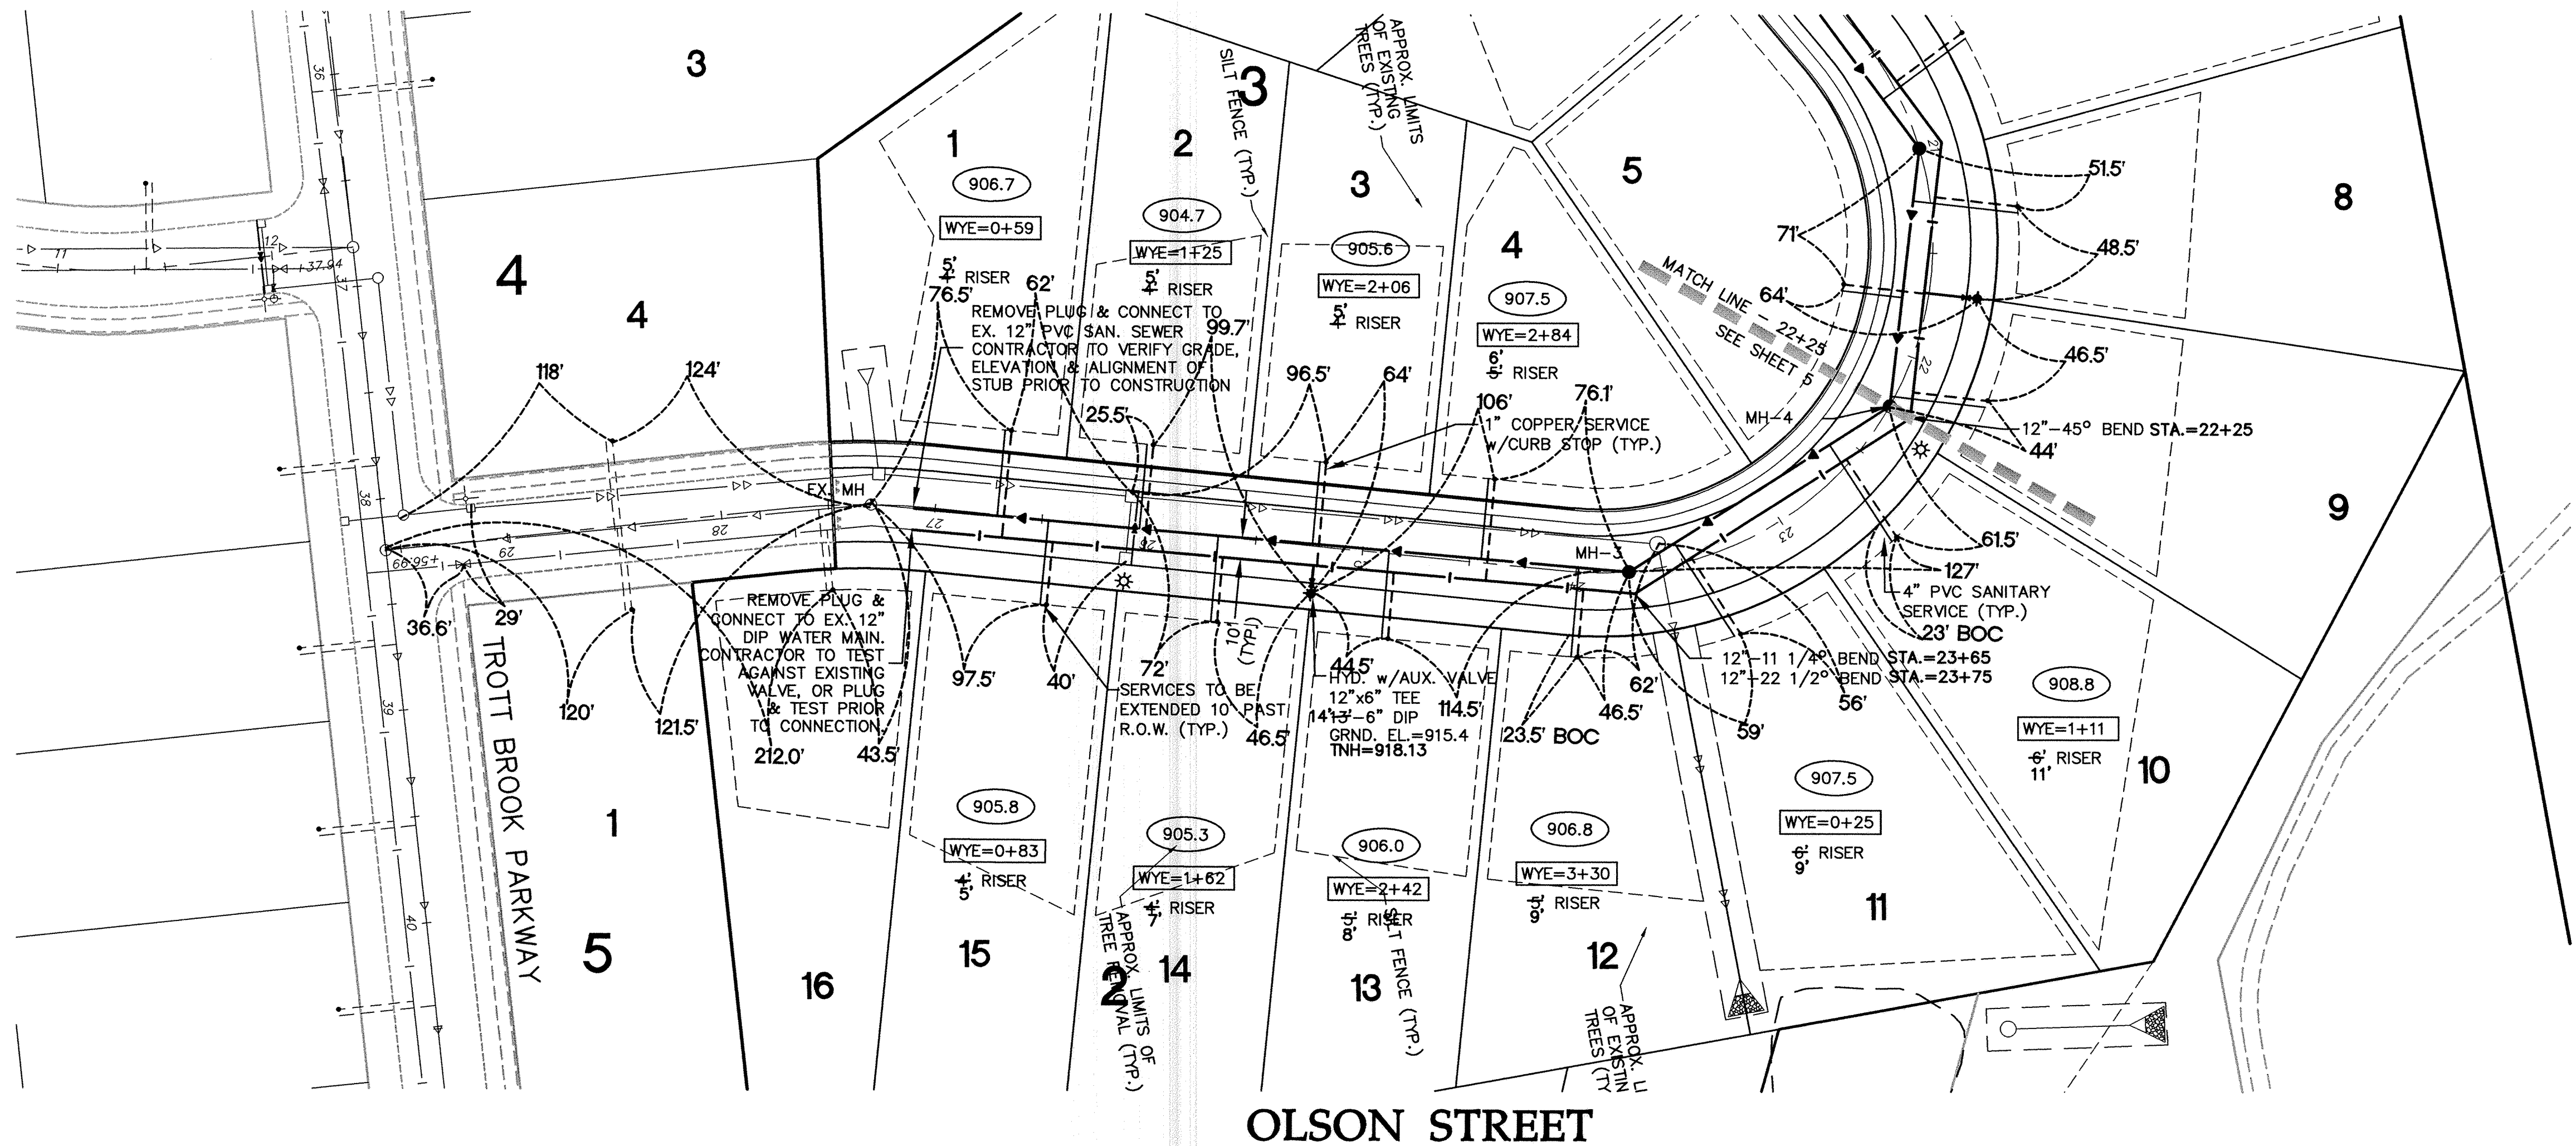

CONTRACTOR: RYAN CONTRACTING CO.
RECORD DRAWING
CONFORMING TO CONSTRUCTION RECORDS.
BY: AL SPILLES DATE: 05/04/05
WESTWOOD PROFESSIONAL SERVICES

LATEST REVISION DATE: 05/04/05
Date: 07/24/01 Sheet: 4 OF 12

**Sanitary Sewer
and Water Main
Construction Plans**
Olson Street (Sta. 22+25 - Sta. 27+56.99)

**Trott Brook Farms
Seventh Addition**
Elk River, Minnesota

D. R. Horton, Inc. - Minnesota
20860 Kenbridge Court
Lakeville, Minnesota 55044

Prepared for:

Designed: JMMc/WH
Checked: PDH
Drawn: WH/RNS
Record Drawing by/date: AS 5/04/05

Revisions:

8/23/01 PER CITY REVIEW
05/04/05 RECORD DRAWING (AS/GKB)

I hereby certify that this plan was prepared by me or under my
direct supervision and that I am a duly licensed PROFESSIONAL
ENGINEER under the laws of the State of Minnesota.
Francis D. Hagen, II
Date: 05/04/05 License No. 17716

Westwood Professional Services, Inc.
7599 Anagram Drive
Eden Prairie, MN 55344
Phone: 952/937-5150 Fax: 952/937-5822