
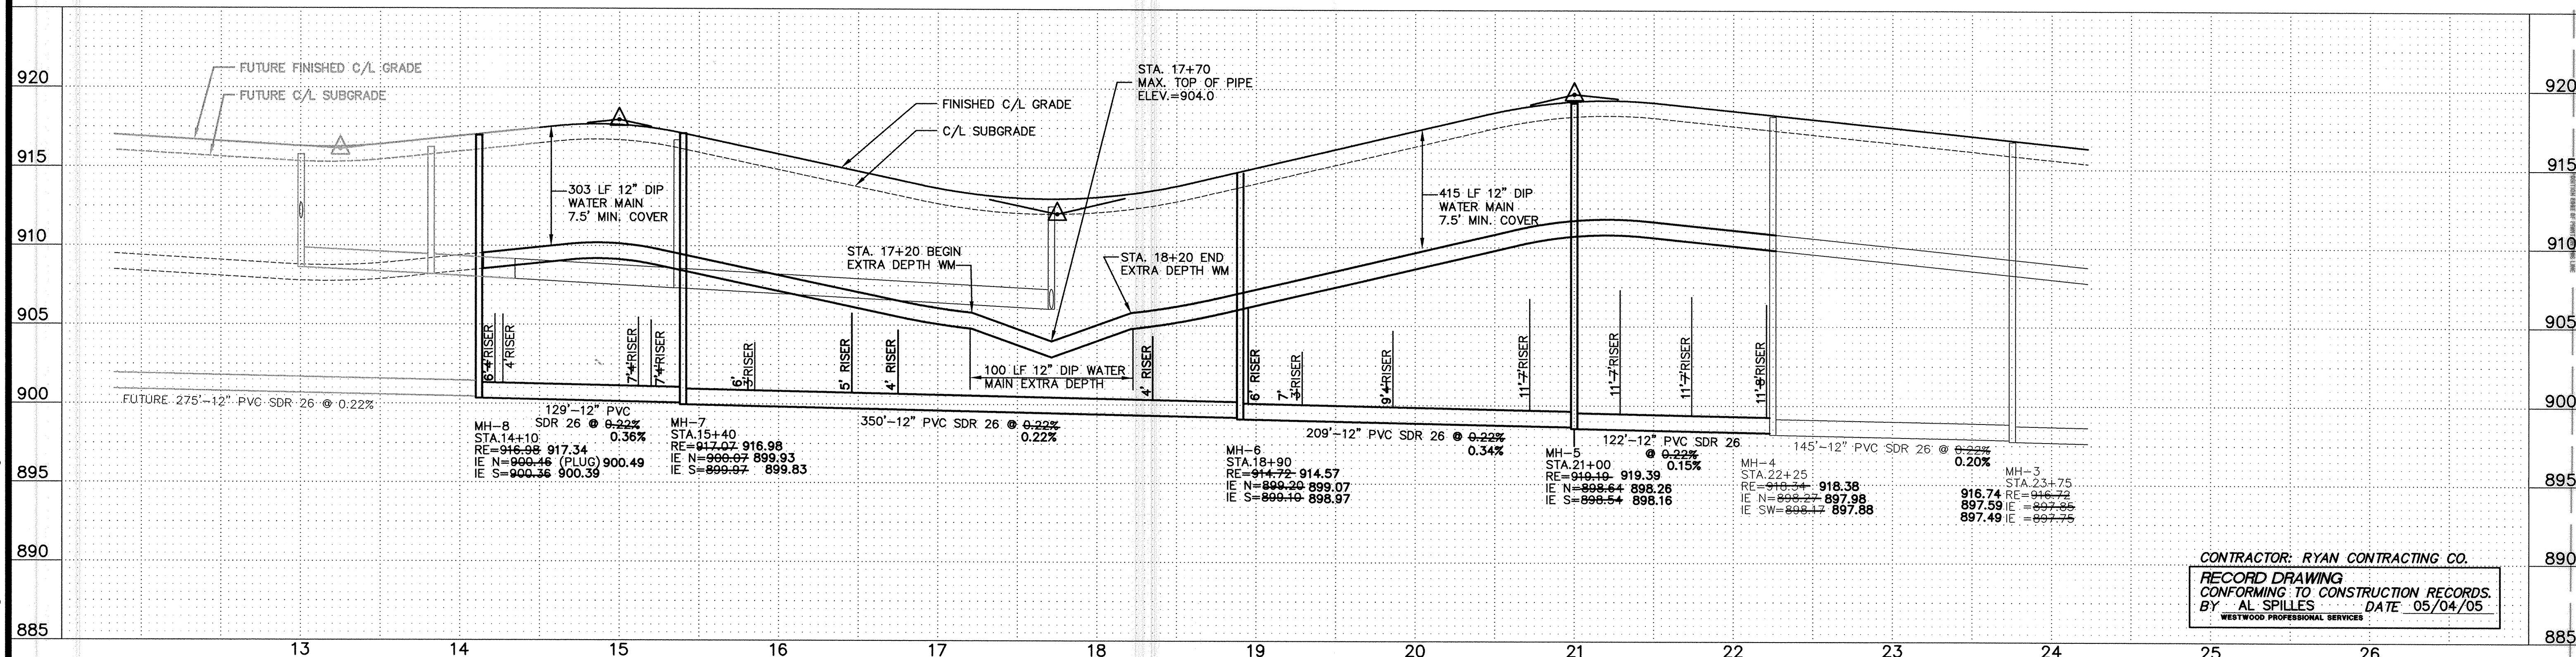


SAFDO PRODUCTS • NEW HOPE, MINNESOTA
REORDER BY PART NUMBER 65152

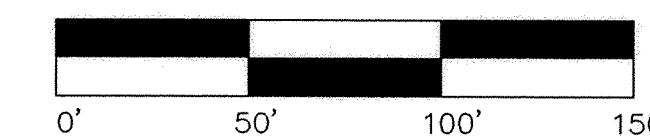

Olson Street (Sta. 14+00 - Sta. 22+25)