
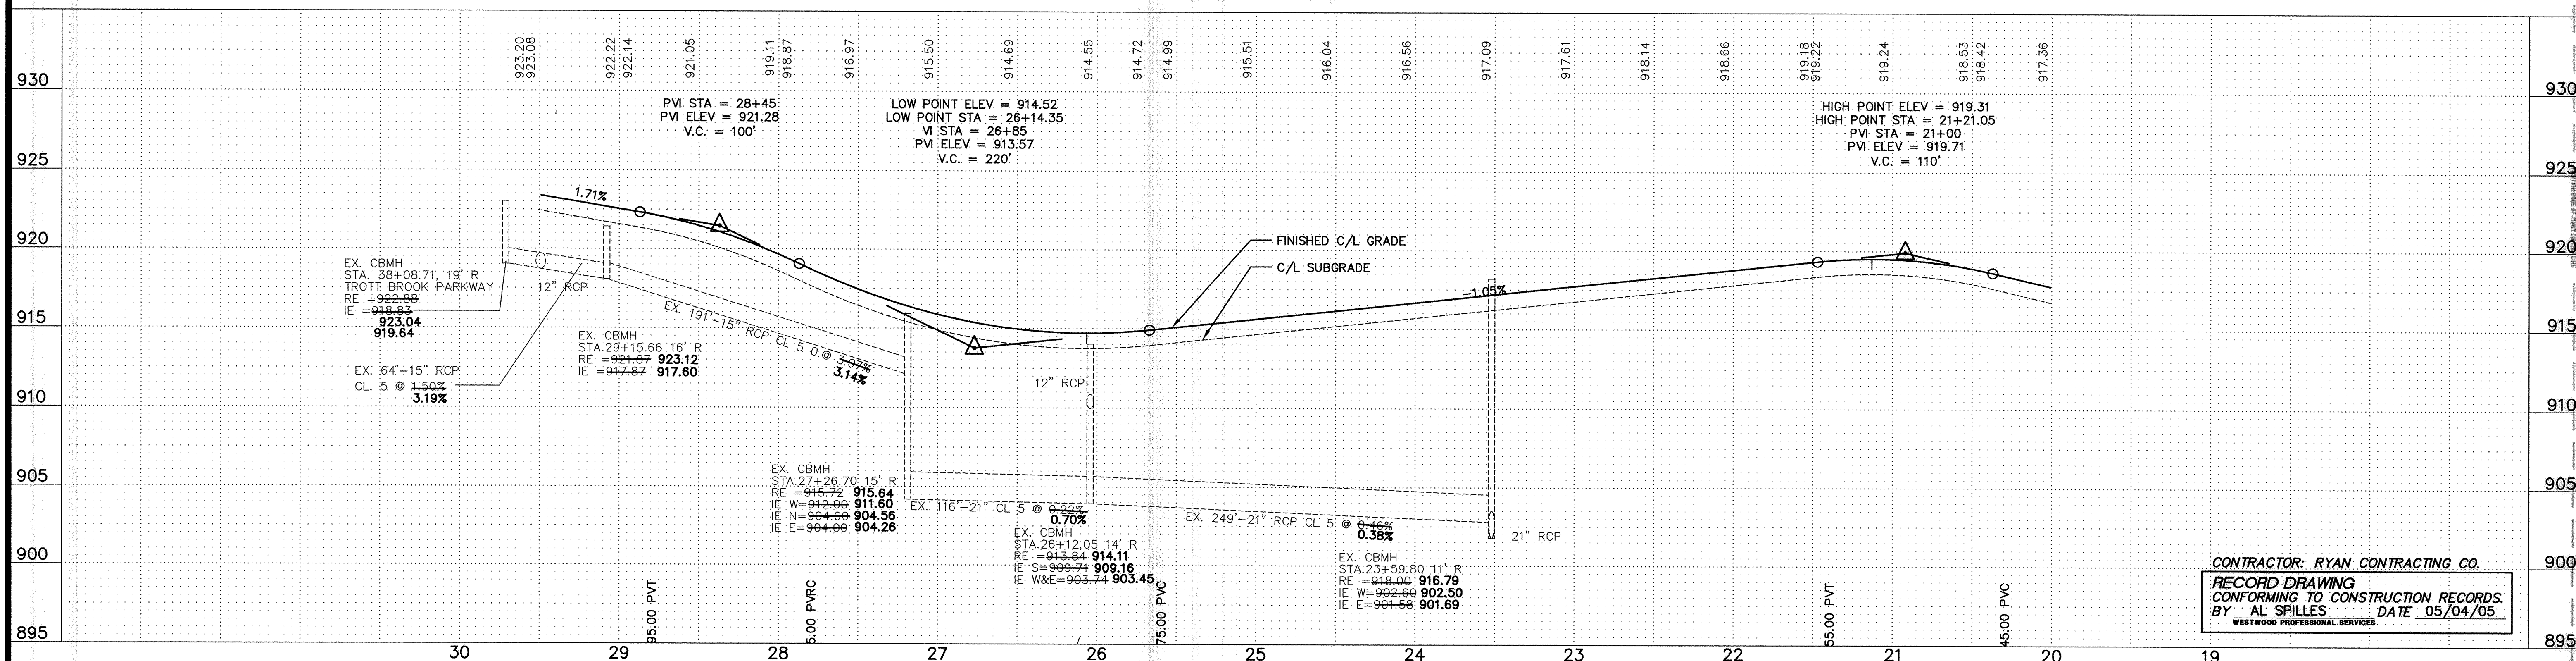
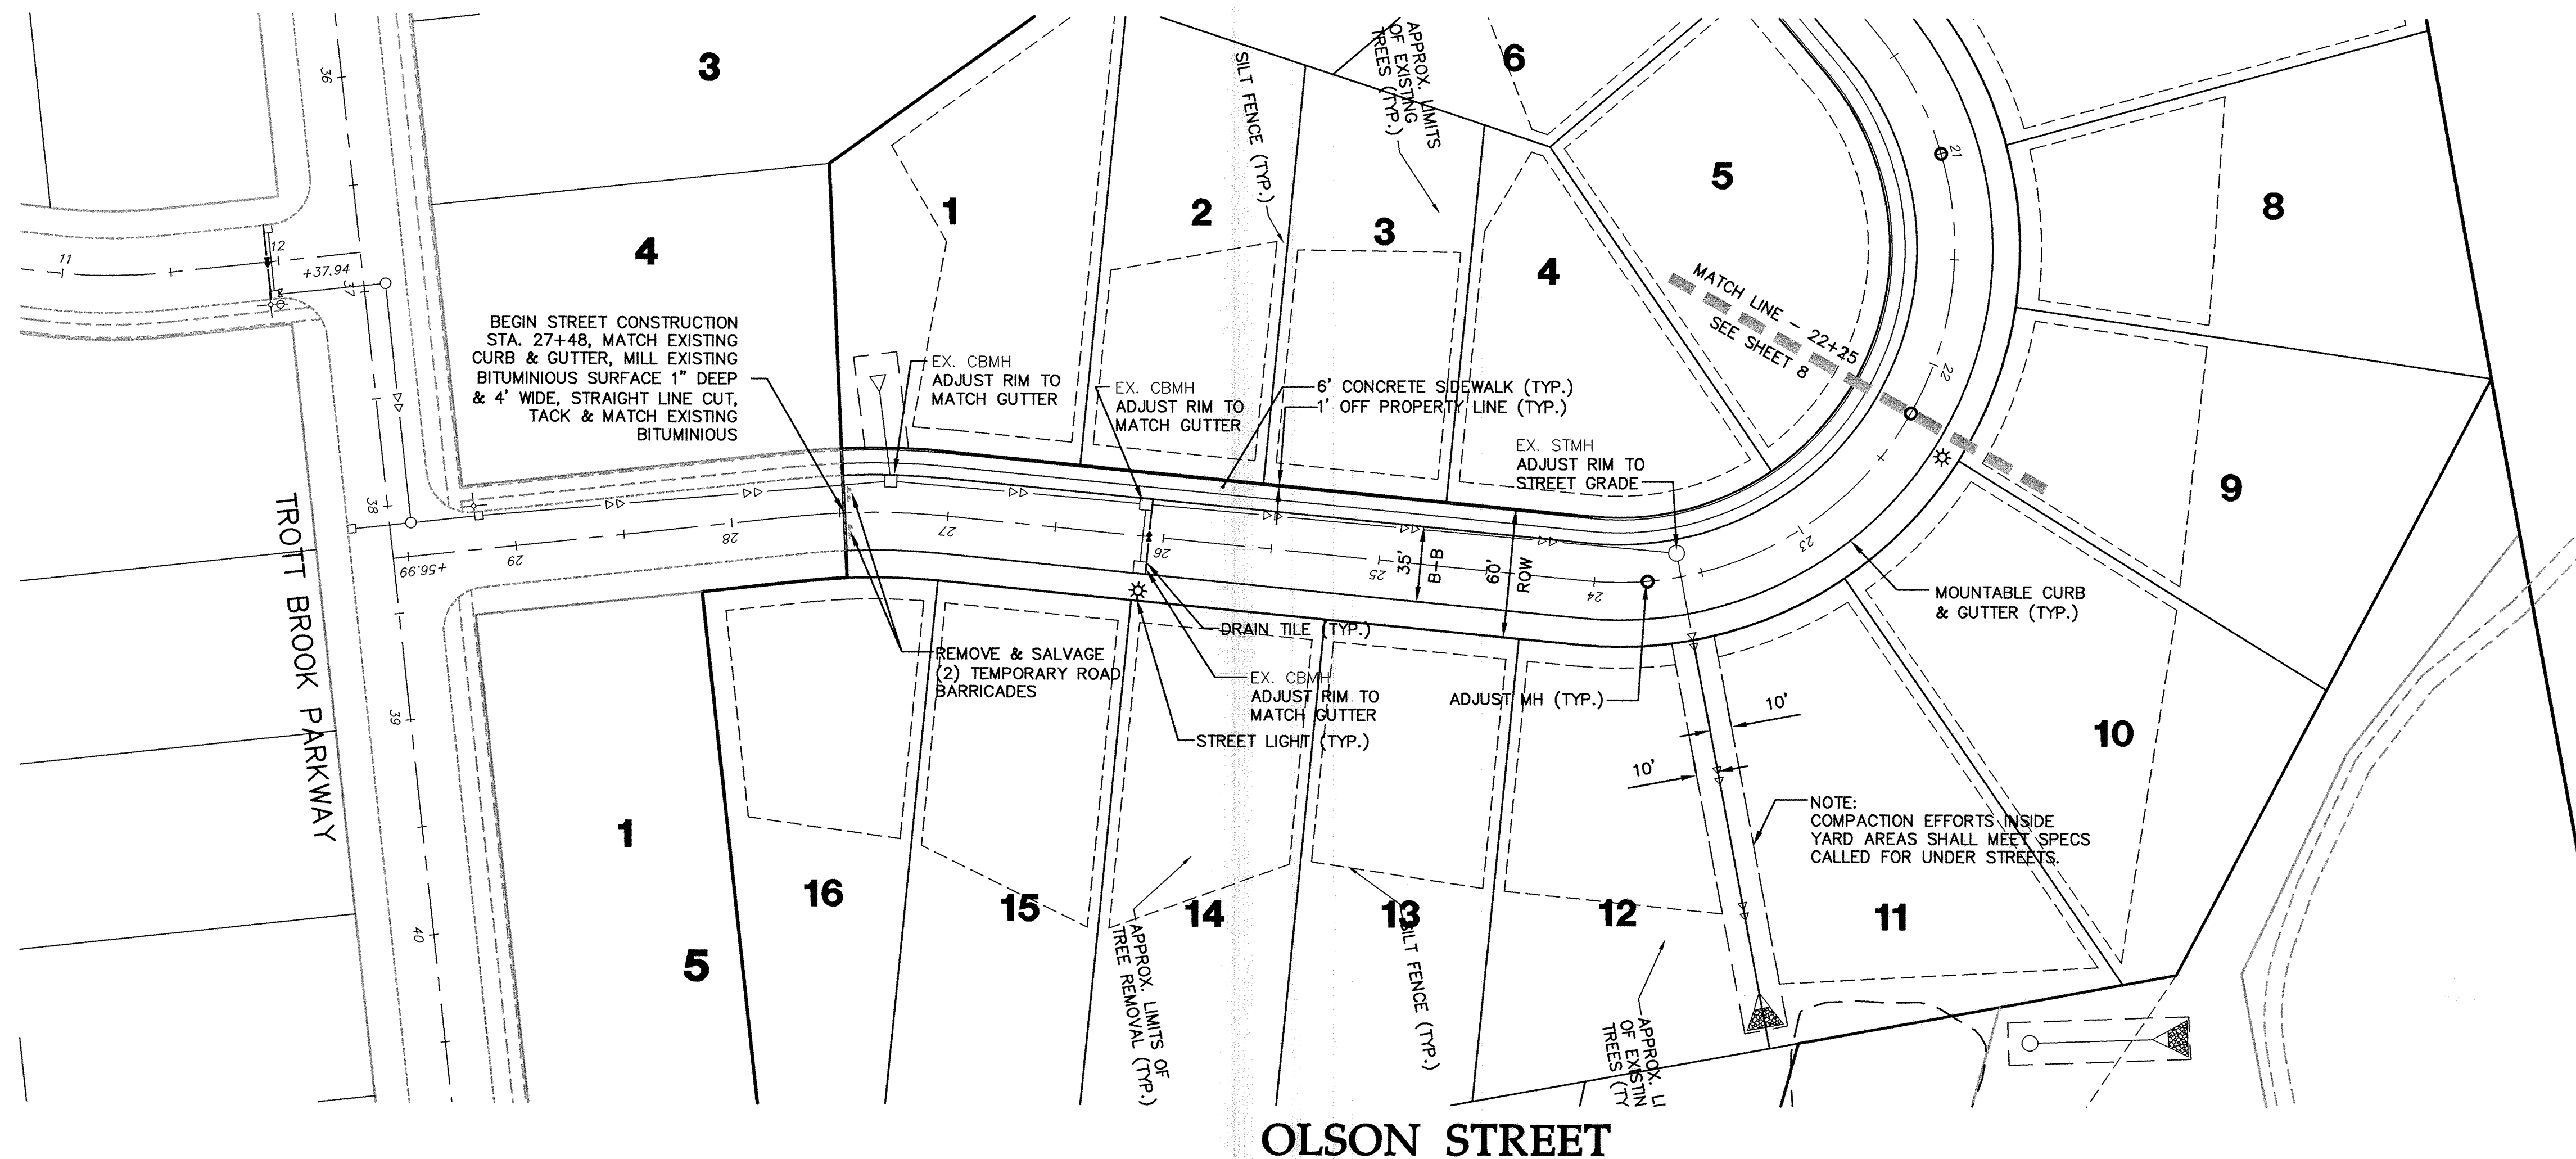


GENERAL NOTES:

- 11.90 * DENOTES GUTTERLINE ELEVATION
AT INTERSECTIONS

CASTING NOTE:

ALL CATCH BASIN CASTINGS IN CURB SHALL BE SUMPED 0.15 FEET AND MANHOLE CASTINGS IN PAVED AREAS SHALL BE SUMPED 0.05 FEET. RIM ELEVATIONS ON PLAN PROFILES REFLECT THE SUMPED ELEVATIONS.

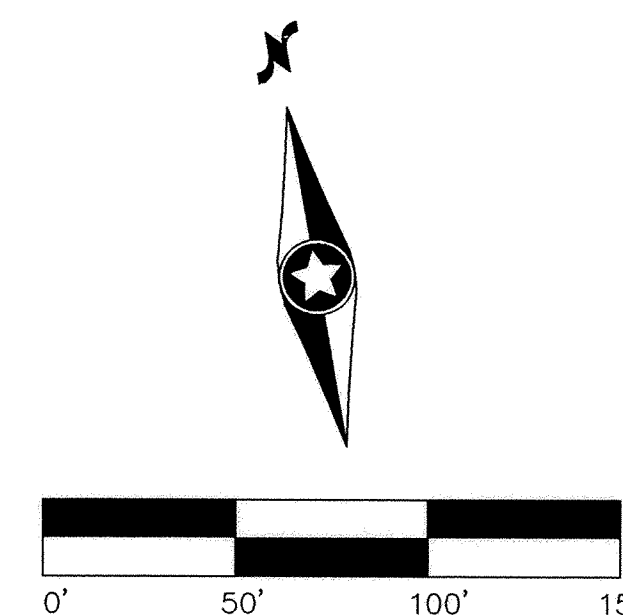

CONTRACTOR: RYAN CONTRACTING CO.
RECORD DRAWING
CONFORMING TO CONSTRUCTION RECORD
BY AL SPILLES DATE 05/04/
WESTWOOD PROFESSIONAL SERVICES

LATEST REVISION DATE: 05/04/05

Date: 07/24/01 Sheet: 7 OF 12

A-9 20011059.00 1059ST@2.0

Storm Sewer

and Street

Construction Plans

Construction Plans

Trott Brook Farms Seventh Addition

Elk River, Minnesota



Westwood Professional Services, Inc.
 7599 Anagram Drive
 Eden Prairie, MN 55344
 Phone: 952/937-5150 Fax: 952/937-5822

I hereby certify that this plan was prepared by me or under my direct supervision and that I am a duly licensed PROFESSIONAL ENGINEER under the laws of the State of Minnesota.

Francis D. Hagen, II
Date: 05/04/05 License No. 17716

Revisions:

8/23/01 PER CITY REVIEW

8

05/04/05 RECORD DRAWING

Designed: JMMc/WH

Checked: ☐ FDH

Drawn: WH/RNS

Revised Drawing by/date: AS E/04/05

Prepared for:

D. R. Horton, Inc. - Minnesota

20860 Kenbridge Court
Lakeville, Minnesota 55044