

GENERAL NOTES:

XXX.X
WYE=X+XX

XXX.X
DENOTES SANITARY SEWER SERVICE
INVERT @ PROPERTY LINE.

XXX.X
DENOTES SANITARY SEWER SERVICE WYE
LOCATED ON MAINLINE FROM
DOWN STREAM M.H.

FLAG HYDRANTS.



HYDRANTS TO BE PLACED
5' BEHIND BACK OF CURB.

EXTEND RODS ON DEEP VALVES.


ALL DROP MANHOLES WITH DROPS OVER 2'
TO CONSTRUCTED USING OUTSIDE DROPS.

SANITARY SEWER & WATER SERVICES TO BE
EXTENDED 10' PAST R.O.W. ON ALL LOTS

W=XXX.X
DENOTES FUTURE GROUND GRADE AT
WATER SERVICE CURB BOX FOR SERVICES
ON TROTT BROOK PARKWAY, OUTSIDE
OF THE 8TH ADDITION.

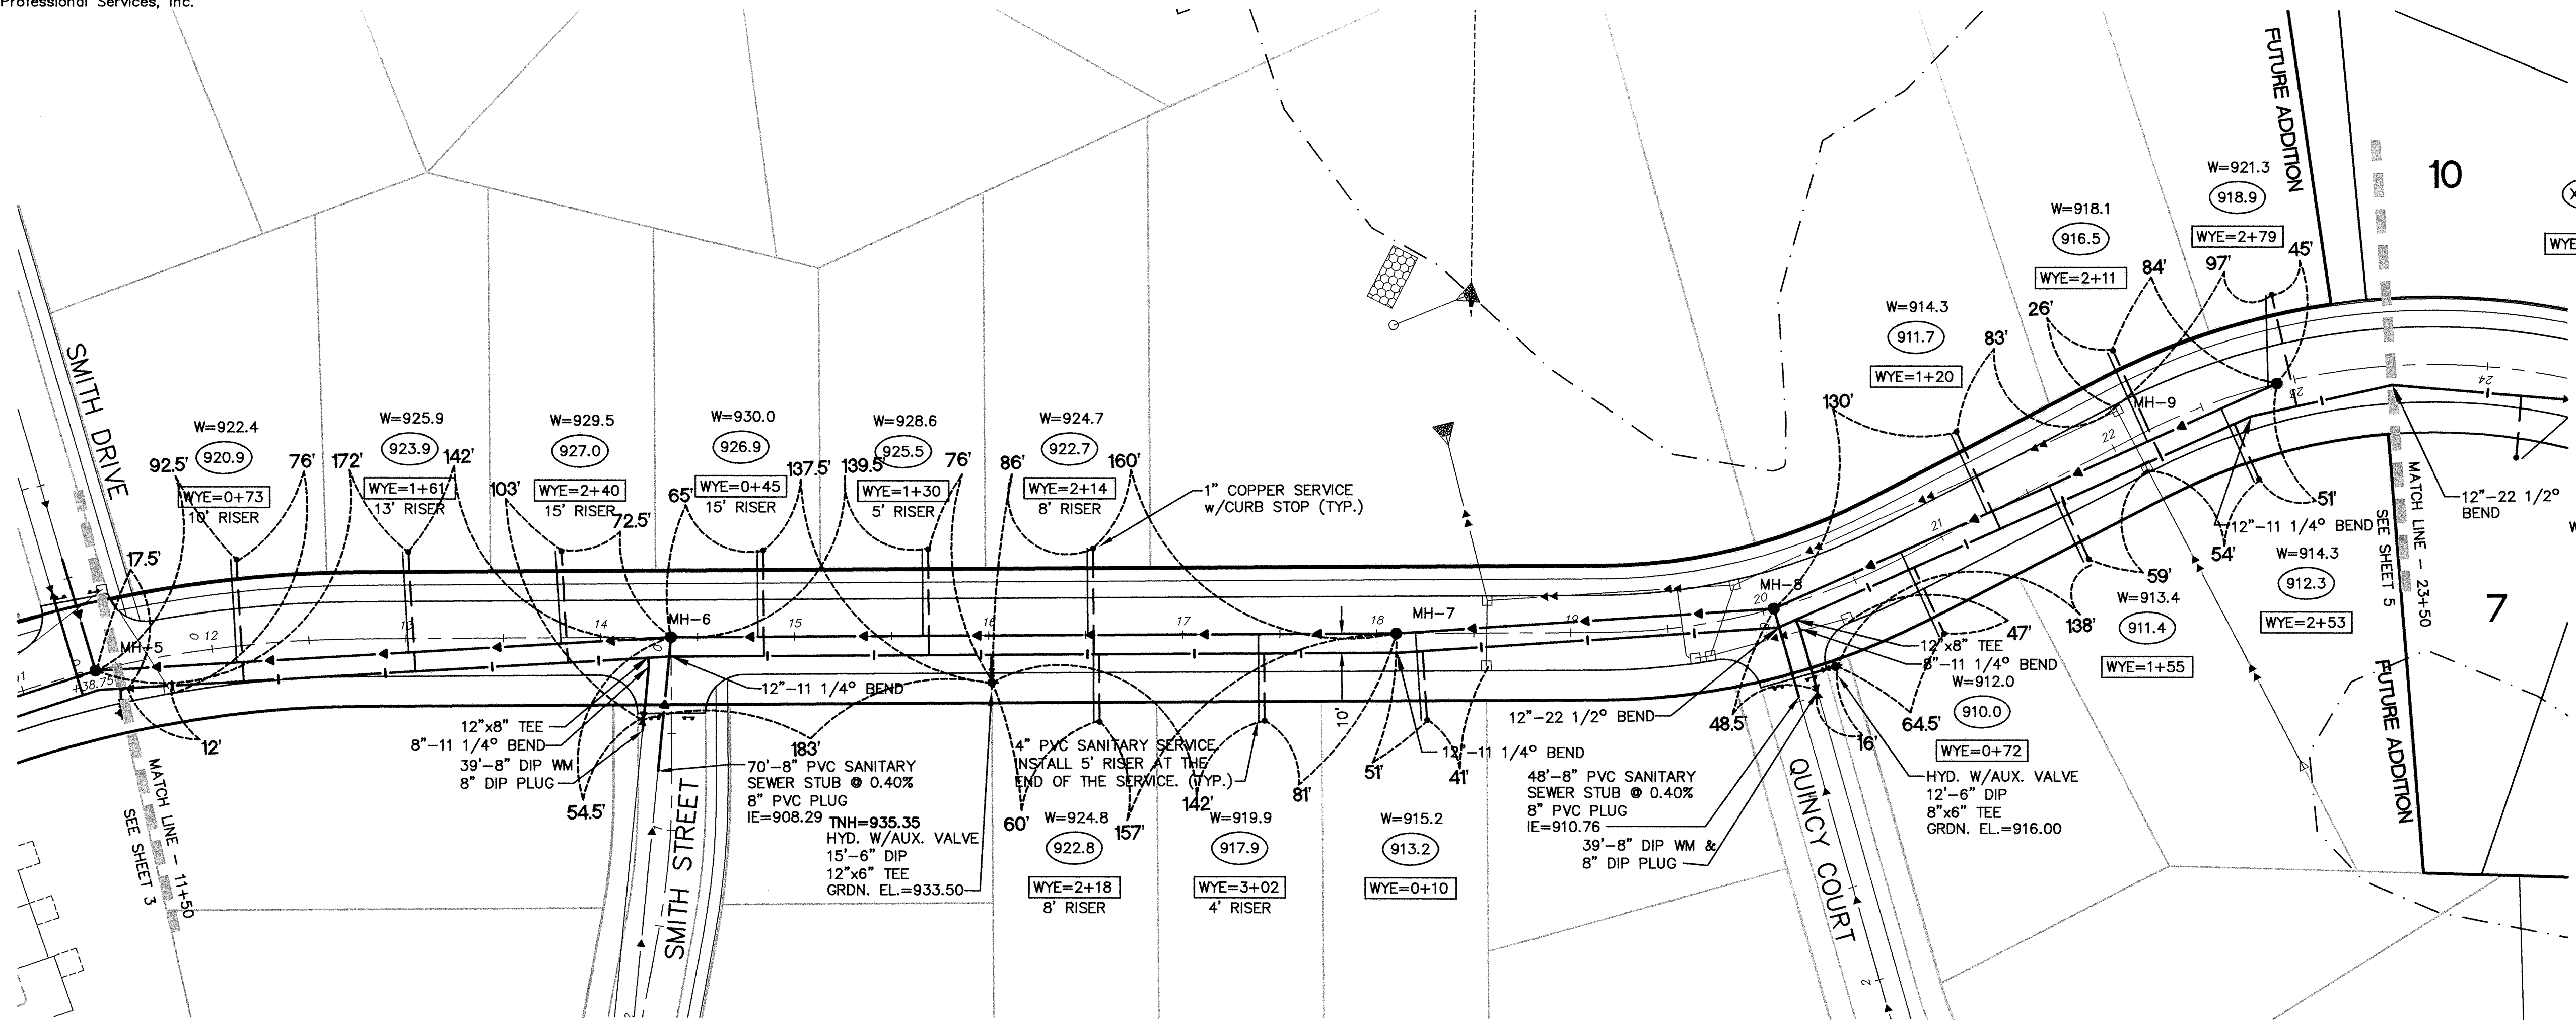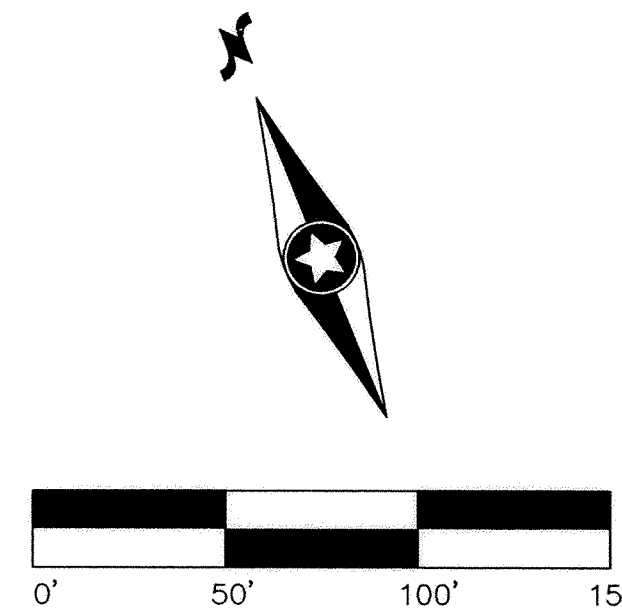

TROTT BROOK PARKWAY

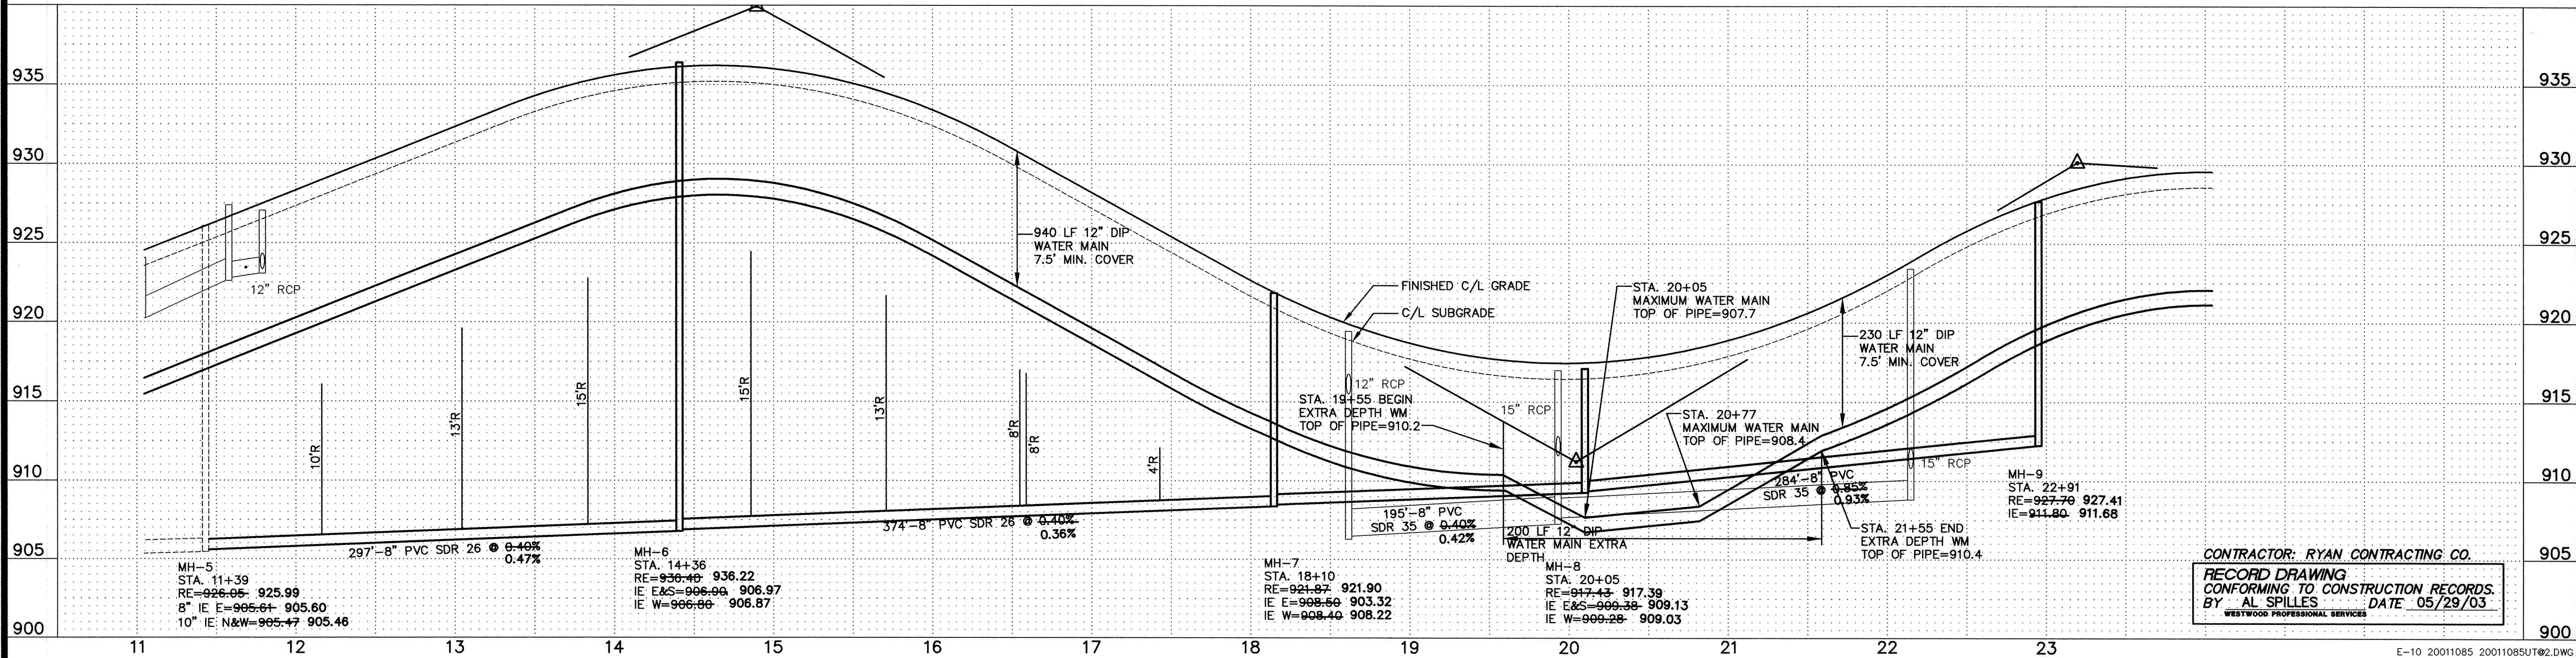

CONTRACTOR: RYAN CONTRACTING CO.
RECORD DRAWING
CONFORMING TO CONSTRUCTION RECORDS.
BY AL SPILLES DATE 05/29/03
WESTWOOD PROFESSIONAL SERVICES

E-10 20011085 20011085UT@2.DWG

Latest Revision Date: 06/14/02

Date: 12/21/01 Sheet: 4 OF 17

Westwood Professional Services, Inc.
7599 Anagram Drive
Eden Prairie, MN 55344
Phone: 952/937-5150 Fax: 952/937-5822

I hereby certify that this plan was prepared by me or under my
direct supervision and that I am a duly licensed PROFESSIONAL
ENGINEER under the laws of the State of Minnesota.

Francis D. Hagen, II
Francis D. Hagen, II
Date: 05/29/03 License No. 17716

Revisions:
03/22/02 Grade/Lot Changes - WH
05/20/02 City Comments-RNS
06/14/02 Route Tyler Court
Intersection - WH

05/29/03 RECORD DRAWINGS (AS/GKS)

Designed: FDH, II
Checked: JMM
Drawn: WH
Record Drawing by/date: 5/29/03 AS

Prepared for:

D.R. Horton, Inc.
20860 Kenbridge Court
Lakeville, Minnesota 55044

**Trott Brook Farms
Eighth Addition**

Elk River, Minnesota

**Sanitary Sewer
and Water Main
Construction Plans**

Trott Brook Parkway Sta. 11+50 - 23+50

DRAWING NUMBER

DRAWING NUMBER

DRAWING NUMBER

DRAWING NUMBER
TROT8.03