

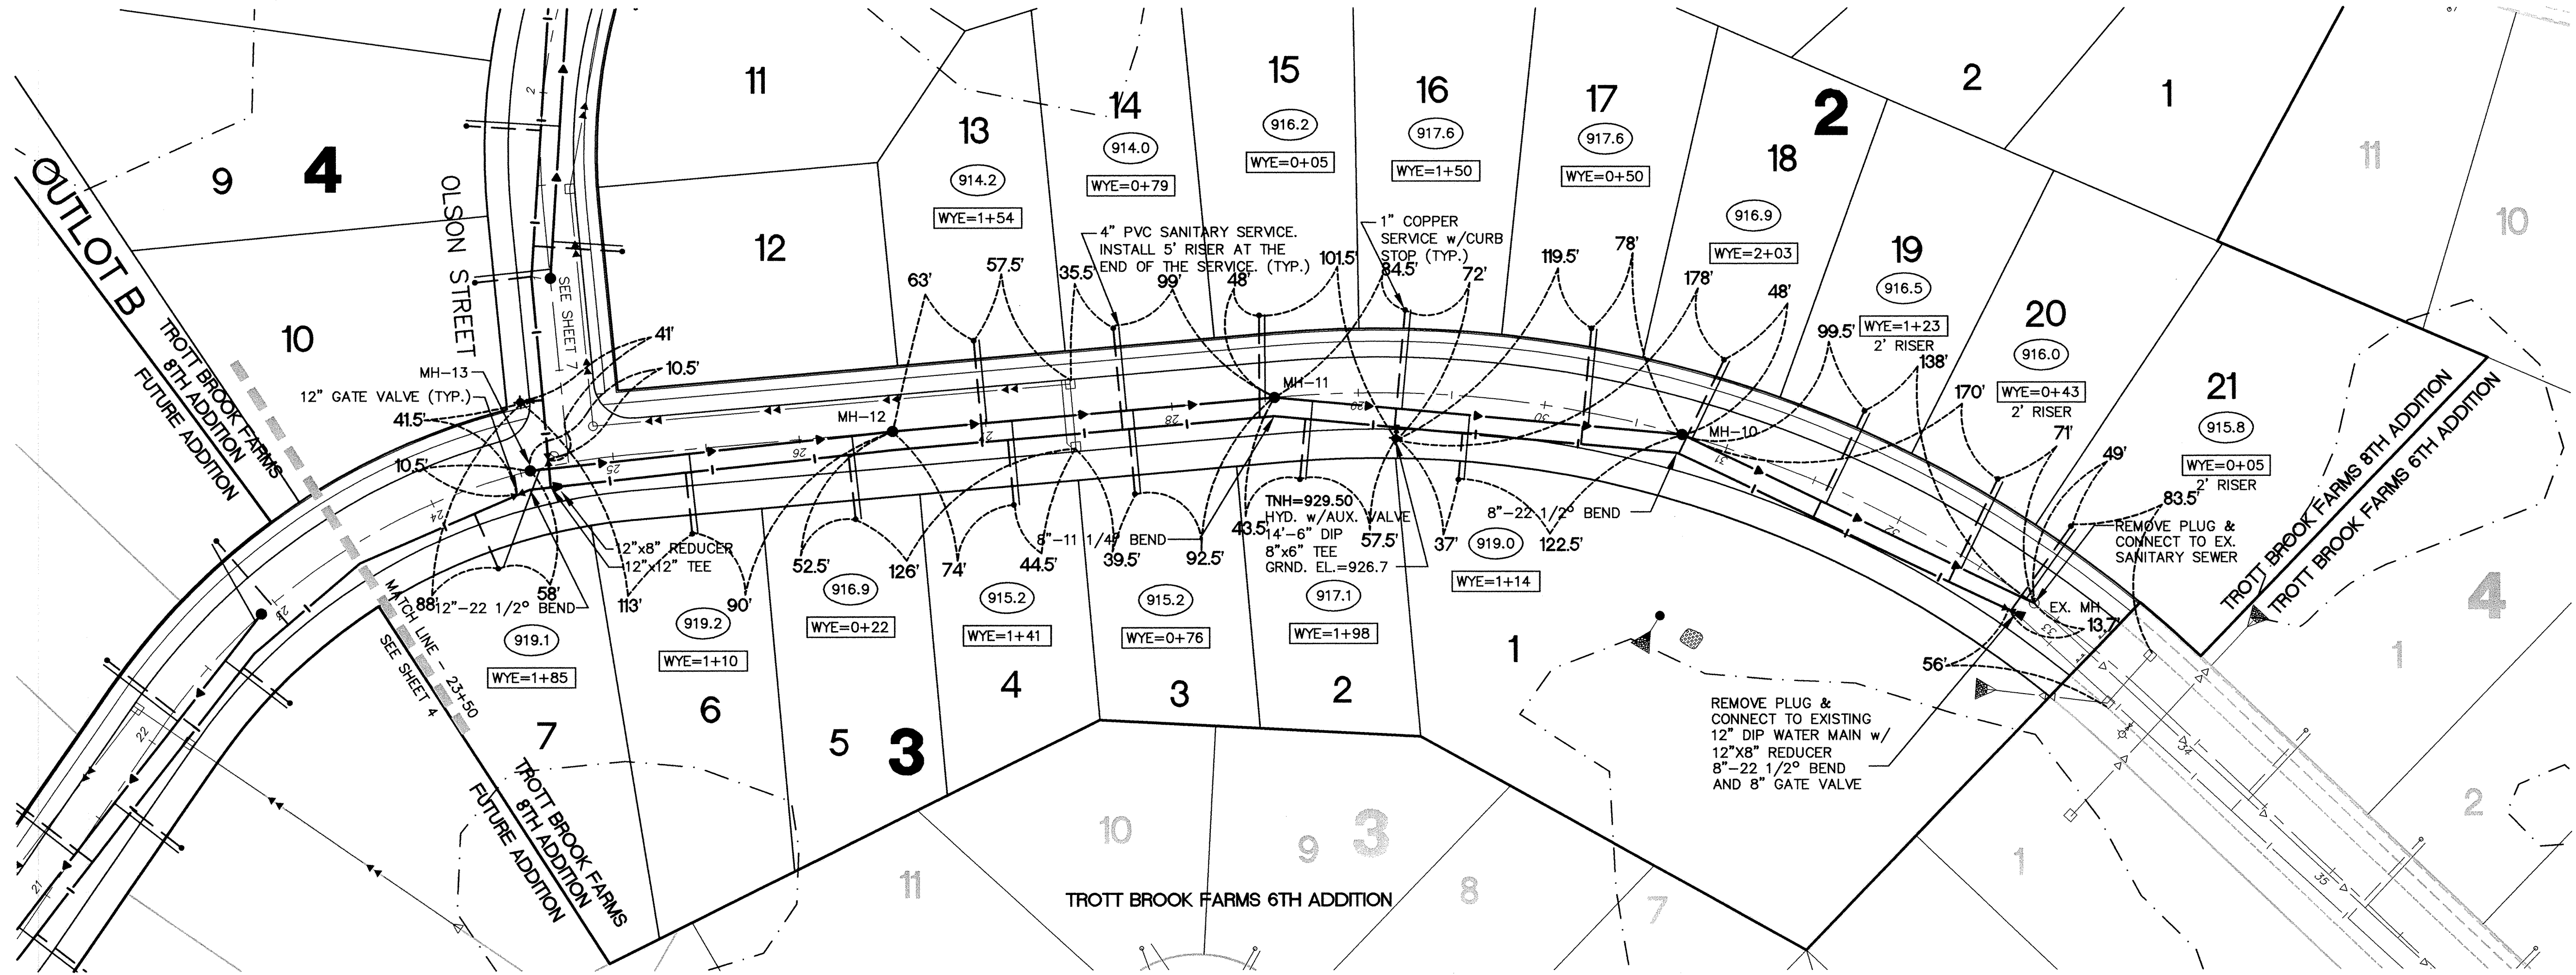


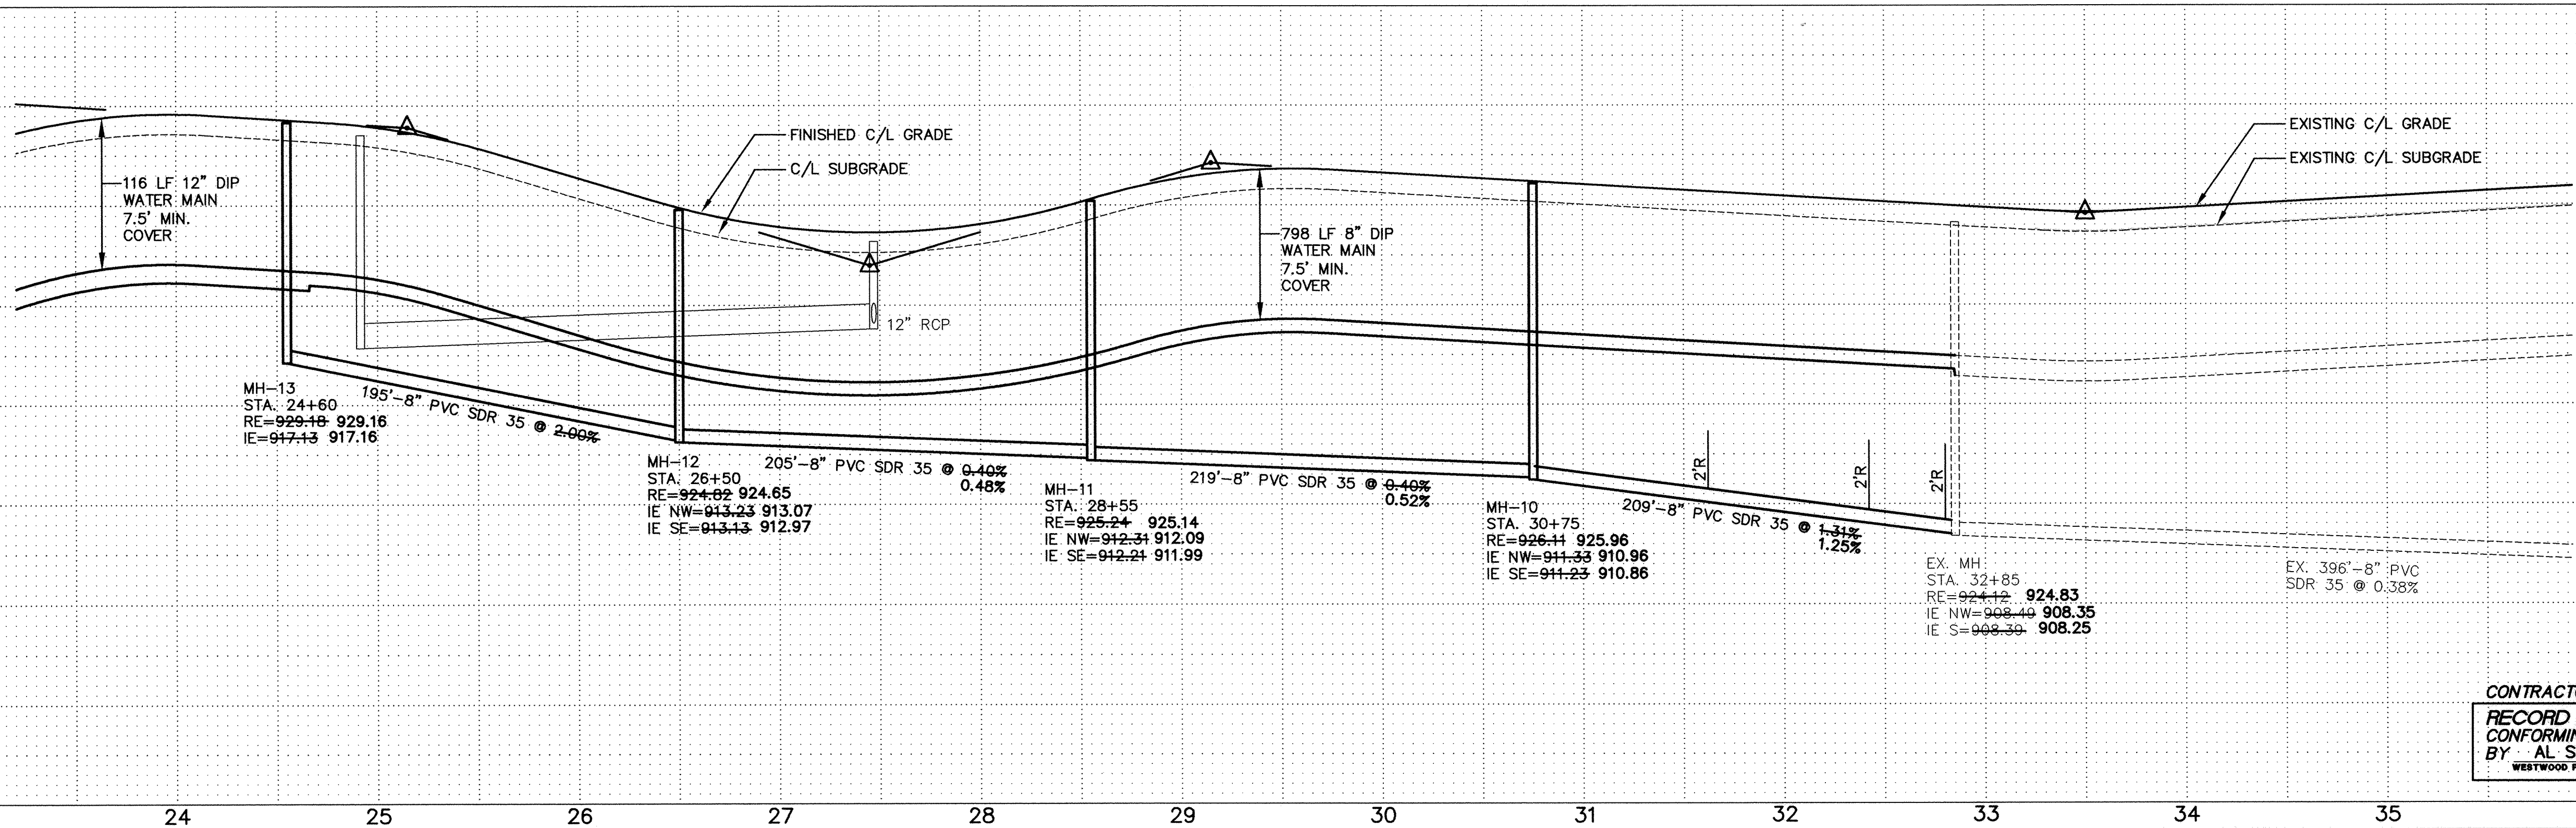

Call 48 Hours before digging:
GOPHER STATE ONE CALL
Twin City Area 651-454-0002
Mn. Toll Free 1-800-252-1166

GENERAL NOTES:

- XXX.X DENOTES SANITARY SEWER SERVICE INVERT @ PROPERTY LINE.
- WYE=X+XX DENOTES SANITARY SEWER SERVICE WYE LOCATED ON MAINLINE FROM DOWN STREAM M.H.
- FLAG HYDRANTS.
- HYDRANTS TO BE PLACED 5' BEHIND BACK OF CURB.
- EXTEND RODS ON DEEP VALVES.
- ALL DROP MANHOLES WITH DROPS OVER 2' TO CONSTRUCTED USING OUTSIDE DROPS.
- SANITARY SEWER & WATER SERVICES TO BE EXTENDED 10' PAST R.O.W. ON ALL LOTS

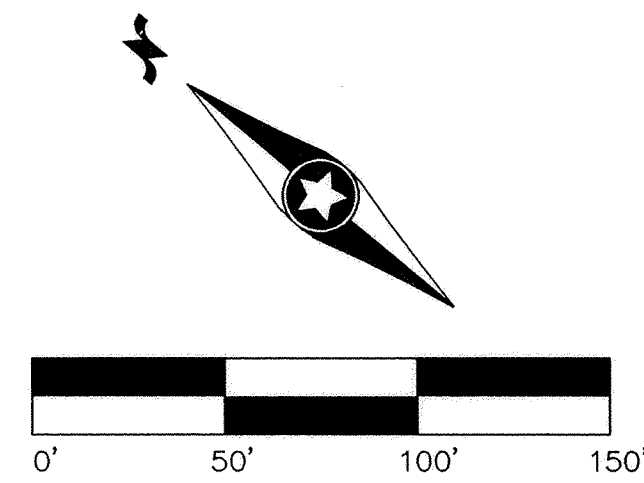

CONTRACTOR: RYAN CONTRACTING CO.
RECORD DRAWING
CONFORMING TO CONSTRUCTION RECORDS.
BY AL SPILLER DATE 05/29/03
WESTWOOD PROFESSIONAL SERVICES

Westwood Professional Services, Inc.
7599 Anagram Drive
Eden Prairie, MN 55344
Phone: 952/937-5150 Fax: 952/937-5822

I hereby certify that this plan was prepared by me or under my direct supervision and that I am a duly licensed PROFESSIONAL ENGINEER under the laws of the State of Minnesota.

Francis D. Hagen, II
Date: 05/29/03 License No. 17716

Revisions:
03/22/02 Grade/Lot Changes - WH
05/20/02 City Review - RVS
06/14/02 Rose Tyler Court Intersection - WH
05/29/03 RECORD DRAWINGS (AS/GKB)

Designed: FDEH, II
Checked: JMM
Drawn: WH
Record Drawing by/date: 5/29/03 AS

Prepared for:

D.R. Horton, Inc.
20860 Kenbridge Court
Lakeville, Minnesota 55044

**Trott Brook Farms
Eighth Addition**
Elk River, Minnesota

**Sanitary Sewer
and Water Main
Construction Plans**
Trott Brook Parkway Sta. 23+50 - 33+25

Date: 12/21/01 Sheet: 5 OF 17

DRAWING NUMBER
TROT8.03
5