

Record Drawings

for

Sanitary Sewer, Water Main, Storm Sewer and Streets

for

Trott Brook Farms 9th Addition Elk River, Minnesota

Prepared for:

D. R. Horton, Inc.
 20860 Kenbridge Court
 Lakeville, Minnesota 55044
 Contact: Tom Bakritges
 Phone: 952-985-7826
 Fax: 952-985-7800

Prepared by:




Westwood Professional Services, Inc.
 7699 Anagram Drive
 Eden Prairie, MN 55344

PHONE 952-937-5150
 FAX 952-937-5822
 TOLL FREE 1-888-937-5150

www.westwoodps.com

Project number: 20031125
 Contact: Jason McCarty

VICINITY MAP:

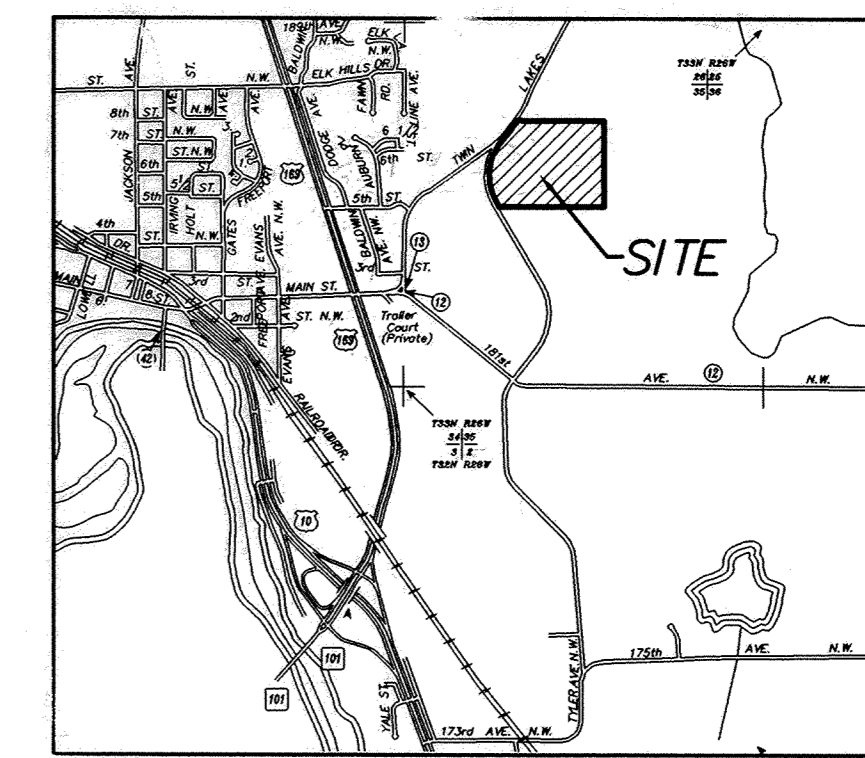

ELK RIVER
 No Scale

INDEX	
SHEET NO.	DESCRIPTION
1	COVER
2	OVERALL PLAN
3	SANITARY SEWER & WATER MAIN - SMITH STREET (STA. 0+00 TO STA. 8+00)
4	SANITARY SEWER & WATER MAIN. - SMITH STREET (STA. 8+00 TO STA. 13+48.44) AND 185TH CIRCLE
5	SANITARY SEWER & WATER MAIN - QUINCY CIRCLE
6	STORM SEWER & STREET CONST. - SMITH STREET (STA. 0+00 TO STA. 8+00)
7	STORM SEWER & STREET CONST. - SMITH STREET (STA. 8+00 TO STA. 13+48.44) AND 185TH CIRCLE
8	STREET CONSTRUCTION - QUINCY CIRCLE
9-12	DETAILS

NO.	DATE	REVISION	SHEETS
1	02/05/04	PER CITY REVIEW	ALL
2	04/27/04	WATER MAIN CHANGE	1,2,4,5,7,8
3	06/16/04	STORM SEWER REVISION	ALL
4	04/06/06	RECORD DRAWINGS	ALL

CONTRACTOR: RYAN CONTRACTING CO.
 RECORD DRAWING
 CONFORMING TO CONSTRUCTION RECORDS.
 BY STEVE PFLIPSEN DATE 04/06/06
 WESTWOOD PROFESSIONAL SERVICES

Record Drawings

for

Sanitary Sewer, Water Main, Storm Sewer and Streets

for

Trott Brook Farms 9th Addition Elk River, Minnesota

Date: 12/05/03 Sheet: 1 of 12

DRAWING NUMBER

DRAWING NUMBER

DRAWING NUMBER

DRAWING NUMBER
 TROTTS 05
 1

Trott Brook Farms
 9th Addition - 2005