

Record Drawings

for

Sanitary Sewer, Water Main, Storm Sewer and Streets

for

Trott Brook Farms 10th Addition Elk River, Minnesota

Prepared by


D.R. Horton, Inc.
20860 Kenbridge Court, Suite 100
Lakeville, MN 55044
Contact: Tom Bakstges
Phone: 952-985-7826
Fax: 952-985-7800

Prepared by:



Westwood Professional Services, Inc.
7699 Anagnos
Eden Prairie, MN 55324
PHO: 952-5150
FAX: 952-5822
952-5156

Vicinity Map

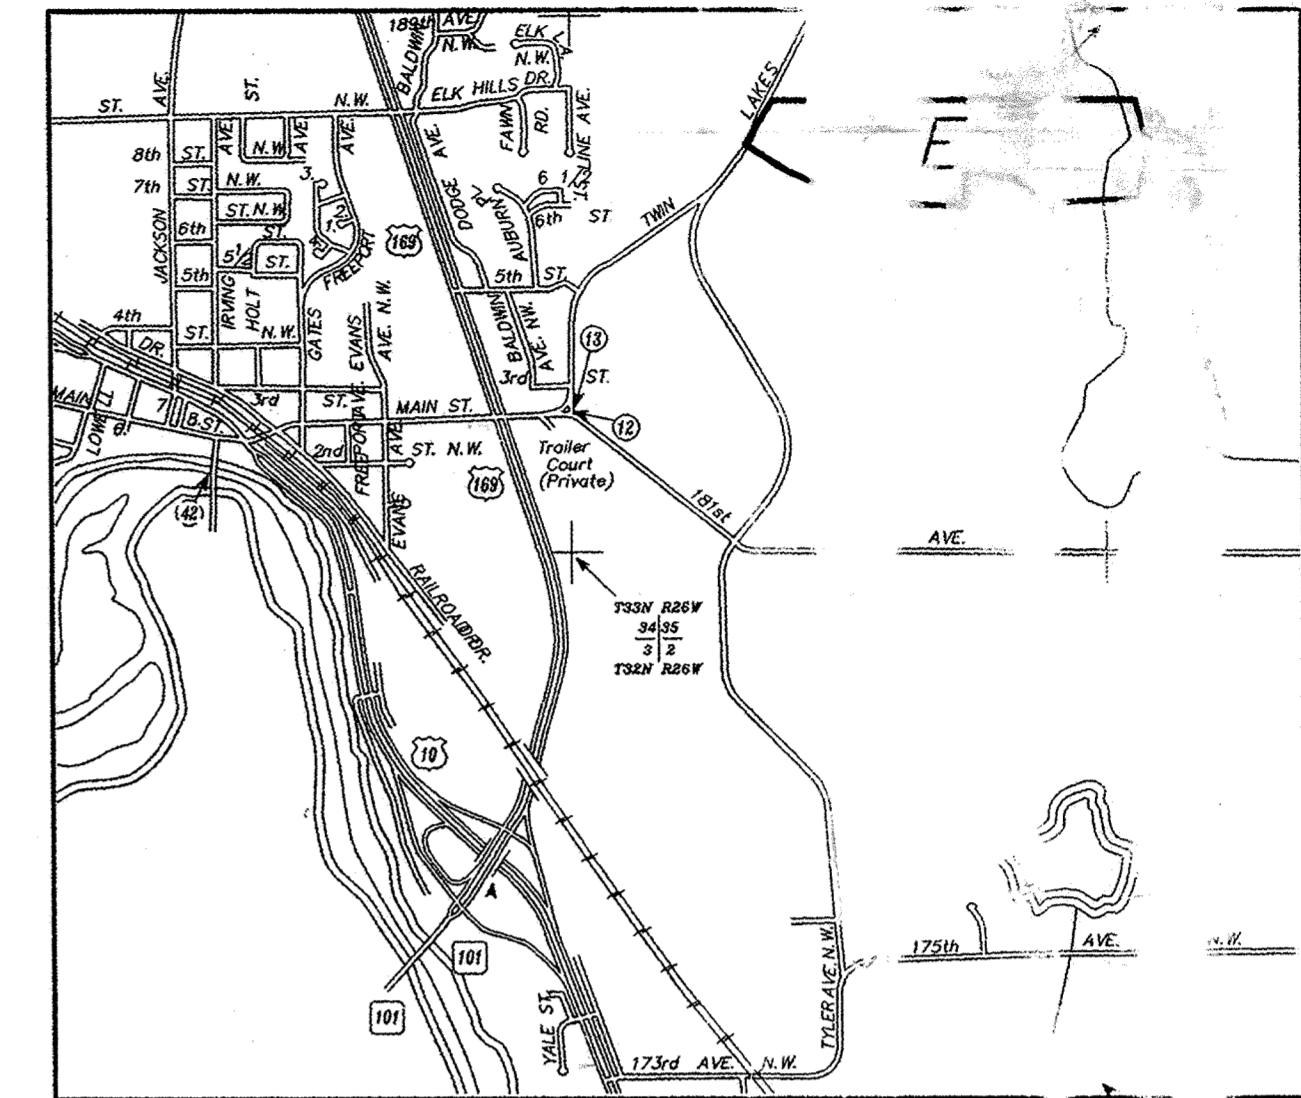

ELK RIVER
No Scale

INDEX	
SHEET NO.	DESCRIPTION
1	COVER
2	OVERALL PLAN
3	SANITARY SEWER & WATER MAIN - SMITH DRIVE
4	SANITARY SEWER & WATER MAIN - 186TH CIRCLE
5	SANITARY SEWER & WATER MAIN - 187TH AVENUE
6	STORM SEWER & STREET CONST. - SMITH DRIVE
7	STORM SEWER & STREET CONST. - 186TH CIRCLE
8	STORM SEWER & STREET CONST. - 187TH AVENUE
9-12	DETAILS

NO.	DATE	REVISION	SHEETS
1	09/14/04	CITY REVIEW	ALL
2	10/18/04	ADD 186TH CIRCLE TO ALIGNMENT	ALL
3	11/04/04	CITY REVIEW	ALL
4	11/11/04	SANITARY REVISION	4
5	11/18/04	SMITH DRIVE DRAIN ALIGNMENT	ALL
6	12/20/04	SMITH DRIVE REVISION	ALL
7	10/12/06	RECORD DRAWINGS	ALL
8	12/08/06	RECORD DRAWINGS	ALL

APPROVED FOR CONSTRUCTION BY CITY ENGINEER

TERRY J. MAURER, P.E. DATE

CONTRACTOR: Ryan Contracting Co.
8700 13th Ave. East
Shakopee, MN 55379
952-894-3200

RECORD DRAWING
CONFORMING TO CONSTRUCTION RECORDS.
BY STEVE PFLIPSEN DATE 12/08/06
WESTWOOD PROFESSIONAL SERVICES

Record Drawings

for
**Sanitary Sewer, Water Main,
Storm Sewer and Streets**
for
Trott Brook Farms
Elk River, Minnesota