


STORM SEWER CASTING SCHEDULE		
STRUCTURE		
NUMBER	TYPE	CASTING TYPE
74B	CBMH	R-3067
74C	CB	R-3067
200	FES	TRASH GUARD
201	STMH	R-1733
204	CBMH	R-3067
205	CBMH	R-3067
206	CBMH	R-3067
207	CBMH	R-3067
208	CB	R-3067
209	CBMH	R-3508-A2
210	CB	R-3067
211	CBMH	R-3067
212	CB	R-3067
213	CBMH	R-3067
213A	CBMH	R-3067
214	CBMH	R-4342
215	CB	R-4342
216	CBMH	R-3067
217	CBMH	R-3067
218	CB	R-3067

CONTRACTOR: Ryan Contracting Co.
 8700 13th Ave. East
 Shakopee, MN 55379
 # 952-894-3200

RECORD DRAWING
 CONFORMING TO CONSTRUCTION RECORDS.
 BY STEVE PFLIPSEN DATE 12/08/06

LEGEND

FUTURE	EXISTING	PROPOSED
Sanitary Sewer	Sanitary Sewer	Sanitary Sewer
Water	Water	Water
Hyd. w/Valve	Hyd. w/Valve	Hyd. w/Valve
Storm Sewer	Storm Sewer	Storm Sewer

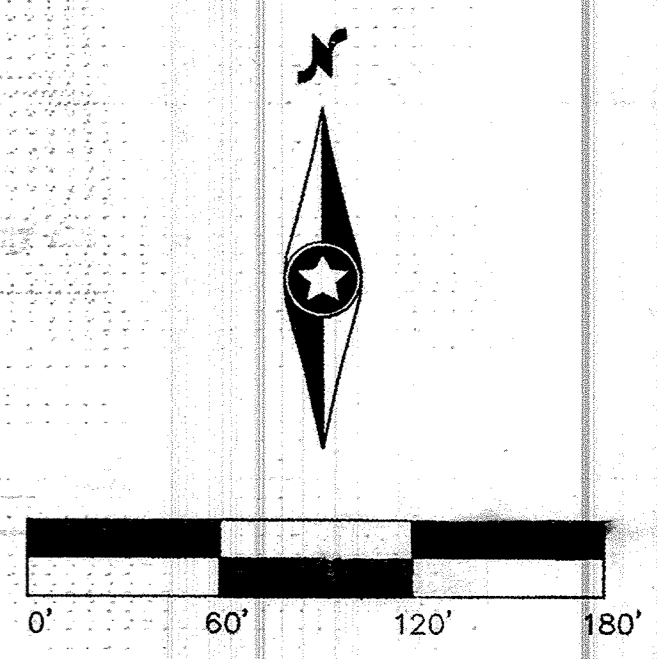

E-3 200411260A@01.DWG
 Latest Revision Date: 12/20/04
 Date: 10/18/04 Sheet: 2 OF 12

Westwood Professional Services, Inc.
 7669 Ansgar Drive
 Eden Prairie, MN 55344
 PHONE 952-937-5150
 FAX 952-937-5822
 TOLL FREE 1-888-937-5150
 www.westwoods.com

I hereby certify that this plan was prepared by me or under my direct supervision and that I am a duly licensed PROFESSIONAL ENGINEER under the laws of the State of Minnesota.

Jason M. McCarty
 Date: 12/08/06 License No. 41955

Revisions:

11/04/04 CITY REVIEW (SHS)	DDM
11/19/04 SMITH DRIVE DATUM ALIGNMENT (CLJ)	CLJ
12/22/04 SMITH DRIVE REVISION (SHS)	SHS
10/12/06 RECORD DRAWING (GCB)	
12/08/06 RECORD DRAWING-BOM COMMENTS (SWW)	

Designed: DDM
 Checked: CLJ
 Drawn: SHS
 Record Drawing by/date:

Prepared for:
D.R. Horton, Inc.
 20860 Kenbridge Court, Suite 100
 Lakeville, Minnesota 55044

Trott Brook Farms
10th Addition
 Elk River, Minnesota

Overall Plan

P:\20041126.dwg Record\20041126Dwg.dwg 12/8/2006 1:43:30 PM CST