

# Record Drawings

for

## Sanitary Sewer, Water Main, Storm Sewer and Streets

for

### Trott Brook Farms 11th Addition Elk River, Minnesota

Prepared for:

**D.R. Horton, Inc.**  
20860 Kenbridge Court, Suite 100  
Lakeville, MN 55044  
Contact: Dave Klee  
Phone: 952-985-7826  
Fax: 952-985-7800

Prepared by:



Westwood Professional Services, Inc.  
7699 Anagram Drive  
Eden Prairie, MN 55344  
PHONE 952-937-5150  
FAX 952-937-5822  
TOLL FREE 1-888-937-5151


Westwood

www.westwoodps.com

Project number: 20041209

Contact: Jason M. McCarty P.E.

### Vicinity Map

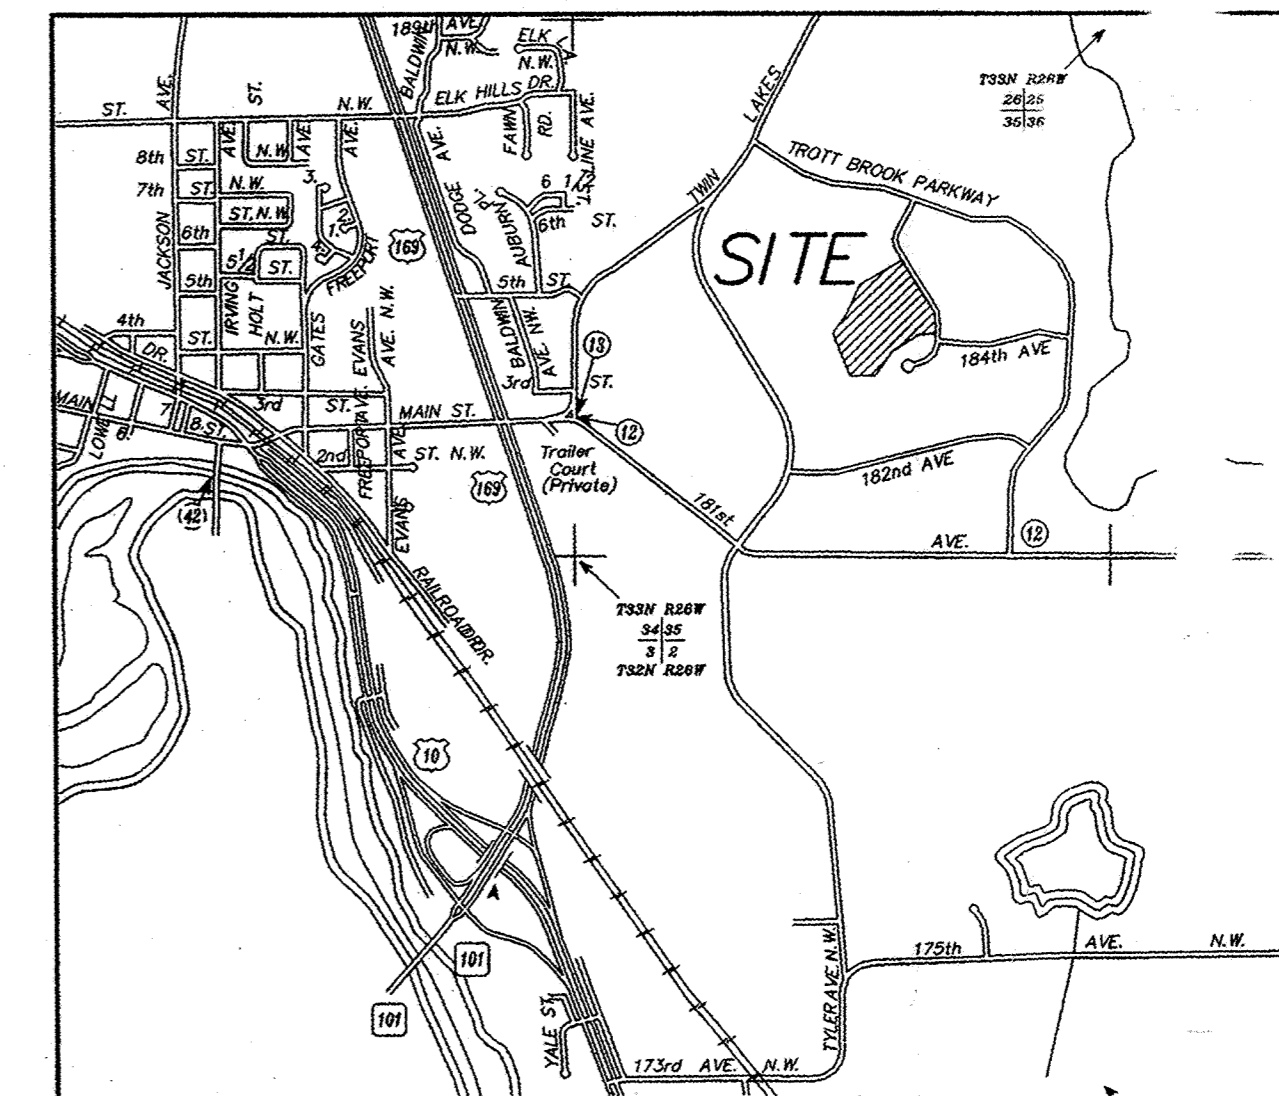

**ELK RIVER**  
No Scale

CONTRACTOR: Ryan Contracting Co.  
8700 13th Ave. East  
Shakopee, MN 55379  
# 952-894-3200

RECORD DRAWING  
CONFORMING TO CONSTRUCTION RECORDS.  
BY STEVE PHILIPSEN DATE 12/08/06  
WESTWOOD PROFESSIONAL SERVICES

NO.	DATE	REVISION	SHEETS
1	02/25/05	PER CITY REVIEW	ALL
2	04/05/05	PER CITY REVIEW	ALL
3	10/12/06	RECORD DRAWINGS	ALL
4	12/08/06	RECORD DRAWINGS	ALL

APPROVED FOR CONSTRUCTION

TERRY MAURER, CITY ENGINEER

INDEX	
SHEET NO.	DESCRIPTION
1	COVER
2	OVERALL PLAN
3	SANITARY SEWER & WATER MAIN - 185TH COURT
4	SANITARY SEWER & WATER MAIN - 184TH CIRCLE
5	STORM SEWER & STREET CONST. - 185TH COURT
6	STORM SEWER & STREET CONST. - 184TH CIRCLE
7-10	DETAILS

### Record Drawings

for

#### Sanitary Sewer, Water Main, Storm Sewer and Streets

for

#### Trott Brook Farms 11th Addition Elk River, Minnesota

Date: 12/30/04

Vertical text on the right edge of the page, including project details and company information.

P:\20041209.dwg\RECORD\20041209CV@01.dwg 12/8/2006 12:40:39 PM CST