
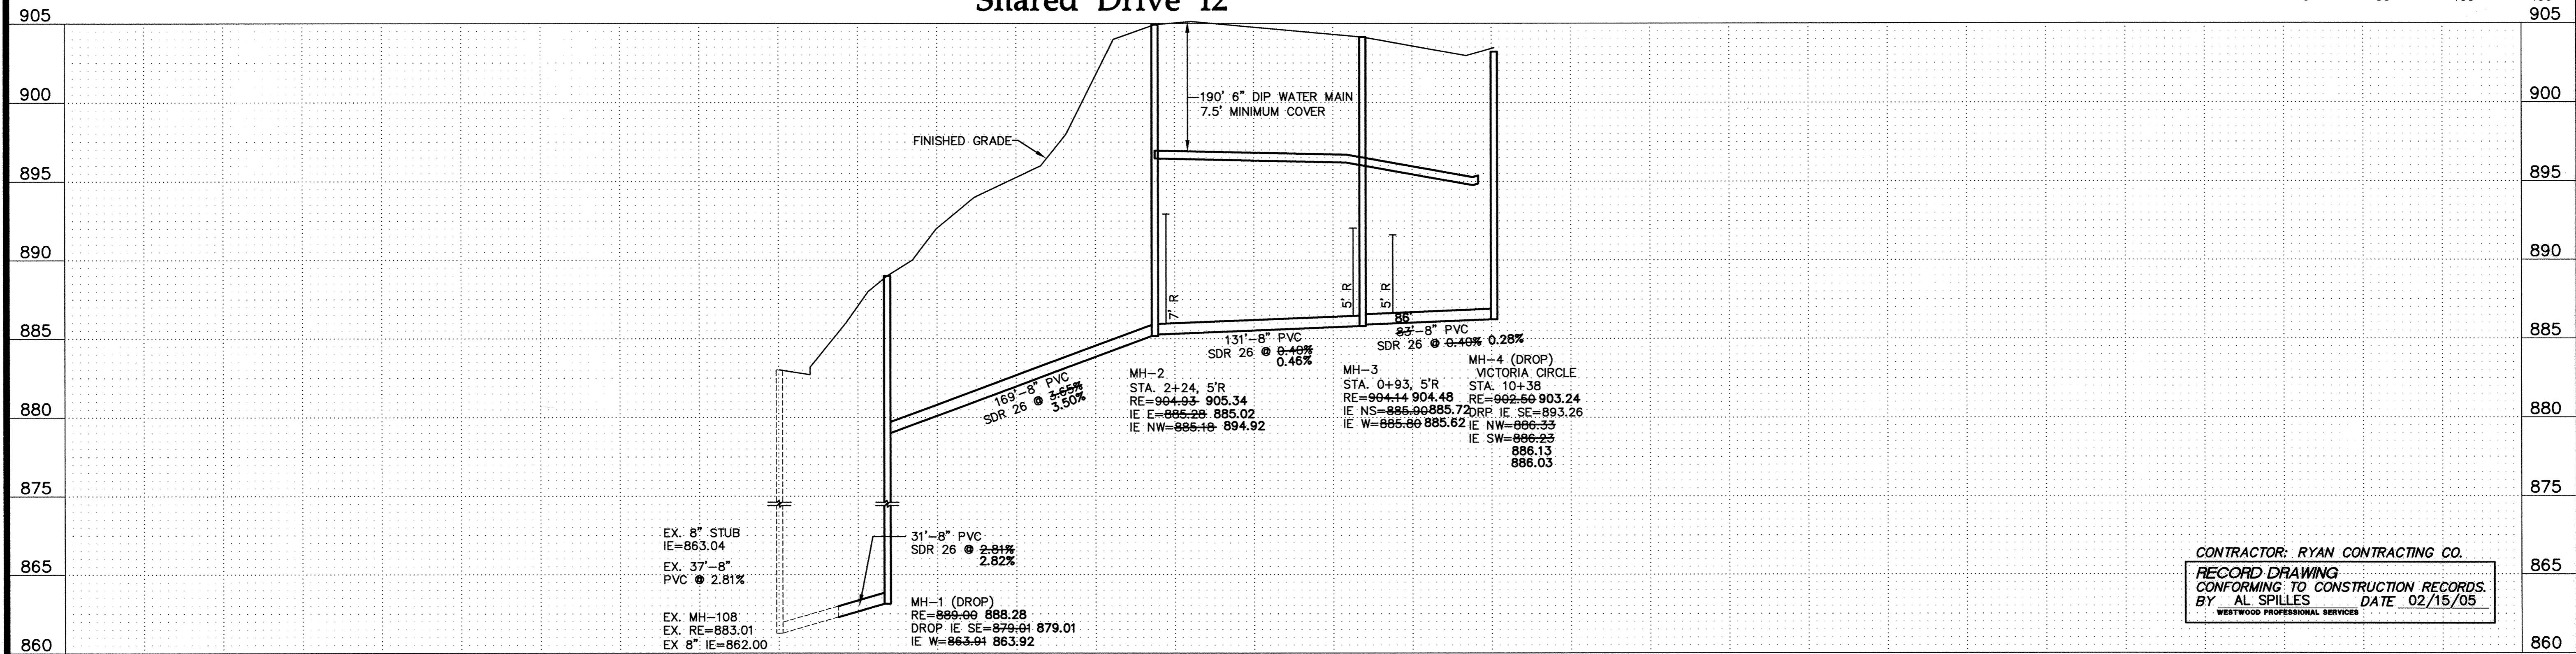
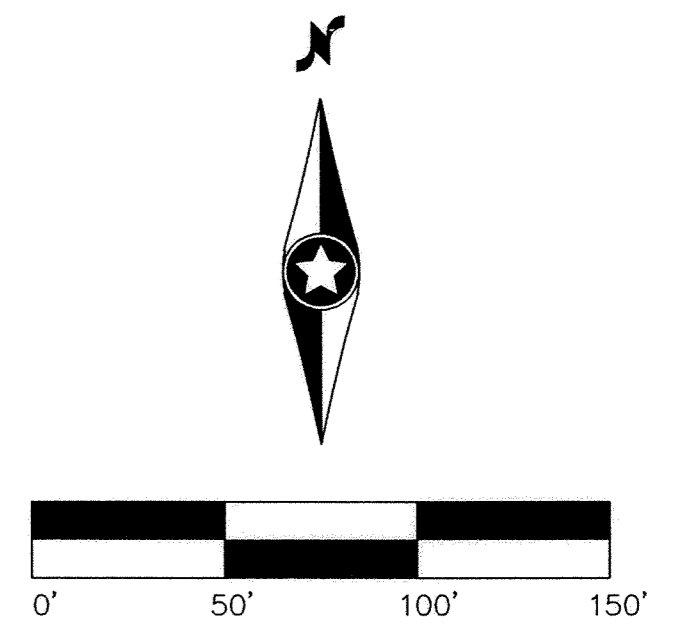


GENERAL NOTES:

- (XXX.X) DENOTES SANITARY SEWER SERVICE INVERT @ TOWNHOME PROPERTY LINE.
- WYE=X+XX DENOTES SANITARY SEWER SERVICE WYE LOCATED ON MAINLINE FROM DOWN STREAM M.H.
- FLAG HYDRANTS.
- EXTEND RODS ON DEEP VALVES.
- ALL DROP MANHOLES TO BE CONSTRUCTED USING OUTSIDE DROPS.
- HYDRANTS TO BE PLACED 5' BEHIND CURB

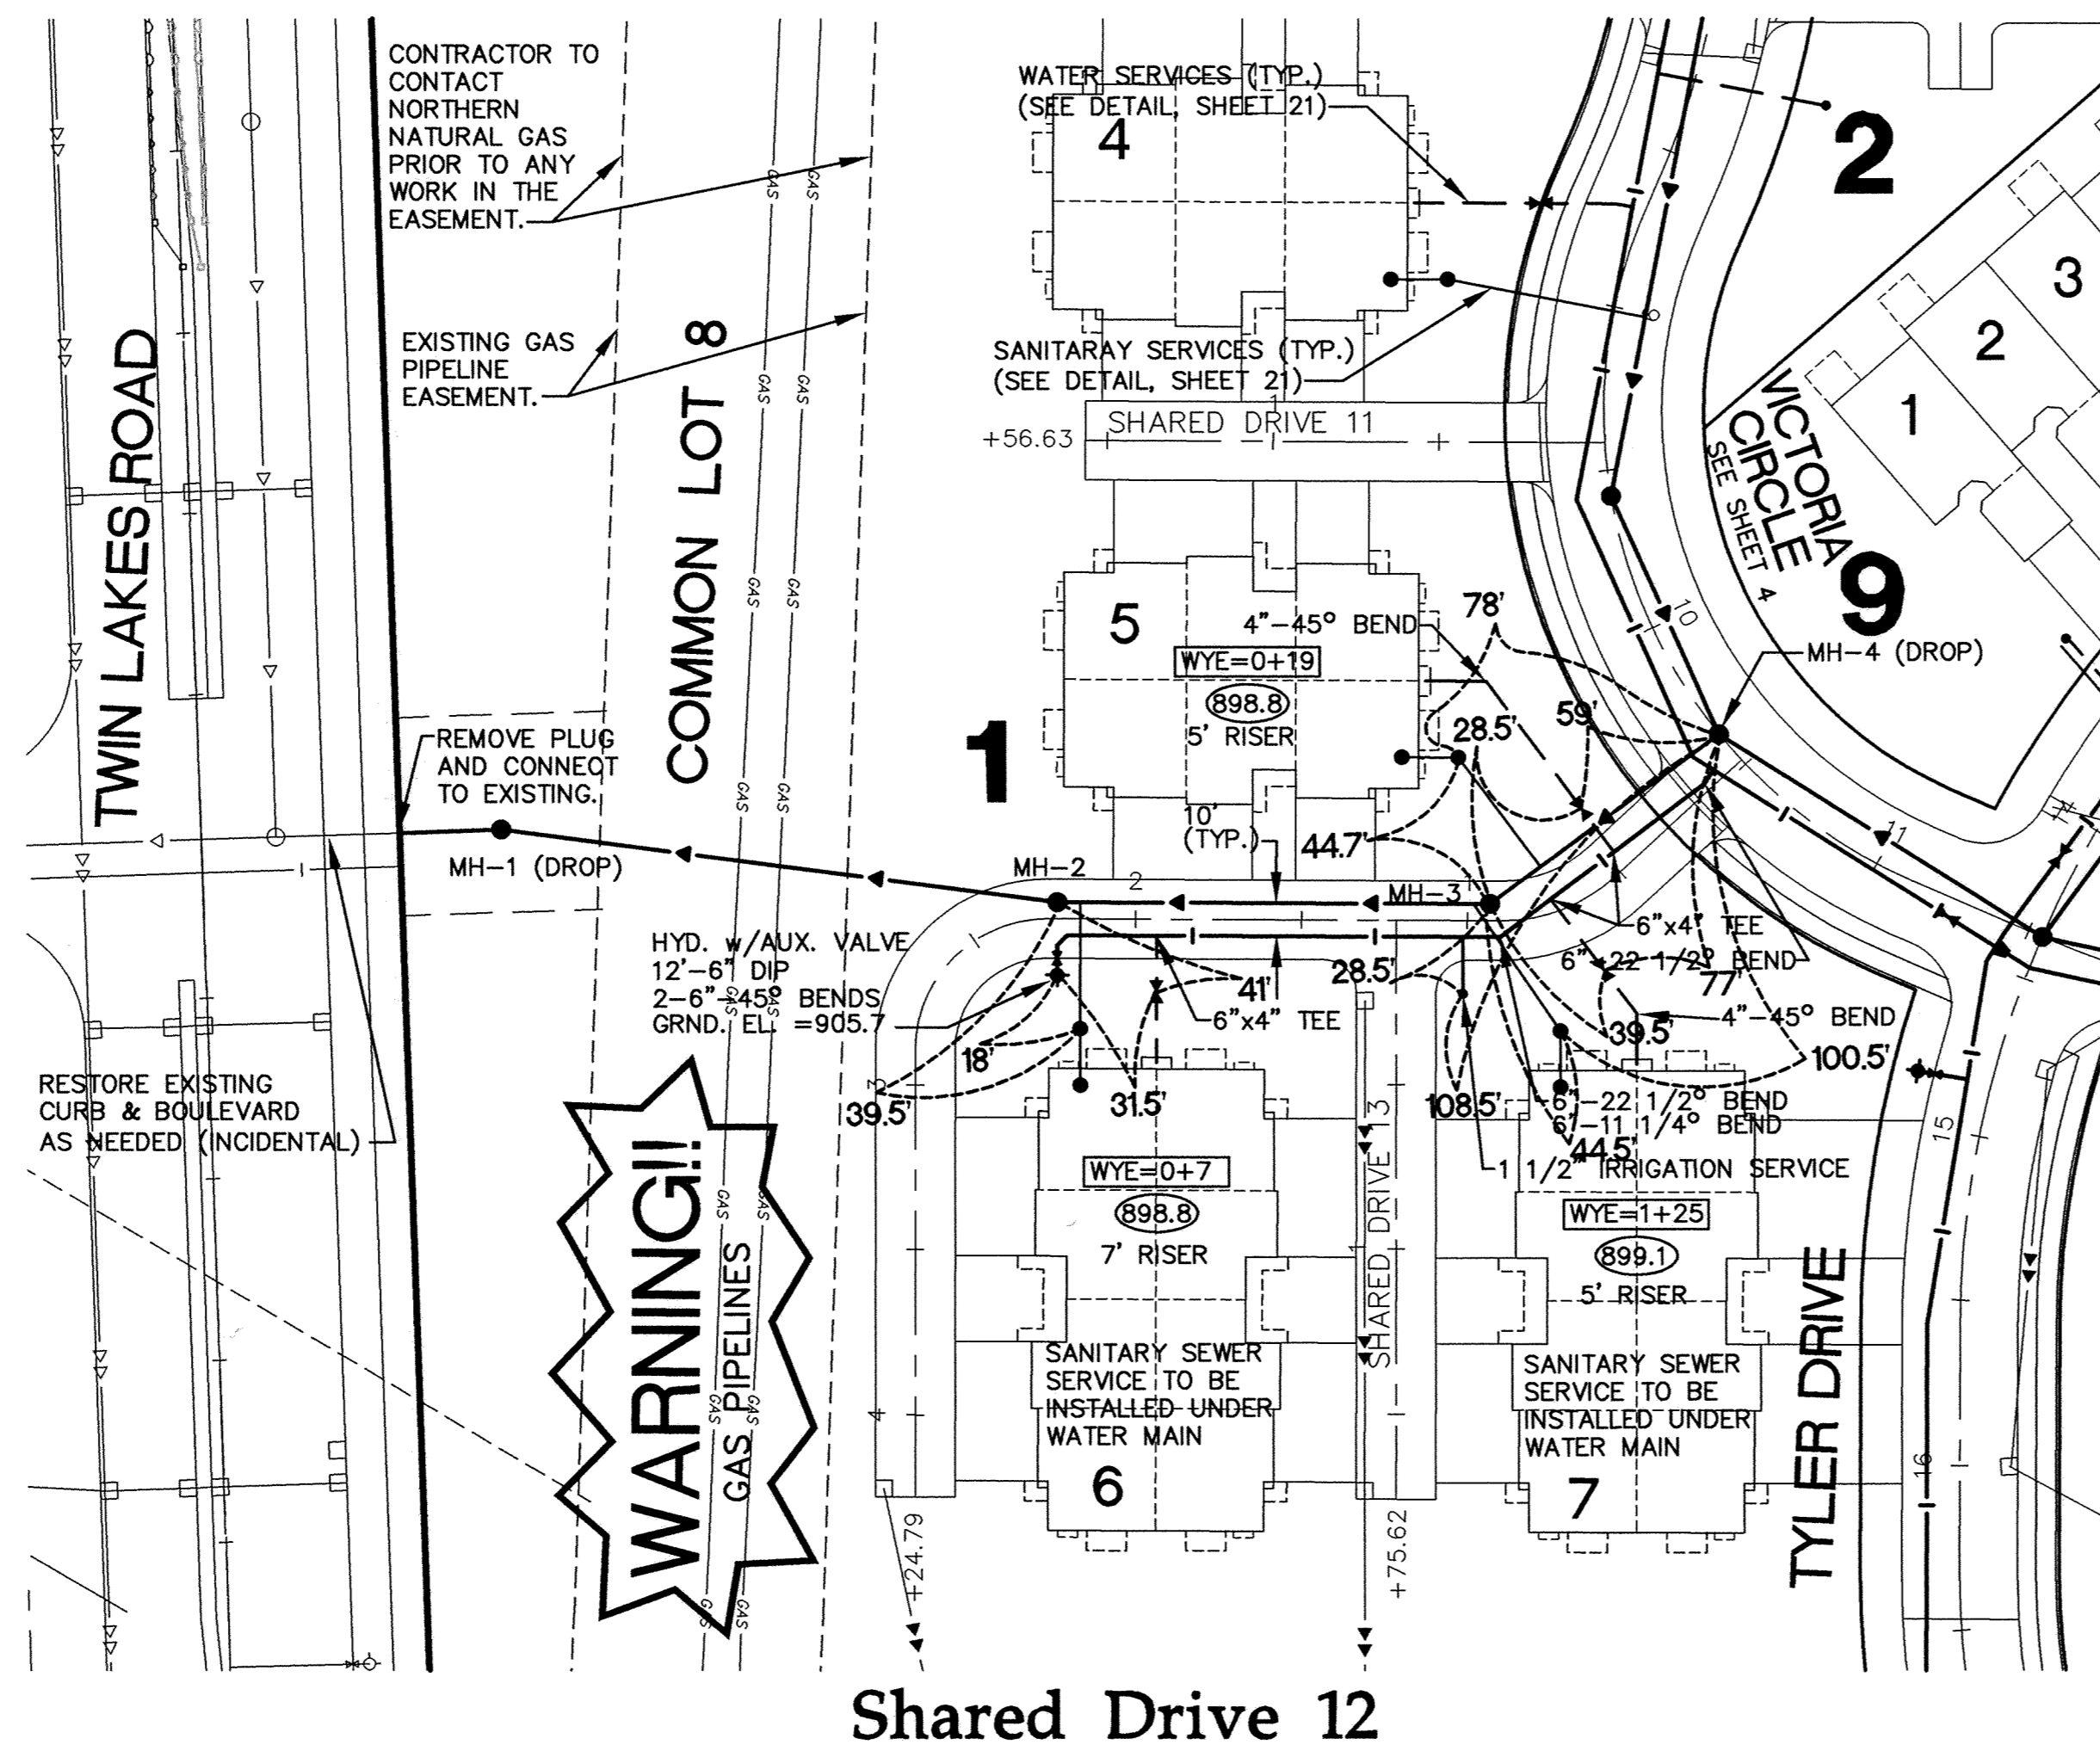

CONTRACTOR: RYAN CONTRACTING CO.
RECORD DRAWING
 CONFORMING TO CONSTRUCTION RECORDS.
 BY AL SPILLES DATE 02/15/05
 WESTWOOD PROFESSIONAL SERVICES

LATEST REVISION DATE: 02/15/05
 E-3 20011034U01.DWG
 Date: 05/28/02 Sheet: 3 OF 21

DRAWING NUMBER
 TROTTS.02
 3
 WESTWOOD PROFESSIONAL SERVICES
 PROJECT: TROTTS.02
 SHEET: 3 OF 21
 DATE: 05/28/02
 DRAWN: WH/RNS
 CHECKED: FDH, II
 DESIGNED: JMM/FDH, II