


REMOVE, SALVAGE AND REINSTALL EXISTING HYDRANT EAST OF CROSS. SALVAGE EXISTING TEE.  
REMOVE PLUG AND CONNECT TO EXISTING 16" WATER MAIN 16"x16" CROSS  
16"x10" REDUCER (WEST OF CROSS)  
10" GATE VALVE (WEST OF CROSS)  
16" PLUG (SOUTH OF CROSS)  
FIELD VERIFY LOCATION.

- GENERAL NOTES:**
- XXX.X DENOTES SANITARY SEWER SERVICE INVERT @ TOWNHOME PROPERTY LINE.
  - WYE=X+XX DENOTES SANITARY SEWER SERVICE WYE LOCATED ON MAINLINE FROM DOWN STREAM M.H.
  - FLAG HYDRANTS.
  - EXTEND RODS ON DEEP VALVES.
  - ALL DROP MANHOLES TO BE CONSTRUCTED USING OUTSIDE DROPS.
  - HYDRANTS TO BE PLACED 5' BEHIND CURB

### C.S.A.H. No. 12

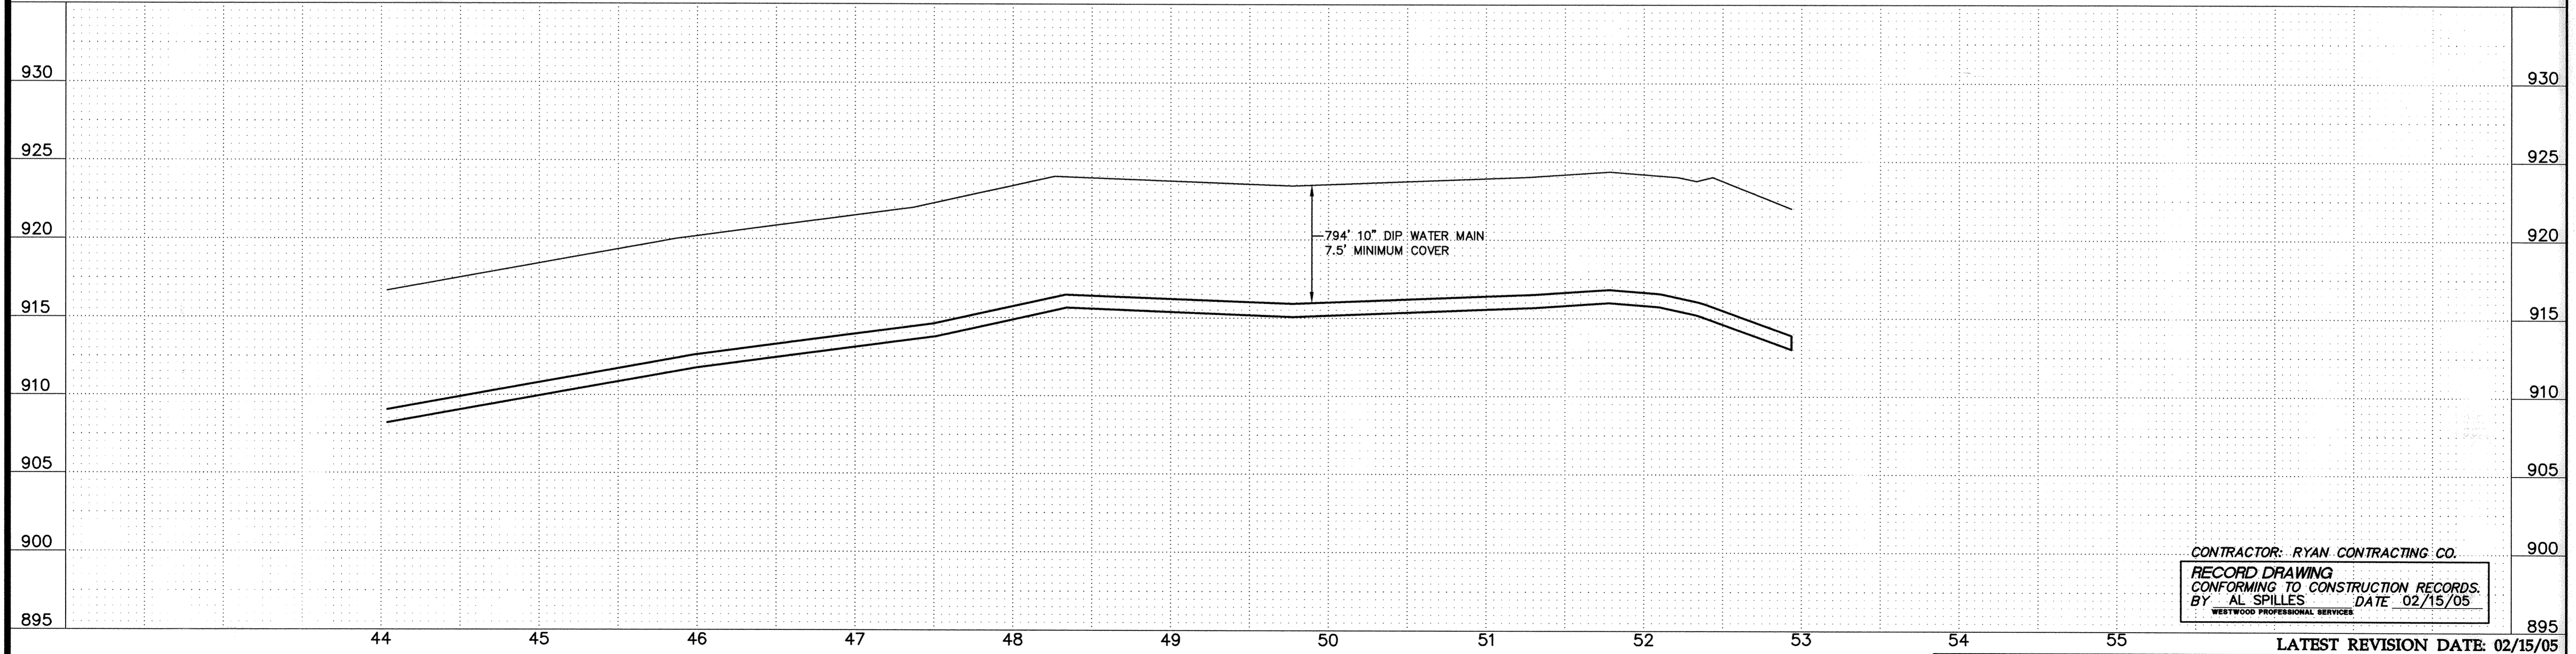

CONTRACTOR: RYAN CONTRACTING CO.  
RECORD DRAWING CONFORMING TO CONSTRUCTION RECORDS.  
BY AL SPILLES DATE 02/15/05  
WESTWOOD PROFESSIONAL SERVICES

LATEST REVISION DATE: 02/15/05  
E-3 20011034UT08.DWG  
Date: 05/28/02 Sheet: 10 OF 21

**Westwood Professional Services, Inc.**  
7599 Anagram Drive  
Eden Prairie, MN 55344  
Phone: 952/937-5150 Fax: 952/937-5822

I hereby certify that this plan was prepared by me or under my direct supervision and that I am a duly licensed PROFESSIONAL ENGINEER under the laws of the State of Minnesota.

*Francis D. Hagen, II*  
Francis D. Hagen, II  
Date: 02/15/05 License No. 17716

Revisions:

06/27/02 City Review-RNS  
08/01/02 Add G.V.'s for Villas-RNS  
06/17/04 RECORD DRAWING (AS/OKB)  
02/15/05 RECORD DRAWING-CITY REVS. (OKB)

Designed: JMM/FDH, II  
Checked: FDH, II  
Drawn: WH/RNS  
Record Drawing by/date: GKR 2/15/05

Prepared for:  
**D. R. Horton, Inc. - Minnesota**  
20860 Kenbridge Court, Suite 100  
Lakeville, Minnesota 55044

**Trott Brook Farms South**  
Elk River, Minnesota

**Water Main Construction Plans**  
C.S.A.H. No. 12 (Sta. 45+00 to Sta. 53+00)

DRAWING NUMBER

DRAWING NUMBER

DRAWING NUMBER

DRAWING NUMBER  
TROTTS.02  
10

P:\20011034.dwg RECDRD\20011034.r486.dwg 2/14/2005 10:02:58 AM CST