


Call 48 Hours before digging:
GOPHER STATE ONE CALL
Twin City Area 651-454-0002
Mn. Toll Free 1-800-252-1166


- GENERAL NOTES:**
- RADIUS TO BE TYPE B618 CURB AND GUTTER WITH 5 FOOT TRANSITION FROM SURMOUNTABLE CURB PER CITY OF ELK RIVER STANDARDS.
 - TYPE B618 CURB & GUTTER SHALL BE CONSTRUCTED AT ALL INTERSECTIONS AND CATCH BASINS.
 - 28.09 = 928.09
 - RADIUS TO BE B618 C. & G. AS PER ELK RIVER DETAIL 2000 (TYP.)
 - STEEL ADJUSTING RINGS SHOULD BE USED FOR MANHOLE ADJUSTMENTS PRIOR TO WEAR COURSE PLACEMENT AND SHOULD BE TYPE R-1979.
 - 11.90 * DENOTES GUTTERLINE ELEVATION AT INTERSECTIONS

CASTING NOTE:

ALL CATCH BASIN CASTINGS IN CURB SHALL BE SUMPED 0.10 FEET AND MANHOLE CASTINGS IN PAVED AREAS SHALL BE SUMPED 0.05 FEET. RIM ELEVATIONS ON PLAN PROFILES REFLECT THE SUMPED ELEVATIONS.

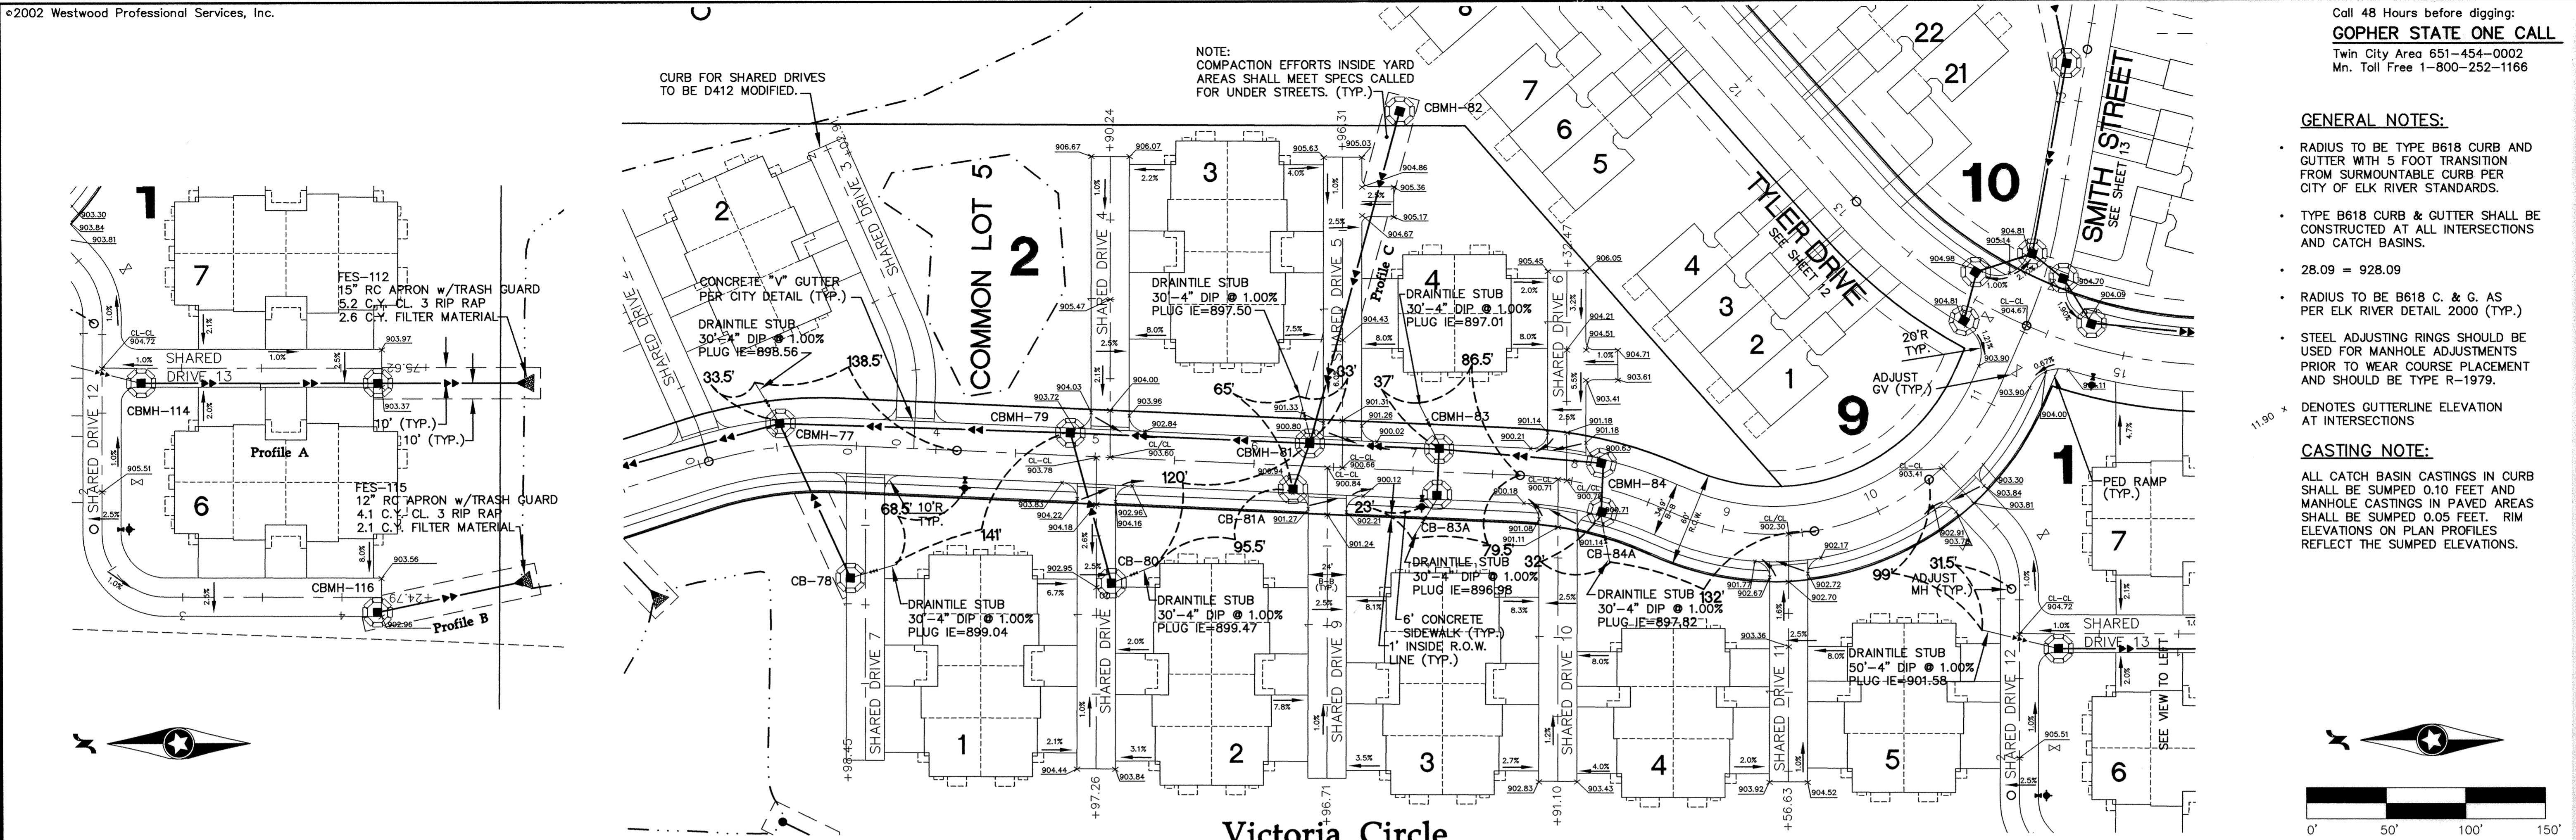

Victoria Circle

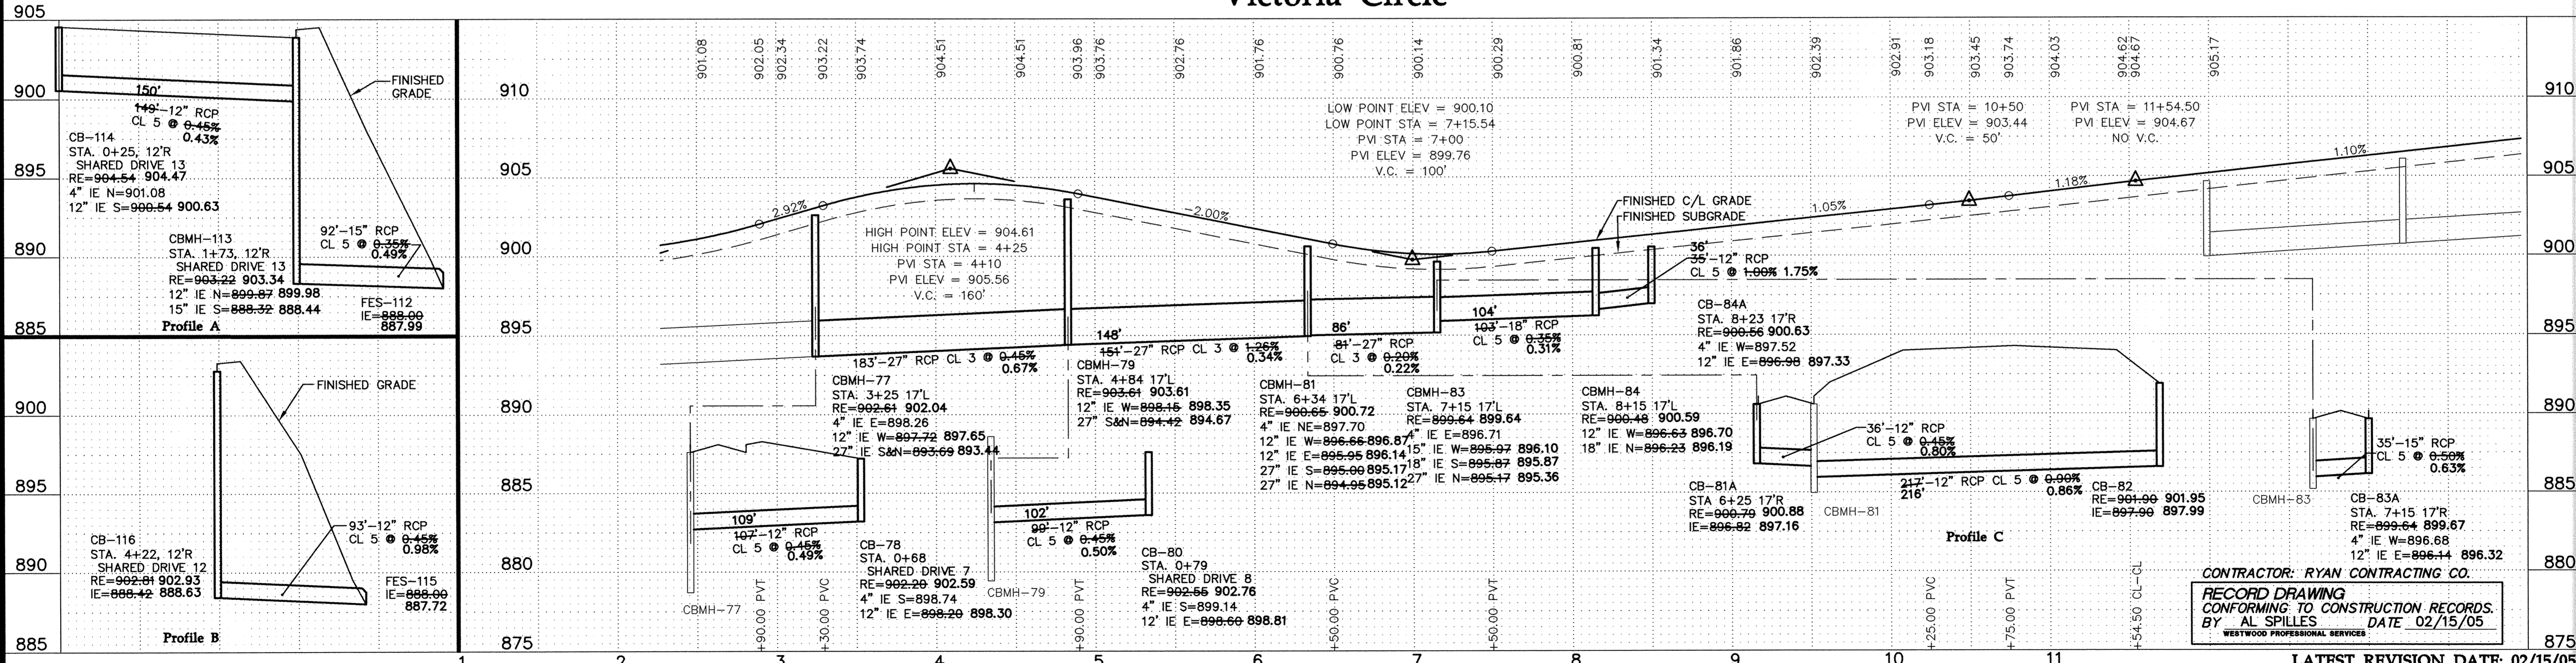

CONTRACTOR: RYAN CONTRACTING CO.
RECORD DRAWING CONFORMING TO CONSTRUCTION RECORDS.
BY AL SPILLES DATE 02/15/05
WESTWOOD PROFESSIONAL SERVICES

LATEST REVISION DATE: 02/15/05
E-3 200110345T84.DWG
Date: 05/28/02 Sheet: 14 OF 21

Westwood Professional Services, Inc.
7599 Anagram Drive
Eden Prairie, MN 55344
Phone: 952/937-5150 Fax: 952/937-5822

I hereby certify that this plan was prepared by me or under my direct supervision and that I am a duly licensed PROFESSIONAL ENGINEER under the laws of the State of Minnesota.
Francis D. Hagen, II
Francis D. Hagen, II
Date: 02/15/05 License No. 17716

Revisions:
06/27/02 City Review-RMS
08/01/02 Add G.V.'s for Villous-RMS
02/06/03 Revise Grades NE Area-CLJ
06/17/04 RECORD DRAWING (AS/2X8)
02/15/05 RECORD DRAWING-CITY REVS. (GKB)

Designed: JMM/FDH, II
Checked: FDH, II
Drawn: WH/RNS
Record Drawing by/dtate: GKB 2/15/05

Prepared for:
D. R. Horton, Inc. - Minnesota
20860 Kenbridge Court, Suite 100
Lakeville, Minnesota 55044

Trott Brook Farms South
Elk River, Minnesota

Storm Sewer and Street Construction Plans
Victoria Circle (Sta. 3+25 to Sta. 11+54.50)