
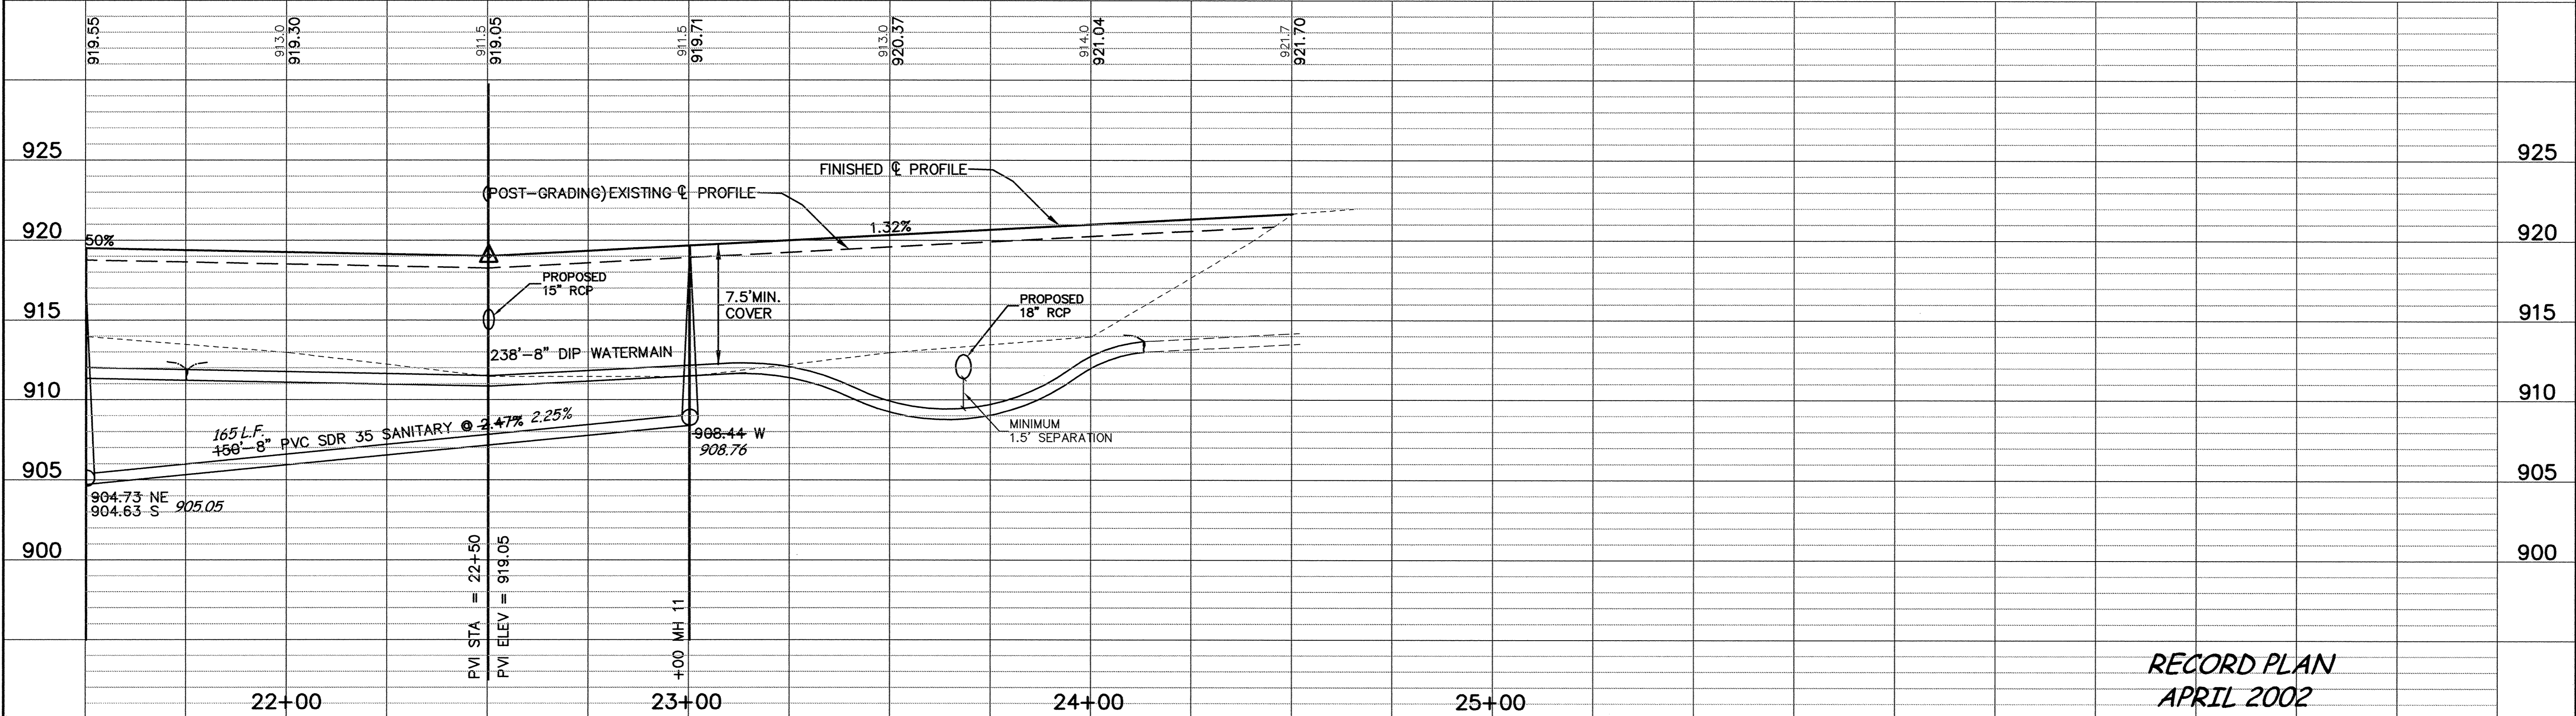
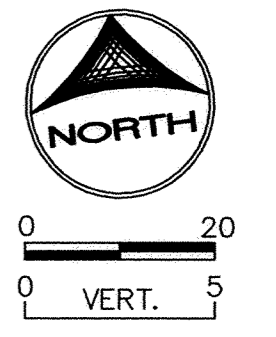


6TH AVENUE

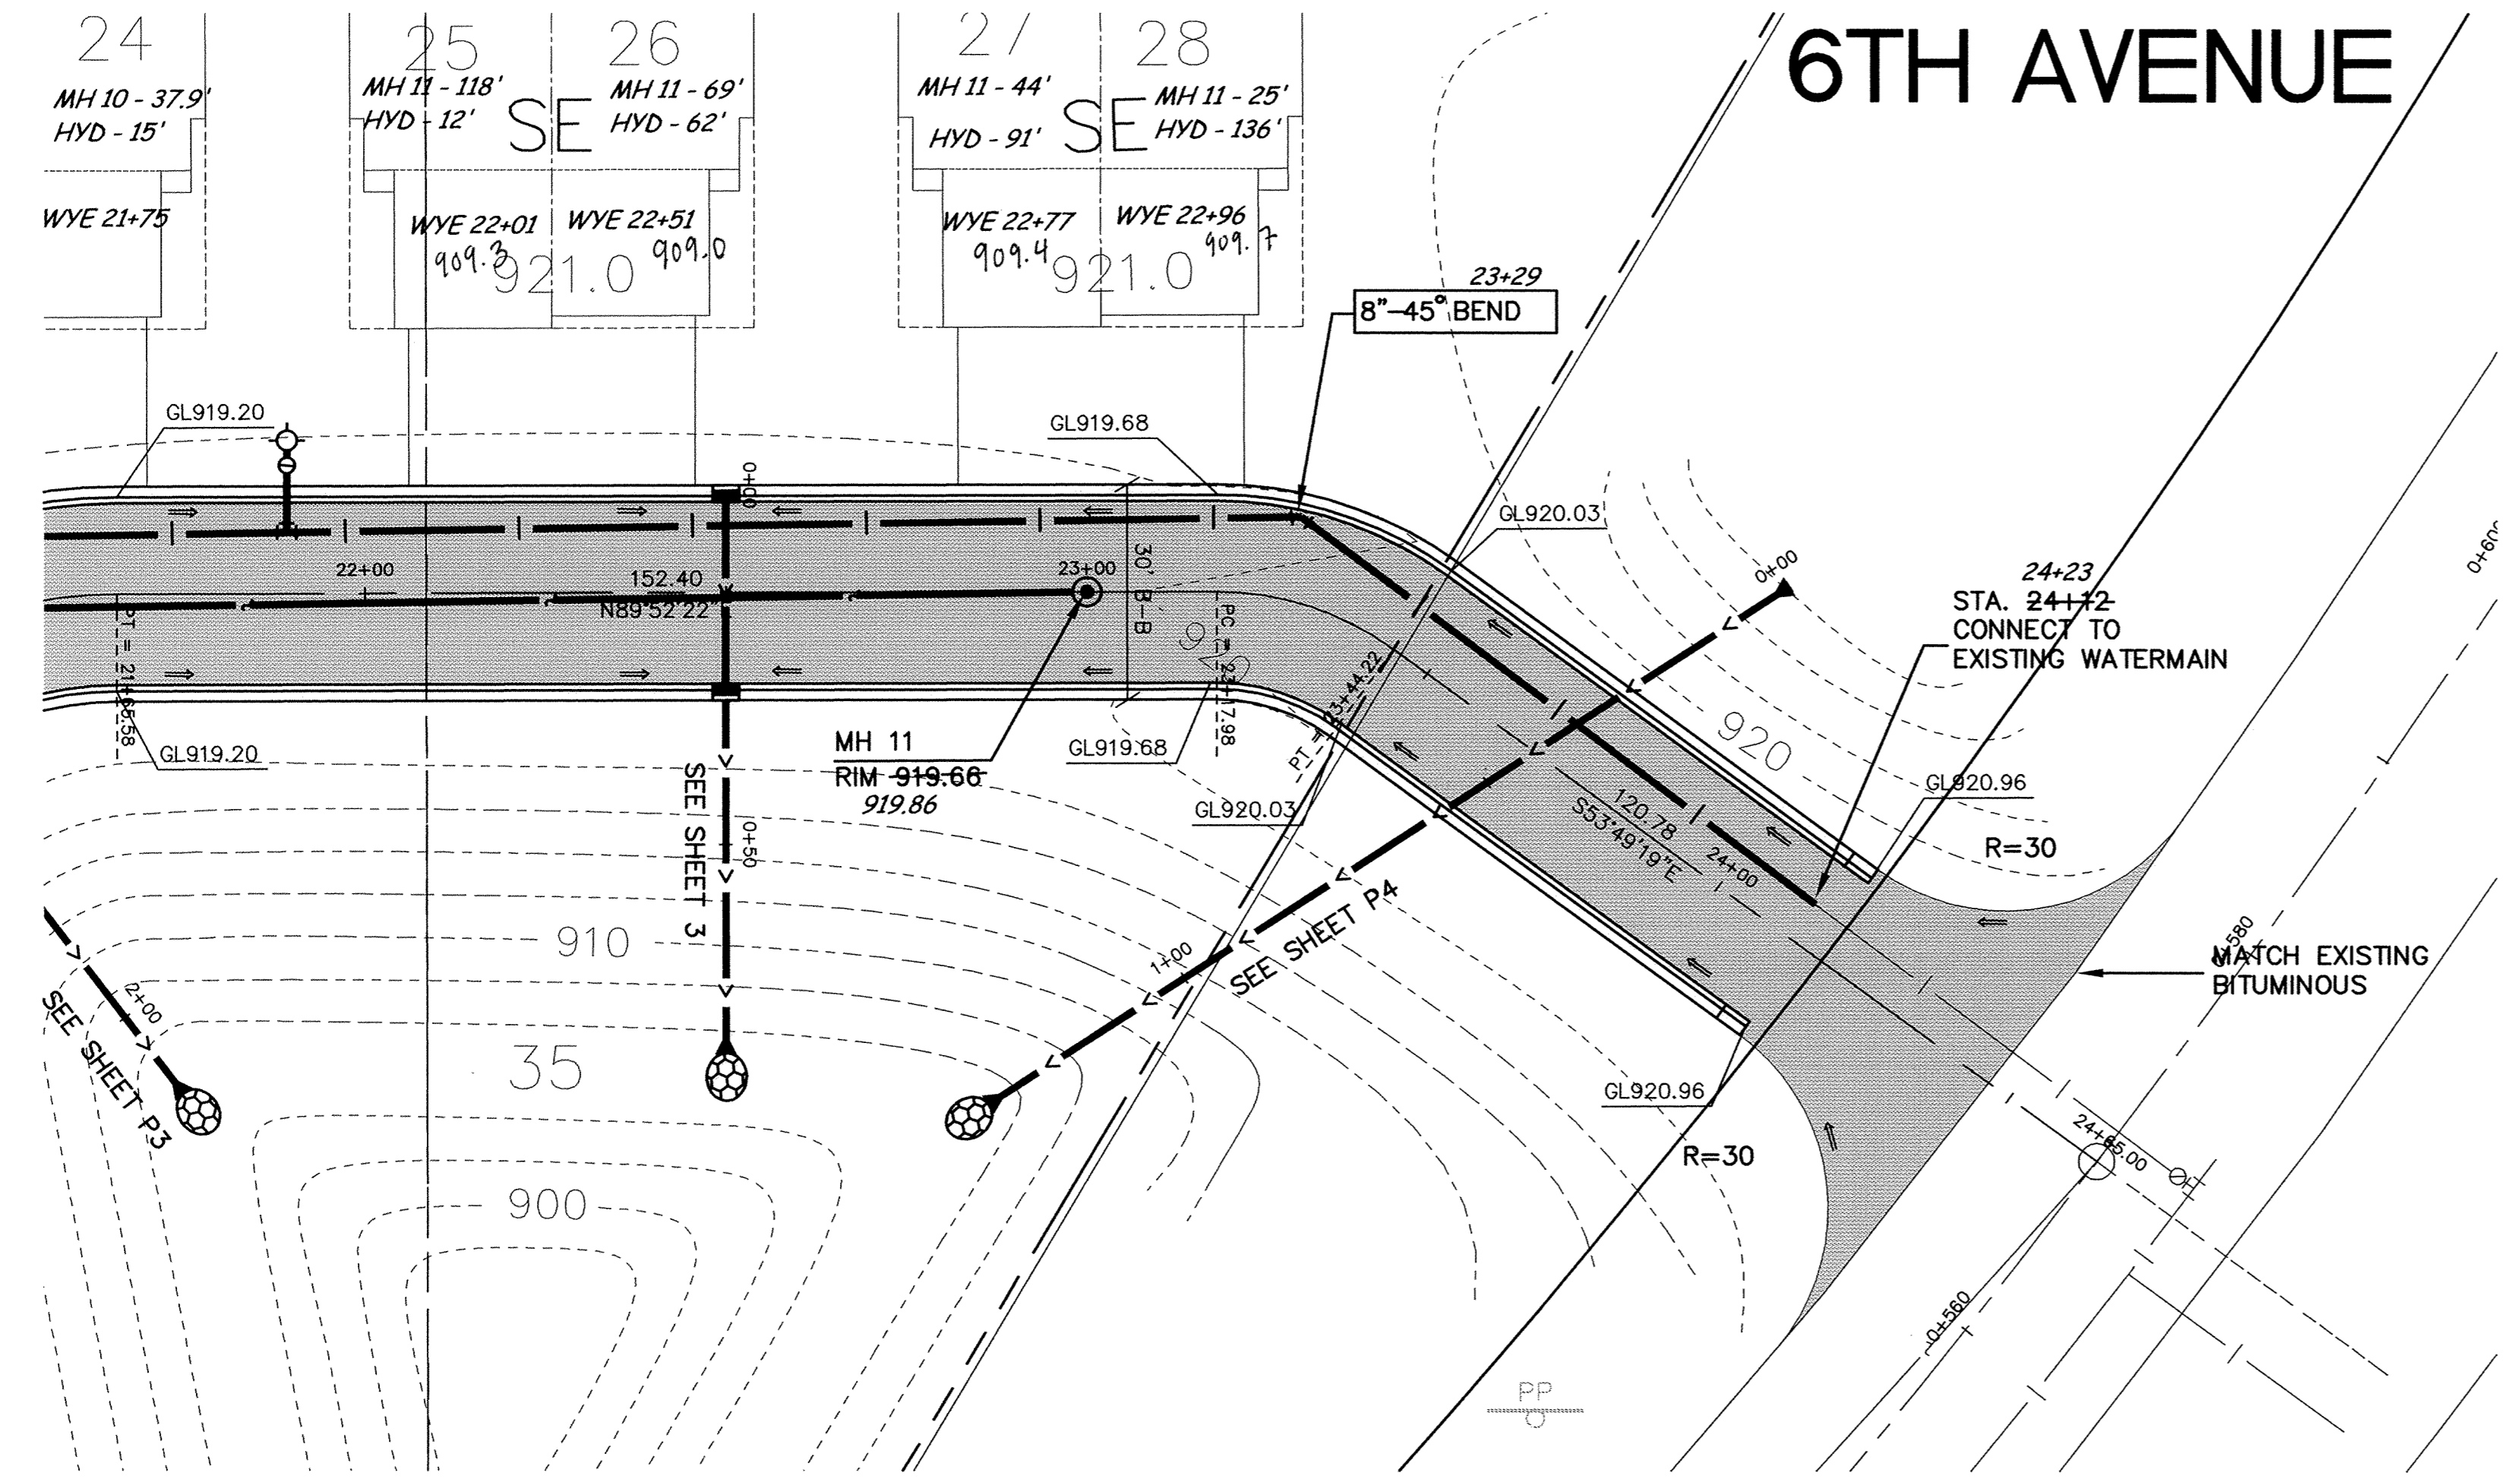

RECORD PLAN
APRIL 2002

DESIGNED BY: TJM DRAWN BY: RKM
 APPROVED BY: TJM JOB NUMBER: 809781J
 CAD DATE: April 03, 2002 1:29:33 p.m.
 CAD FILE: 809783J\Phase III-Asbuilts\809783-P2.DWG

I HEREBY CERTIFY THAT THIS PLAN, SPECIFICATION,
 OR REPORT WAS PREPARED BY ME OR UNDER MY DIRECT
 SUPERVISION AND THAT I AM A DULY REGISTERED
 PROFESSIONAL ENGINEER UNDER THE LAWS OF THE
 STATE OF MINNESOTA.
 DATE: _____ REG. NO. _____

NO.	DATE	BY	REVISION DESCRIPTION
1	8/23/01	EY	PER CITY REVIEW

1326 ENERGY PARK DRIVE
 ST. PAUL, MINNESOTA 55108
 (651) 644-4389

Howard R. Green Company
 CONSULTING ENGINEERS

CITY OF ELK RIVER
 TWIN LAKES TOWNHOMES 3RD ADDITION
 STREET AND UTILITY IMPROVEMENTS

6TH AVENUE
 PLAN AND PROFILE
 21+75 TO 25+00

SHEET NO.
P2