



SARGO PRODUCTS • NEW HOPE, MINNESOTA
REGISTERED BY PROFESSIONAL ENGINEERS

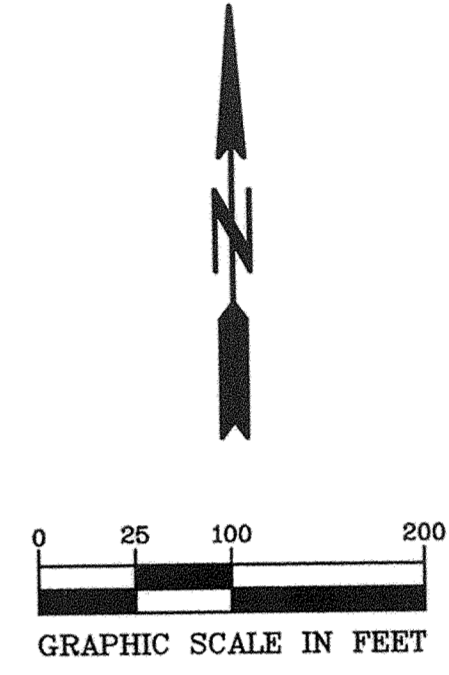

BENCH MARKS
CAST IRON MONUMENT: NORTHEAST CORNER
OF SEC. 35, TWP. 33, RNG. 26.
ELEVATION = 904.80

CAST IRON MONUMENT: NORTH QUARTER
CORNER OF SEC. 35, TWP. 33, RNG. 26.
ELEVATION = 935.67

RECORD PLAN 2005
CONTRACTOR
RYAN CONTRACTING
8700 13TH AVE.
SHAKOPEE, MN
(952) 894-3200

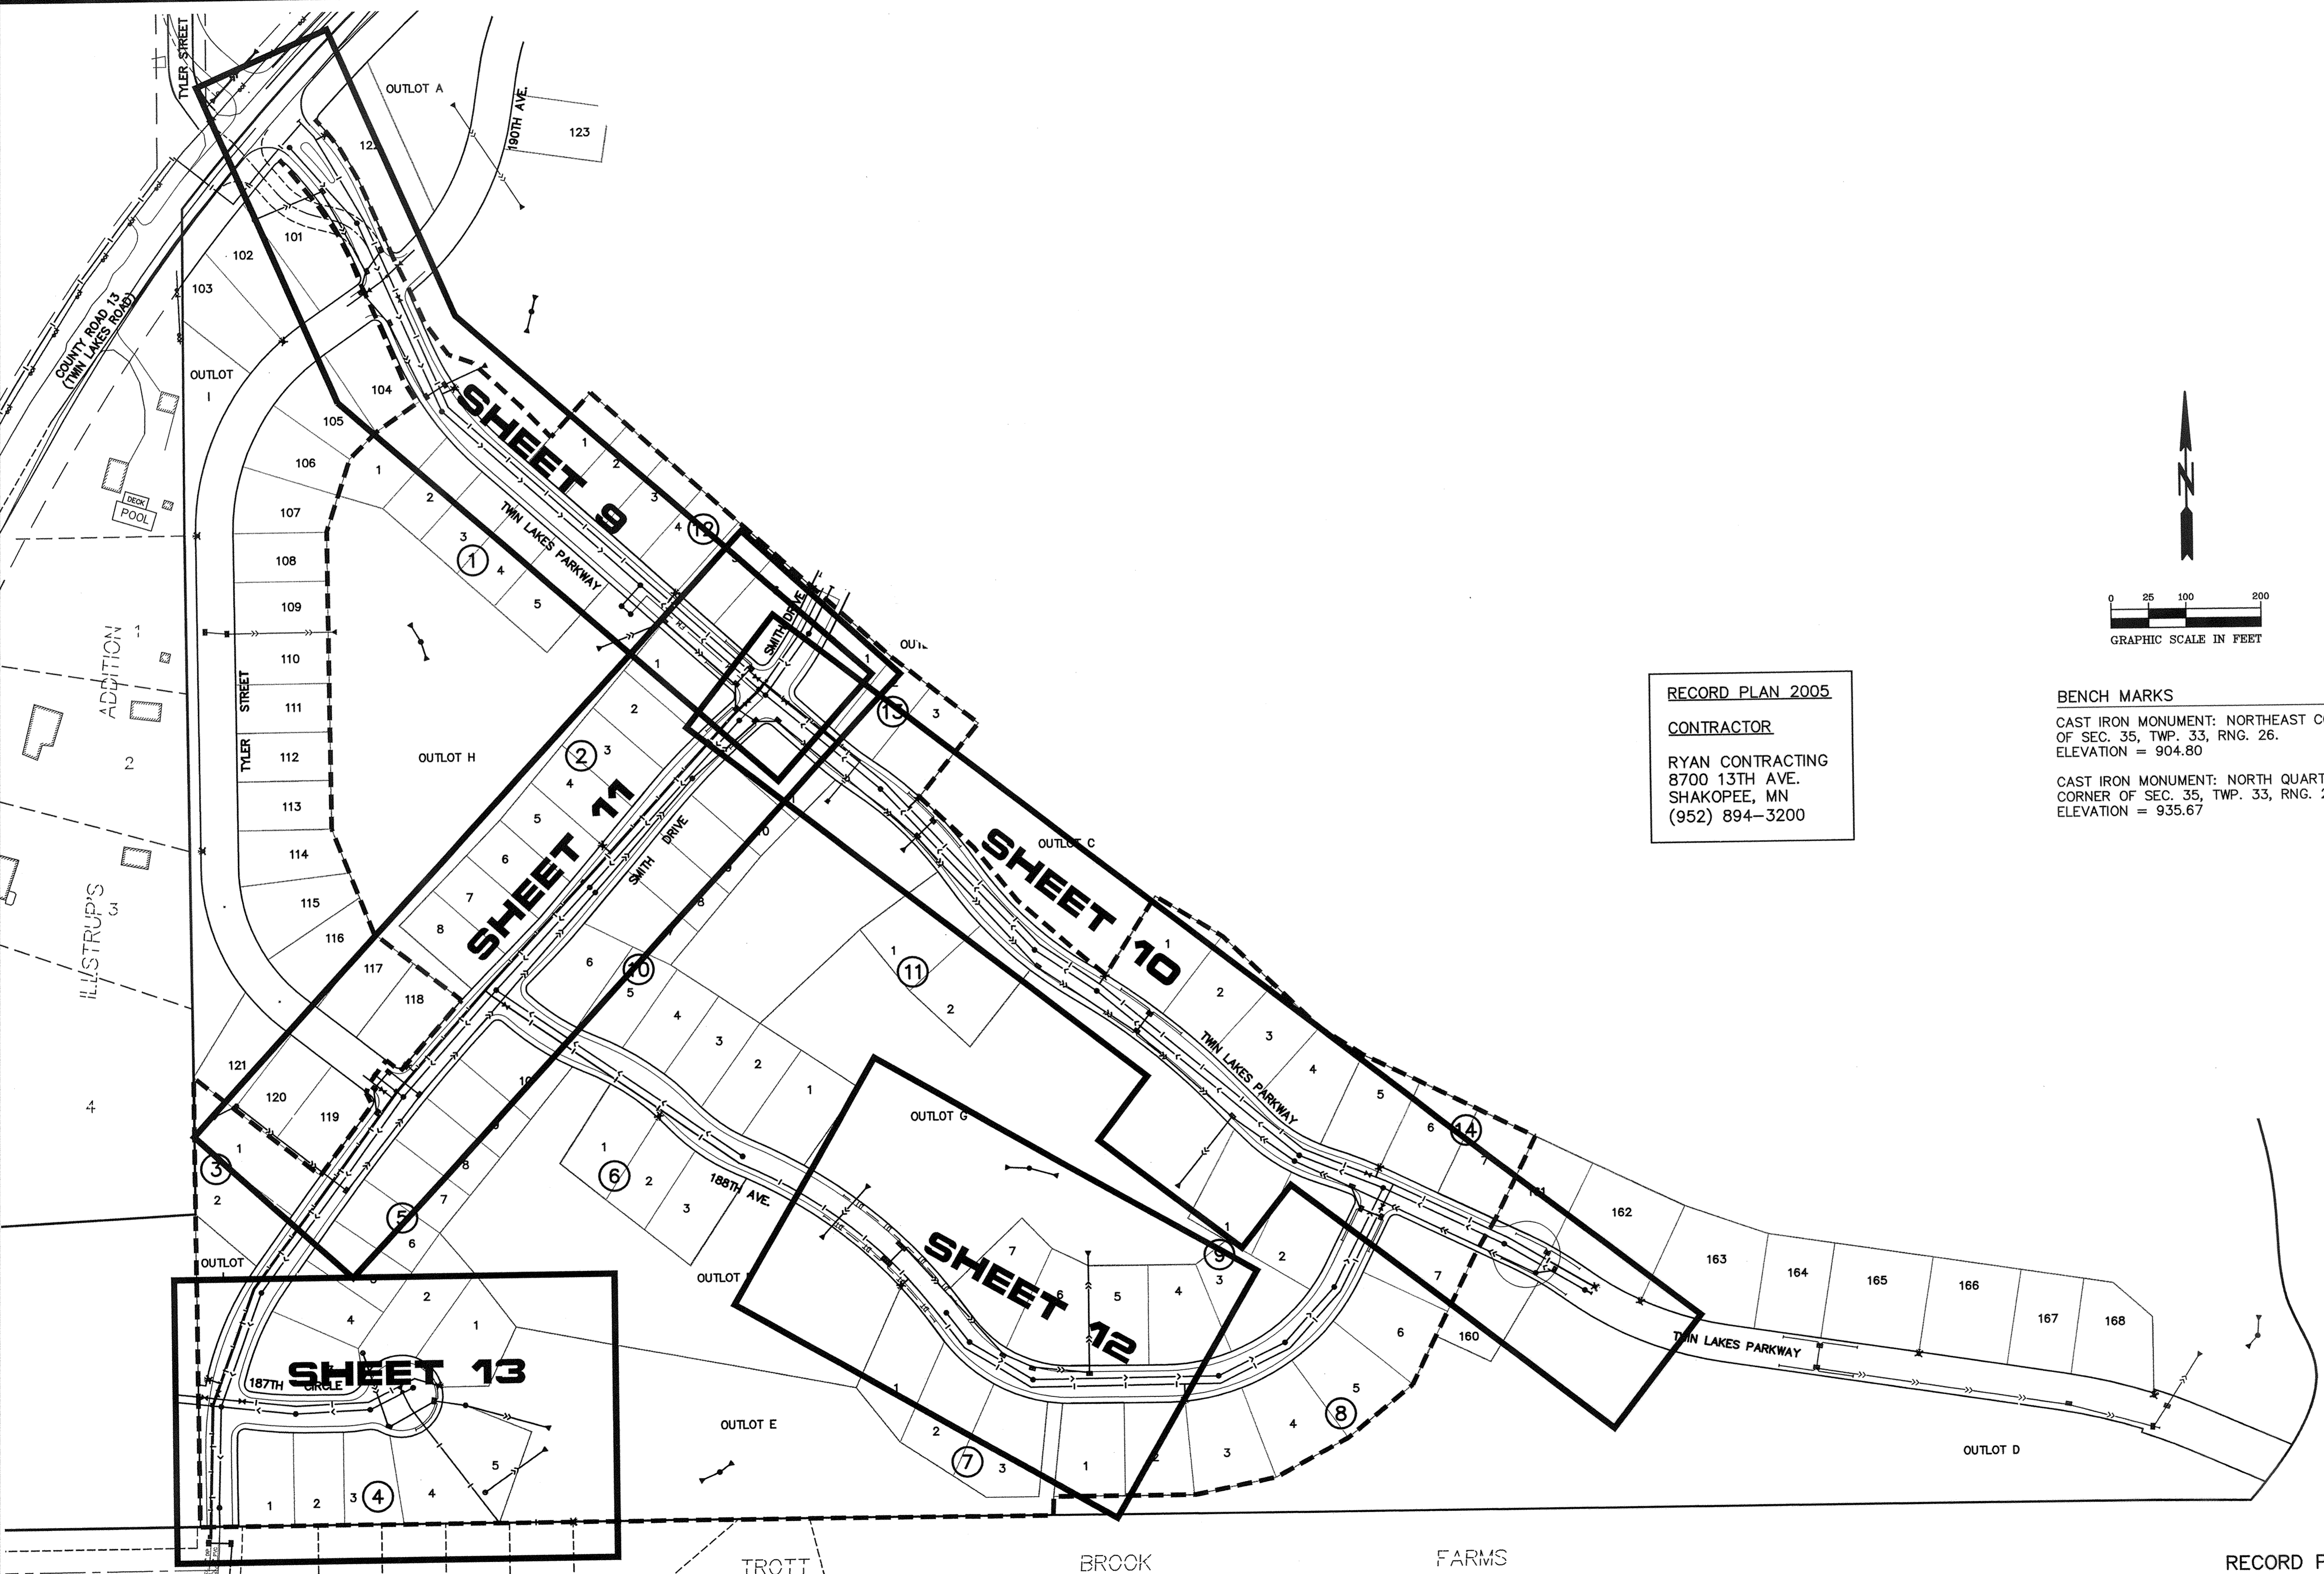

RECORD PLAN 2005

PIONEER engineering
201 85th Avenue NW
Coon Rapids, MN 55433
(763) 783-1800 FAX: 783-1883
2422 Enterprise Drive
Minnetonka, MN 55312
(952) 681-1814 FAX: 681-9488

I hereby certify that this plan was prepared by me or under my direct supervision and that I am a duly Licensed Professional Engineer under the laws of the State of Minnesota.

Name: *Paul J. Chene*
Reg. No. 19860 Date 7/16/04

2. AS-BUILT
1. STREET NAMES
Revisions
1. 3/10/04
2. XX/XX/XX

Date 7/16/04
Designed BJK
Drawn

SHEET TITLE

STORM SEWER INDEX

OWNER RYAN CONTRACTING CO.
8700 13TH AVENUE EAST
SHAKOPEE, MINNESOTA 55379

PROJECT TWIN LAKES ESTATES
ELK RIVER

SHEET 3 OF 24 SHEETS