
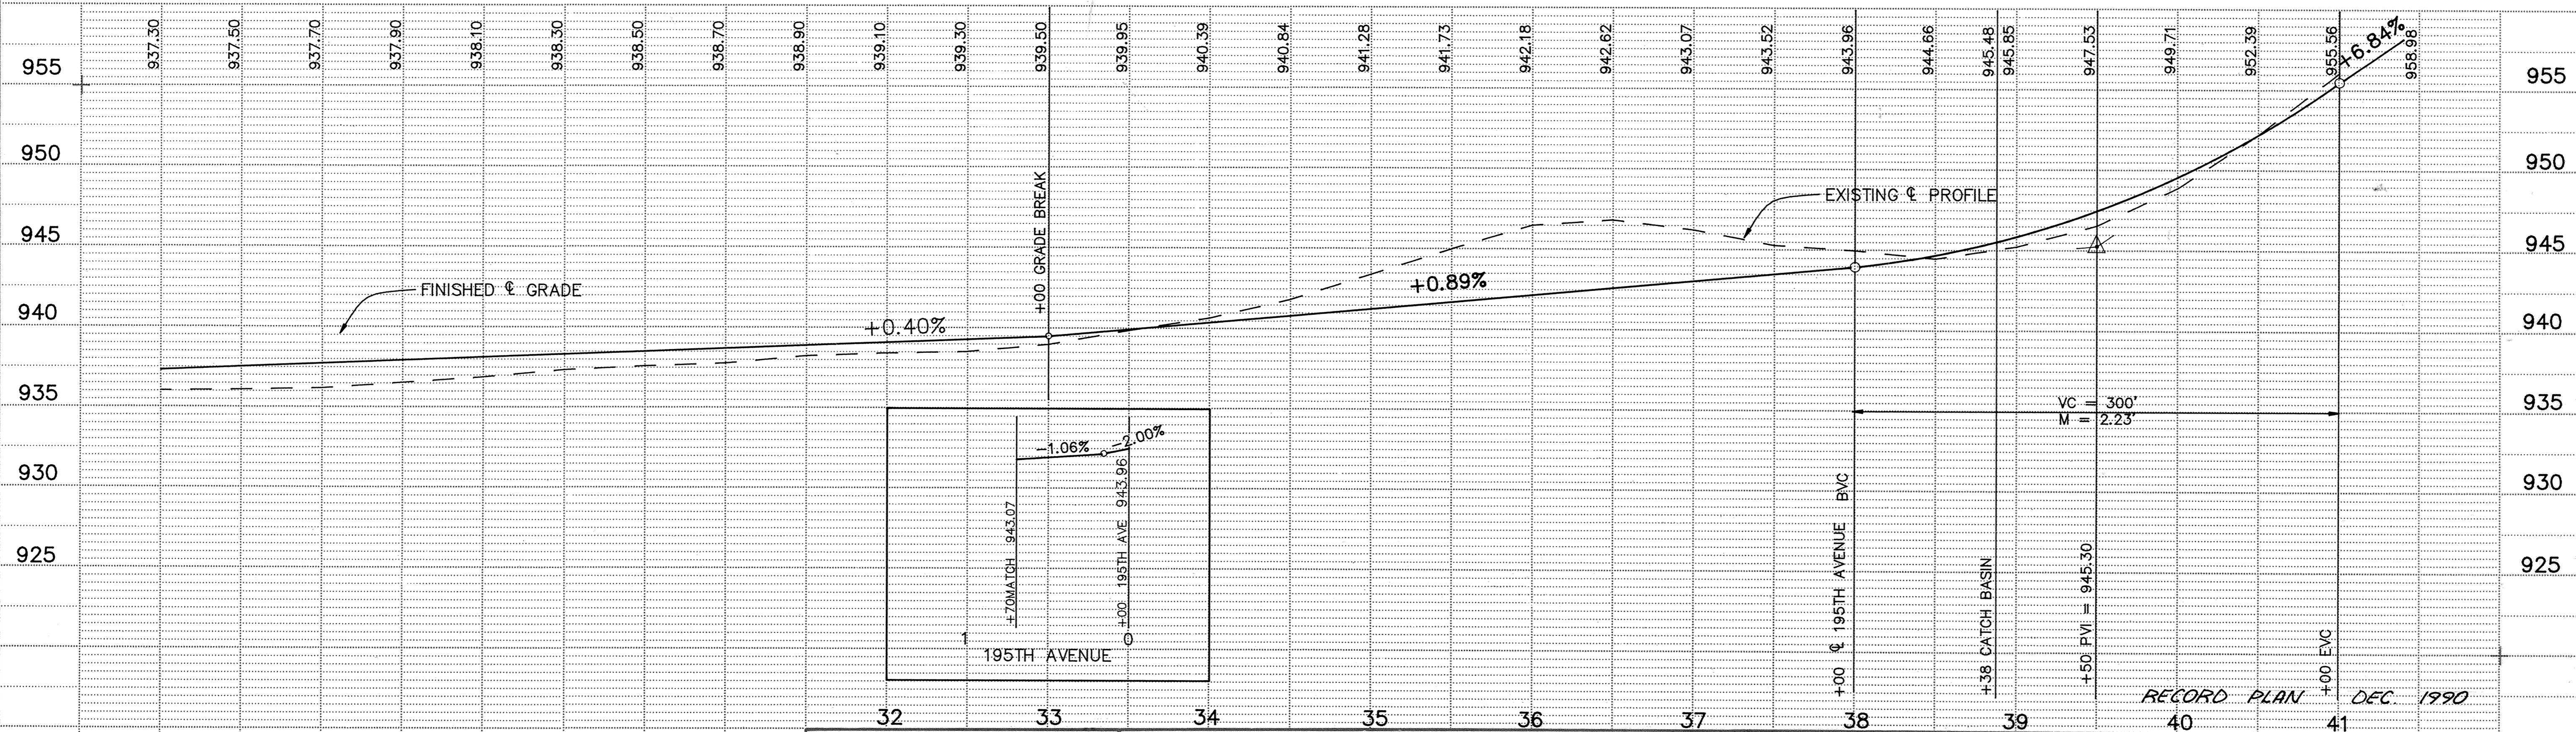


# TYLER STREET

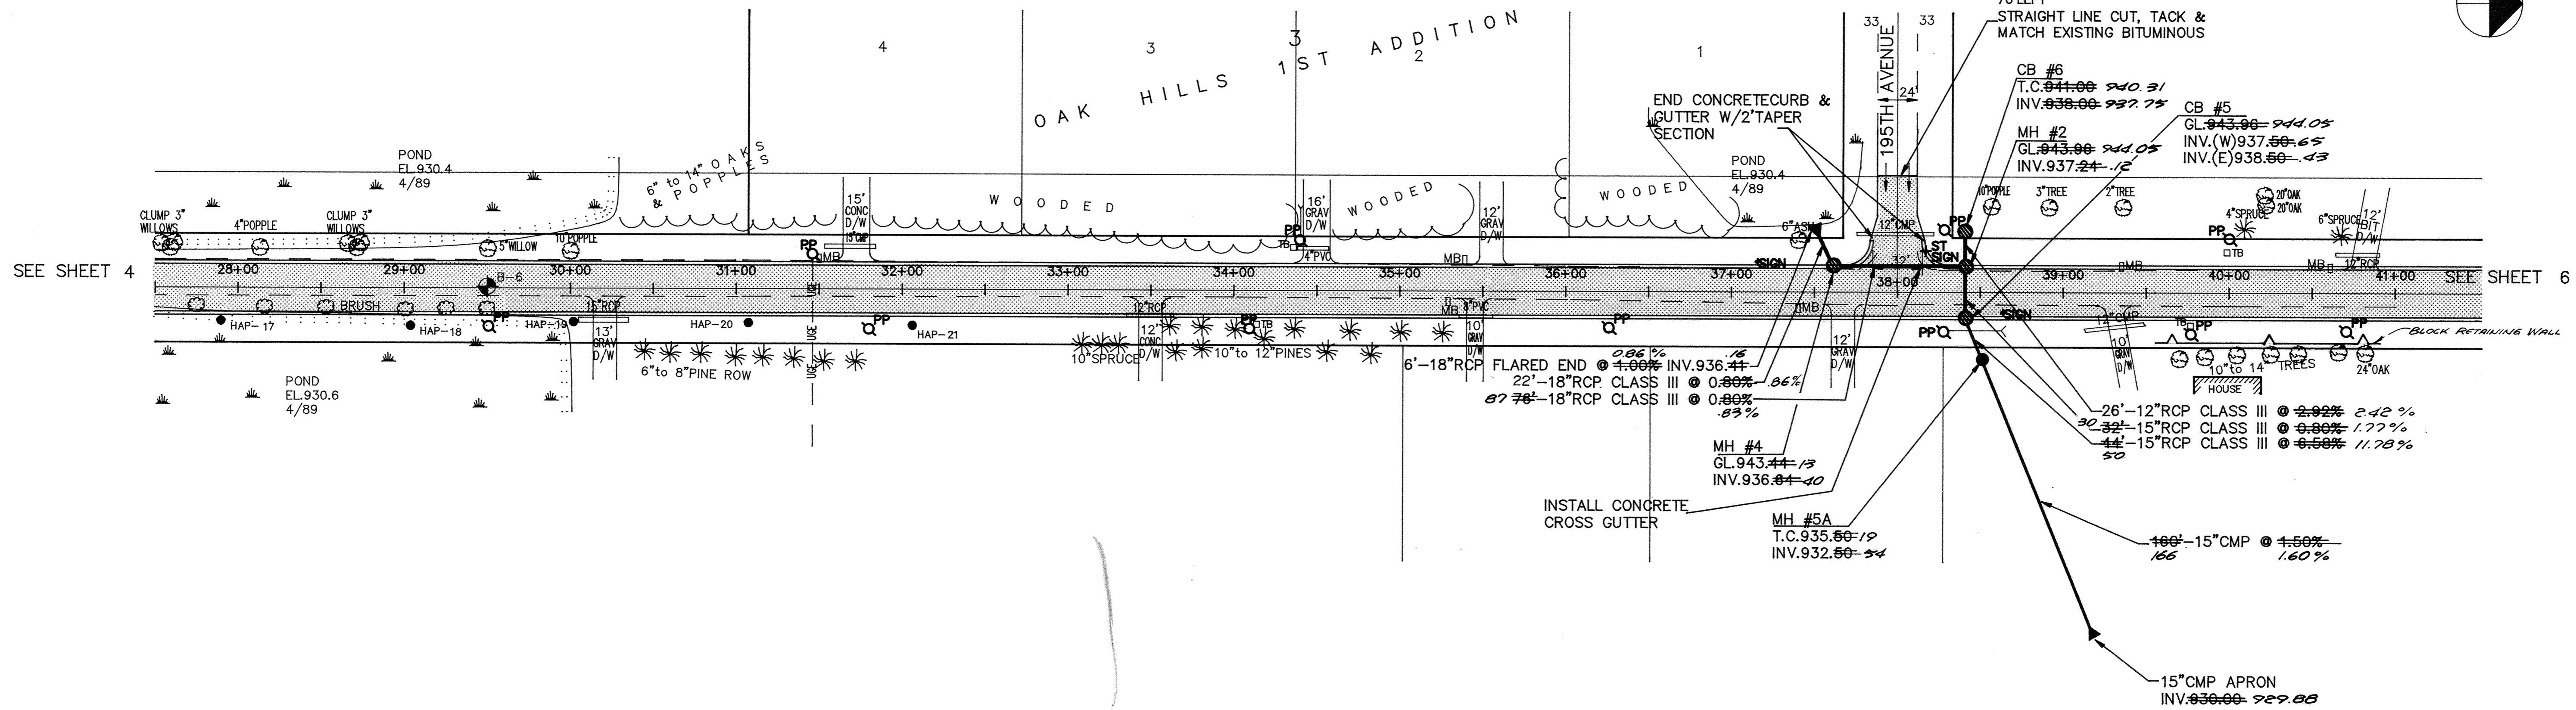

I HEREBY CERTIFY THAT THIS PLAN, SPECIFICATION, OR REPORT WAS PREPARED BY ME OR UNDER MY DIRECT SUPERVISION AND THAT I AM A DULY REGISTERED PROFESSIONAL ENGINEER UNDER THE LAWS OF THE STATE OF MINNESOTA.

**Maier Stewart & Associates Inc.**  
CONSULTING ENGINEERS

1959 SLOAN PLACE (612) 774-6021 ST. PAUL, MINNESOTA 55117

DATE	DESCRIPTION	DESIGNED
7/5/89	STREET GRADES	CHECKED
		DRAWN
		GRAPHIC SCALE
		0' HORIZ. 50'
		0' VERT. 5'

CITY OF ELK RIVER	
STREET IMPROVEMENTS	
TYLER STREET	
DATE JAN, 1989	SHEET 5 OF 22 SHEETS
PROJECT NO. 230-063	

DATE \_\_\_\_\_ REG. NO. \_\_\_\_\_