
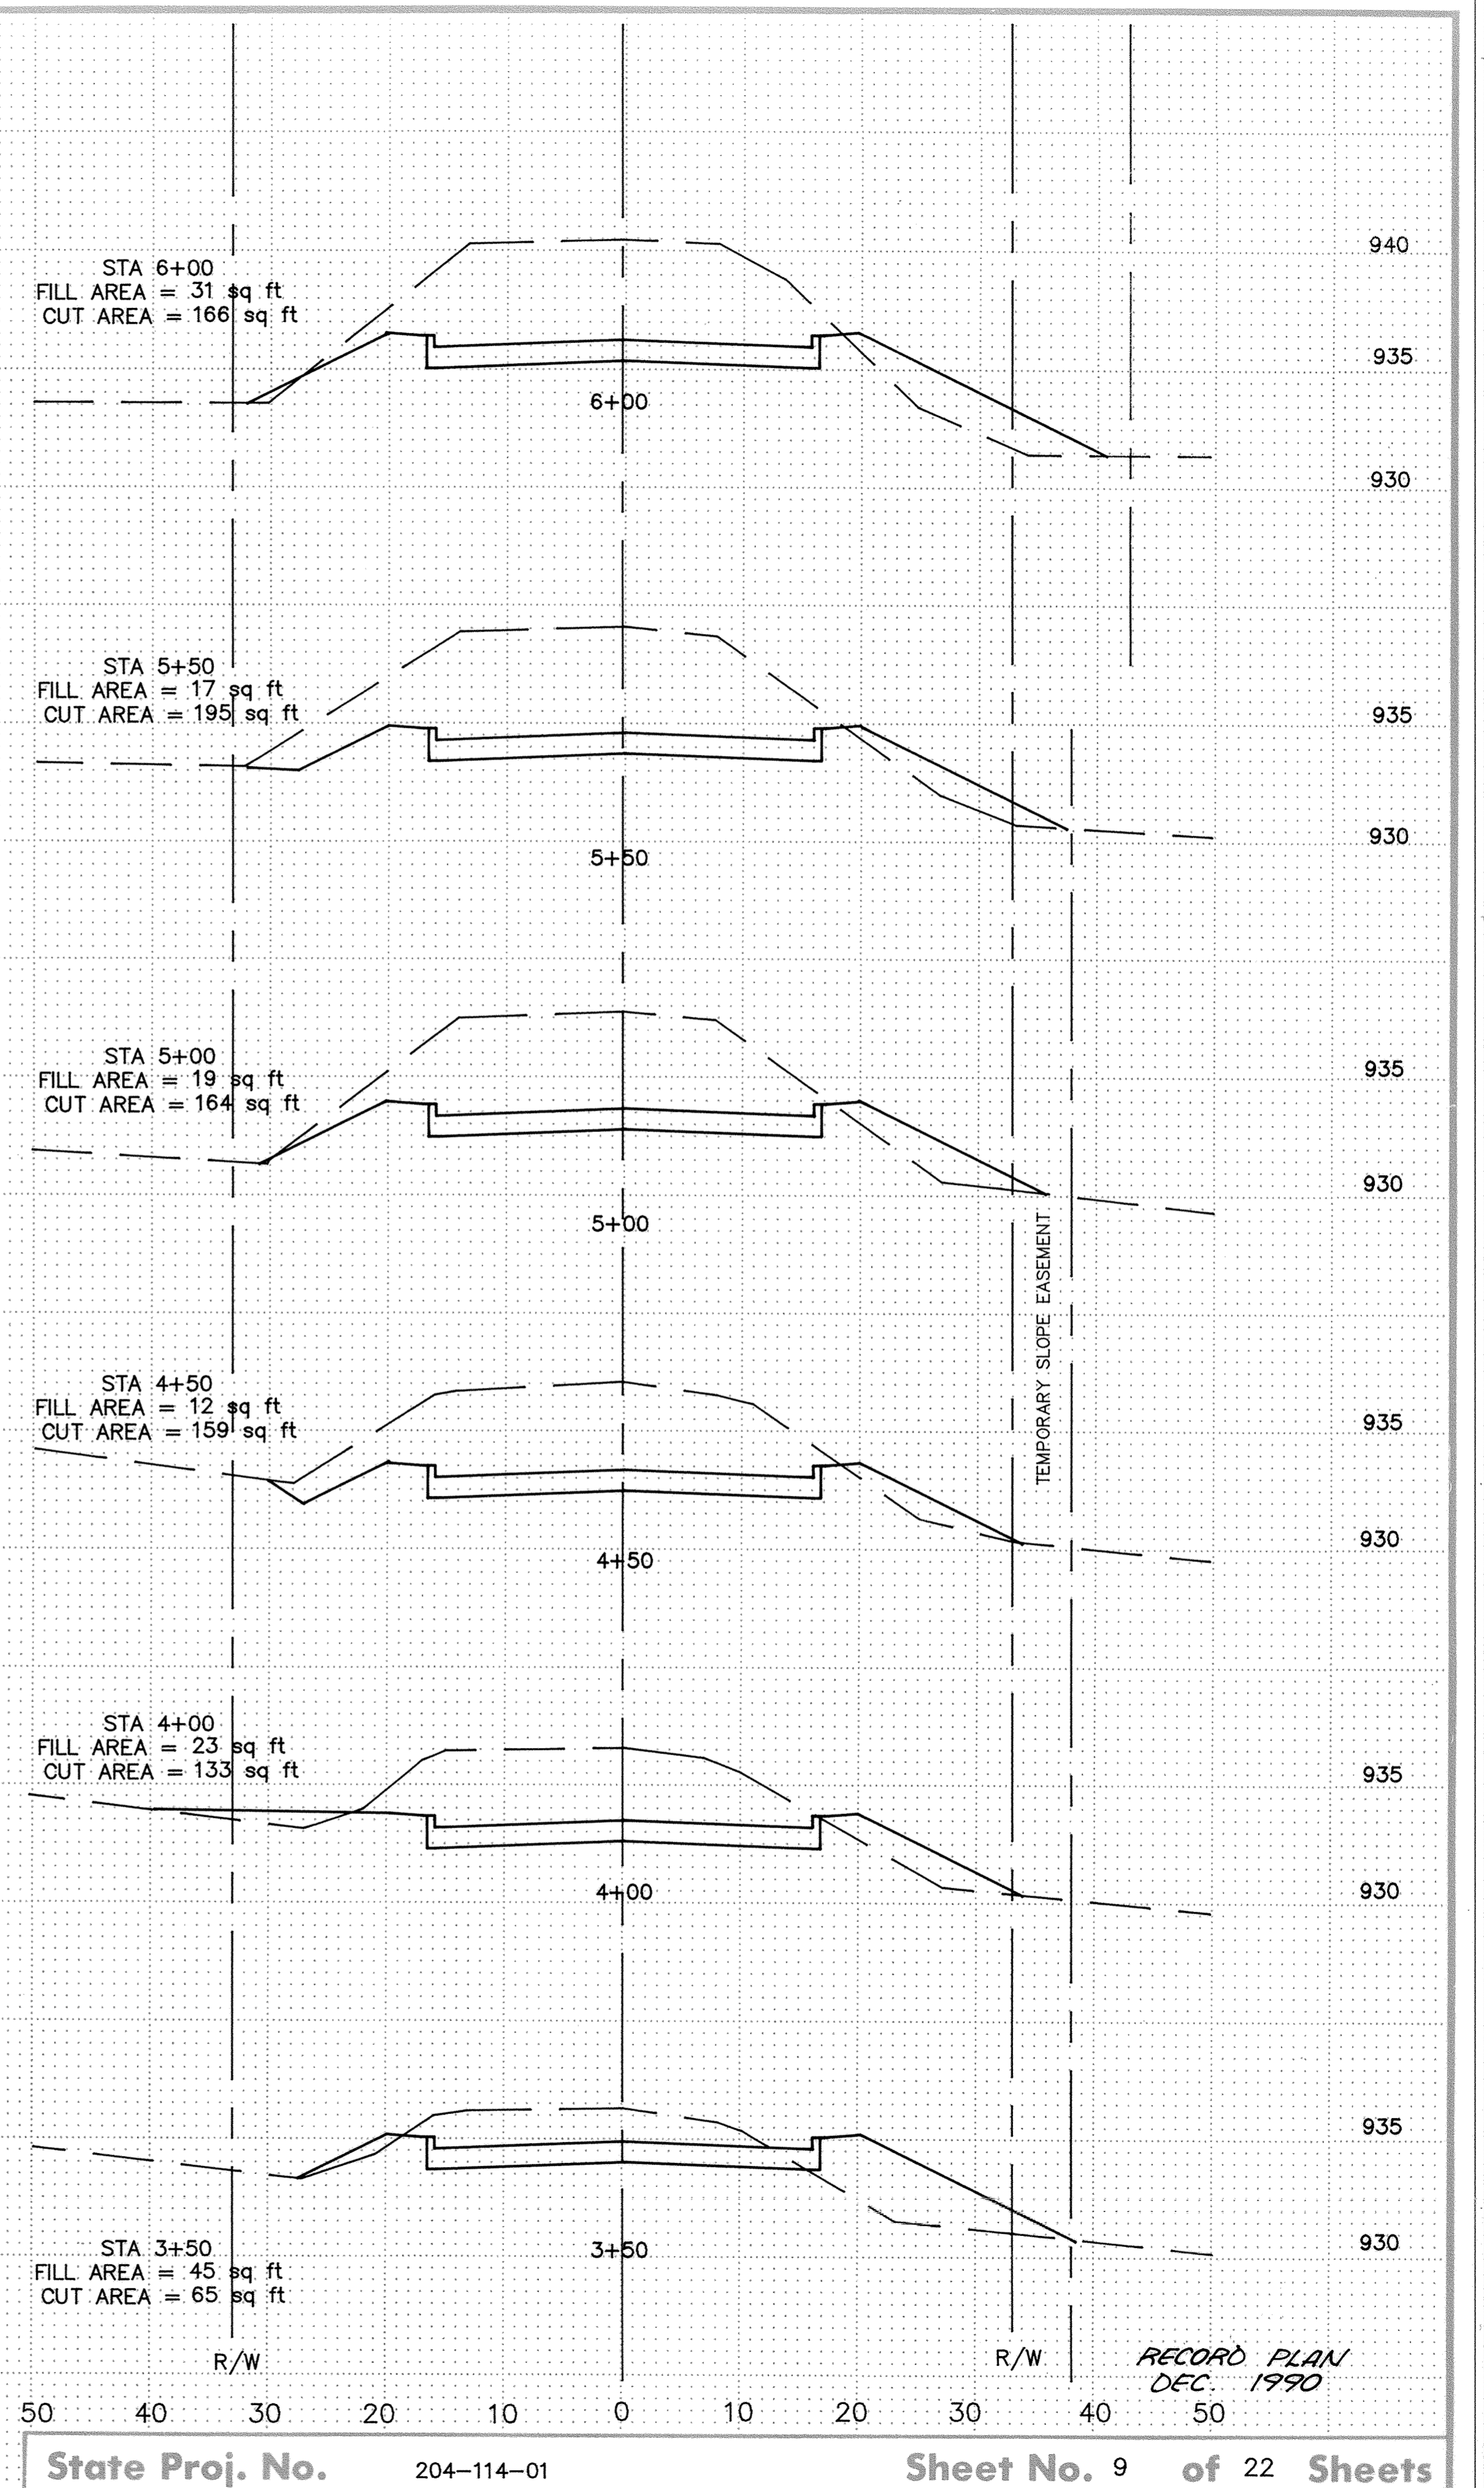


SDCO PRODUCTS • NEW HOPE, MINNESOTA
REORDER BY PART NUMBER 8552
SDCO PRODUCTS • NEW HOPE, MINNESOTA
REORDER BY PART NUMBER 8552
SDCO PRODUCTS • NEW HOPE, MINNESOTA
REORDER BY PART NUMBER 8552
SDCO PRODUCTS • NEW HOPE, MINNESOTA
REORDER BY PART NUMBER 8552

STATION	AREAS in SQ. FT.		VOLUMES in CU. YDS.	
	CUT	FILL	CUT	FILL
0+80	103	0	93	0
1+00	148	0	247	0
1+50	119	0	189	9
2+00	85	10	143	31
2+50	70	24	136	44
3+00	77	24	131	64
3+50	65	45	183	63
4+00	133	23	270	32
4+50	159	12	299	29
5+00	164	19	332	33
5+50	195	17	335	44
6+00	166	31	2358	350

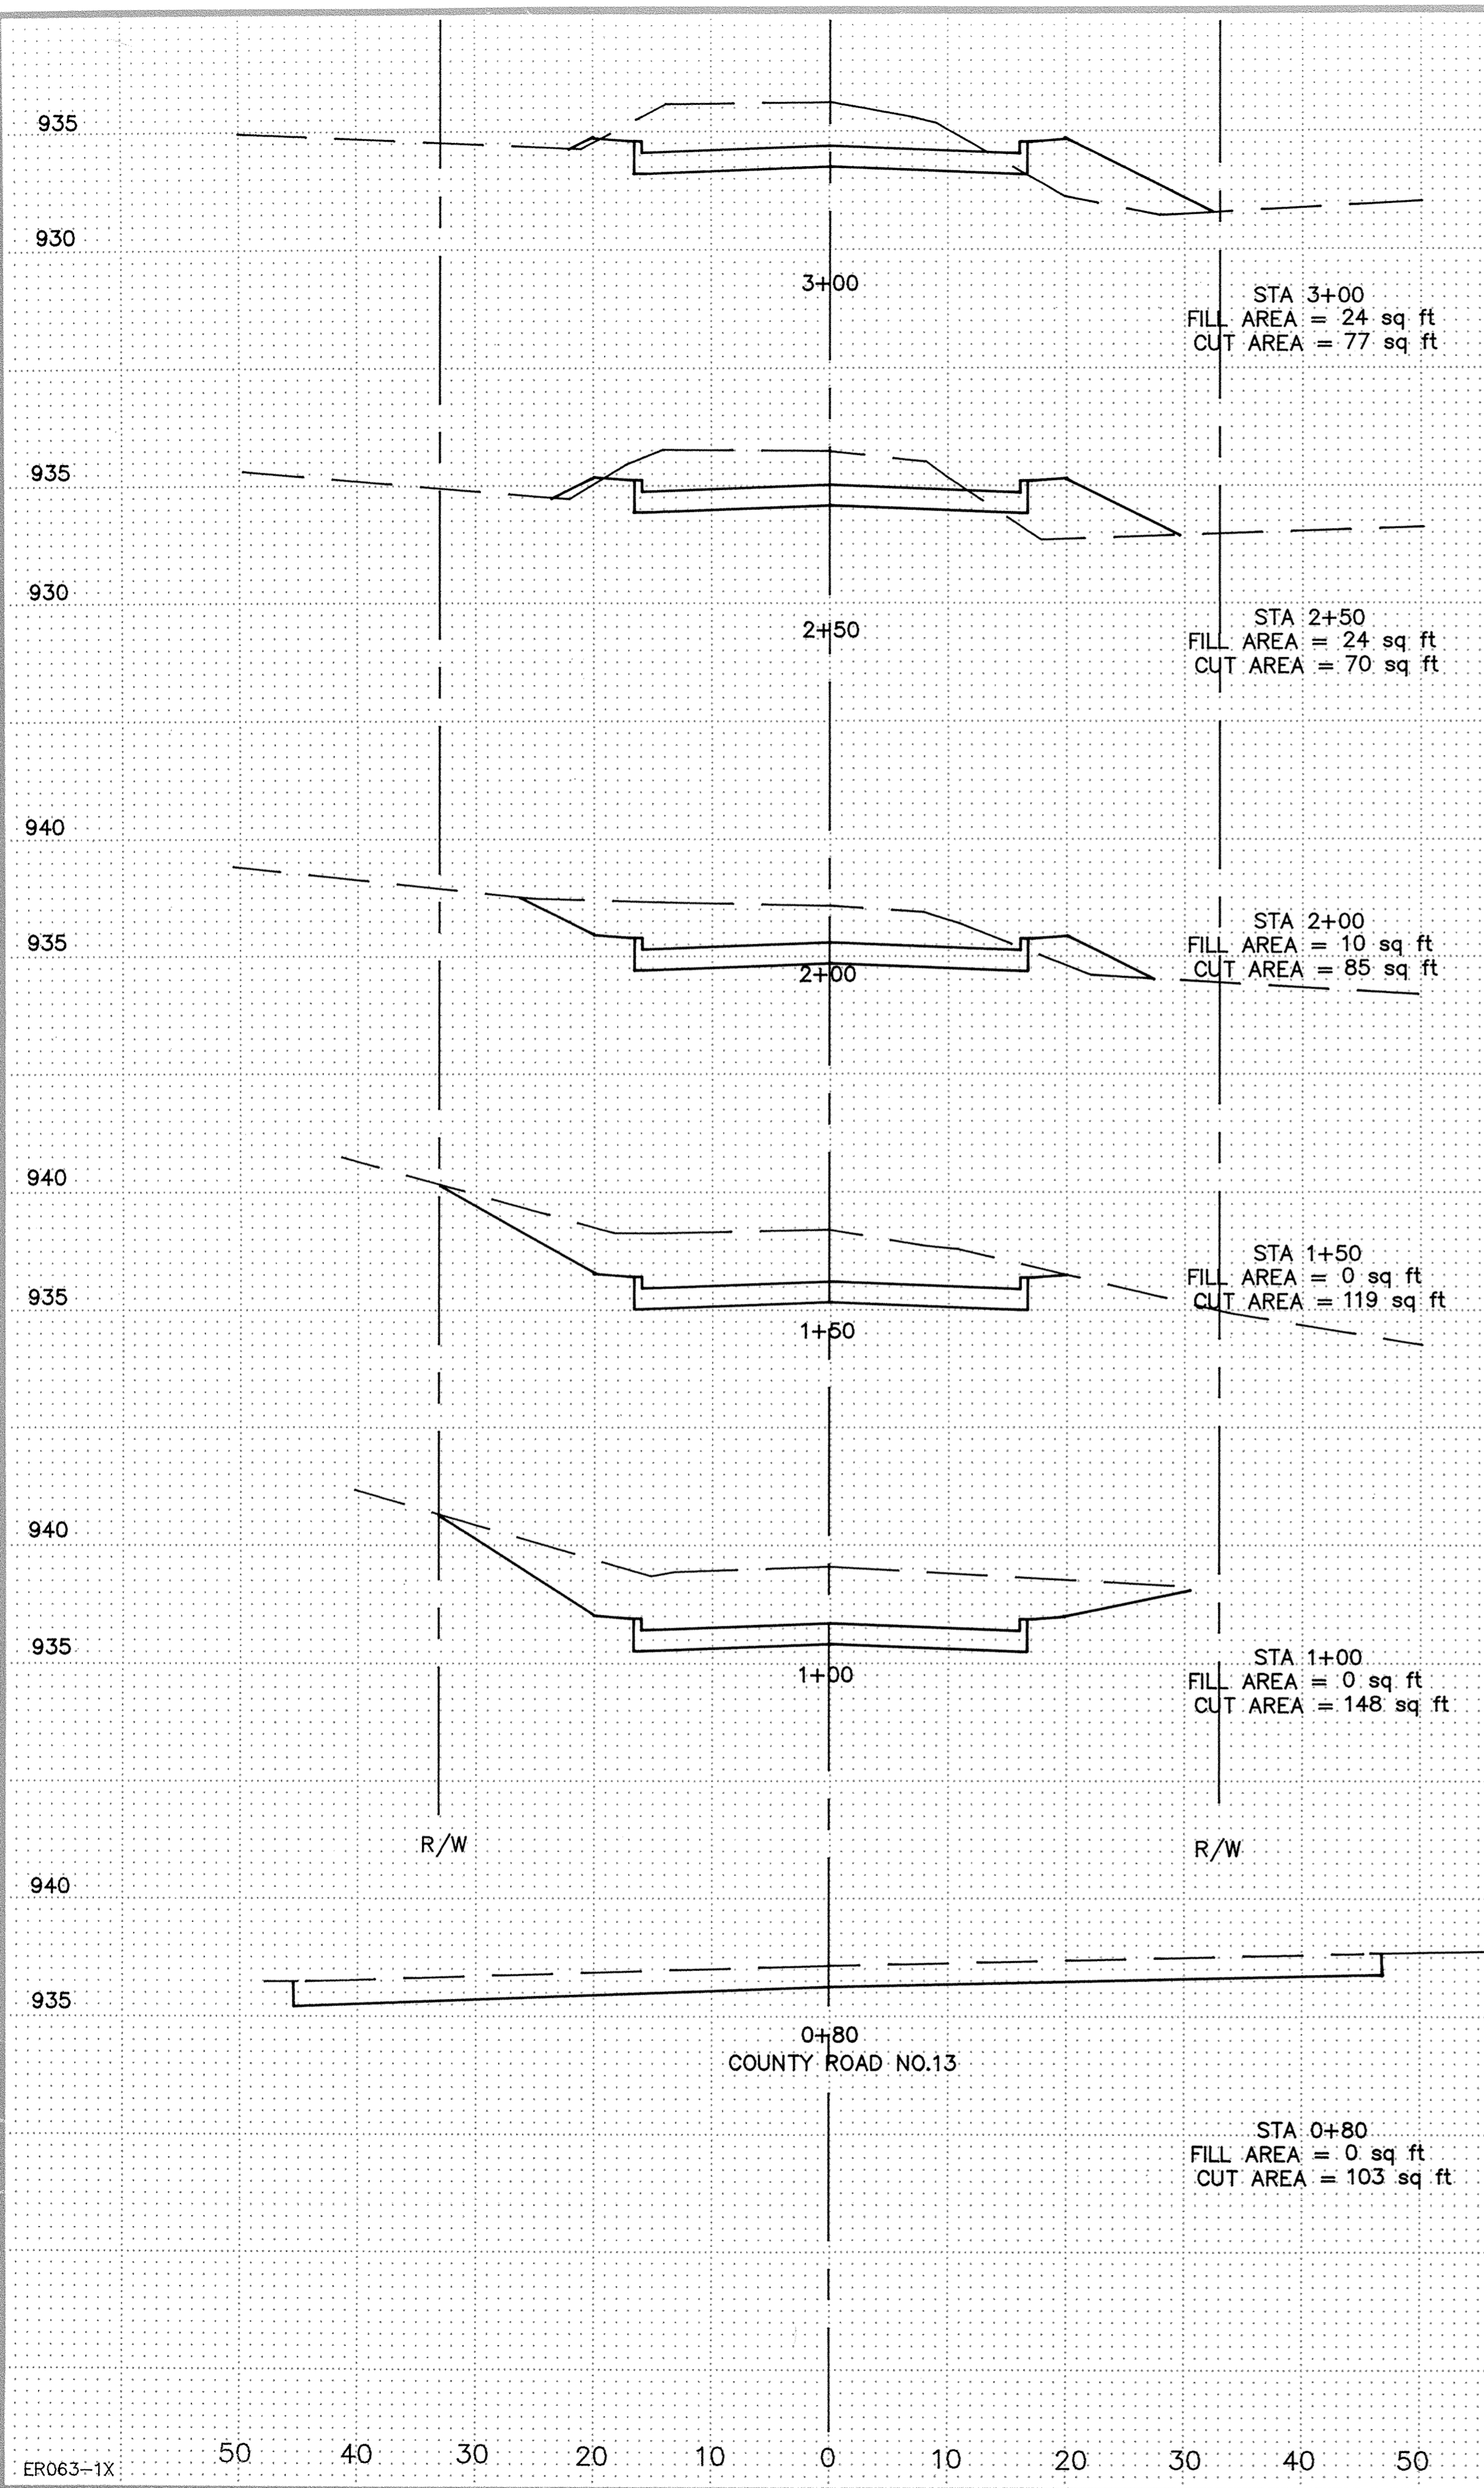

RECORD PLAN
DEC. 1990