
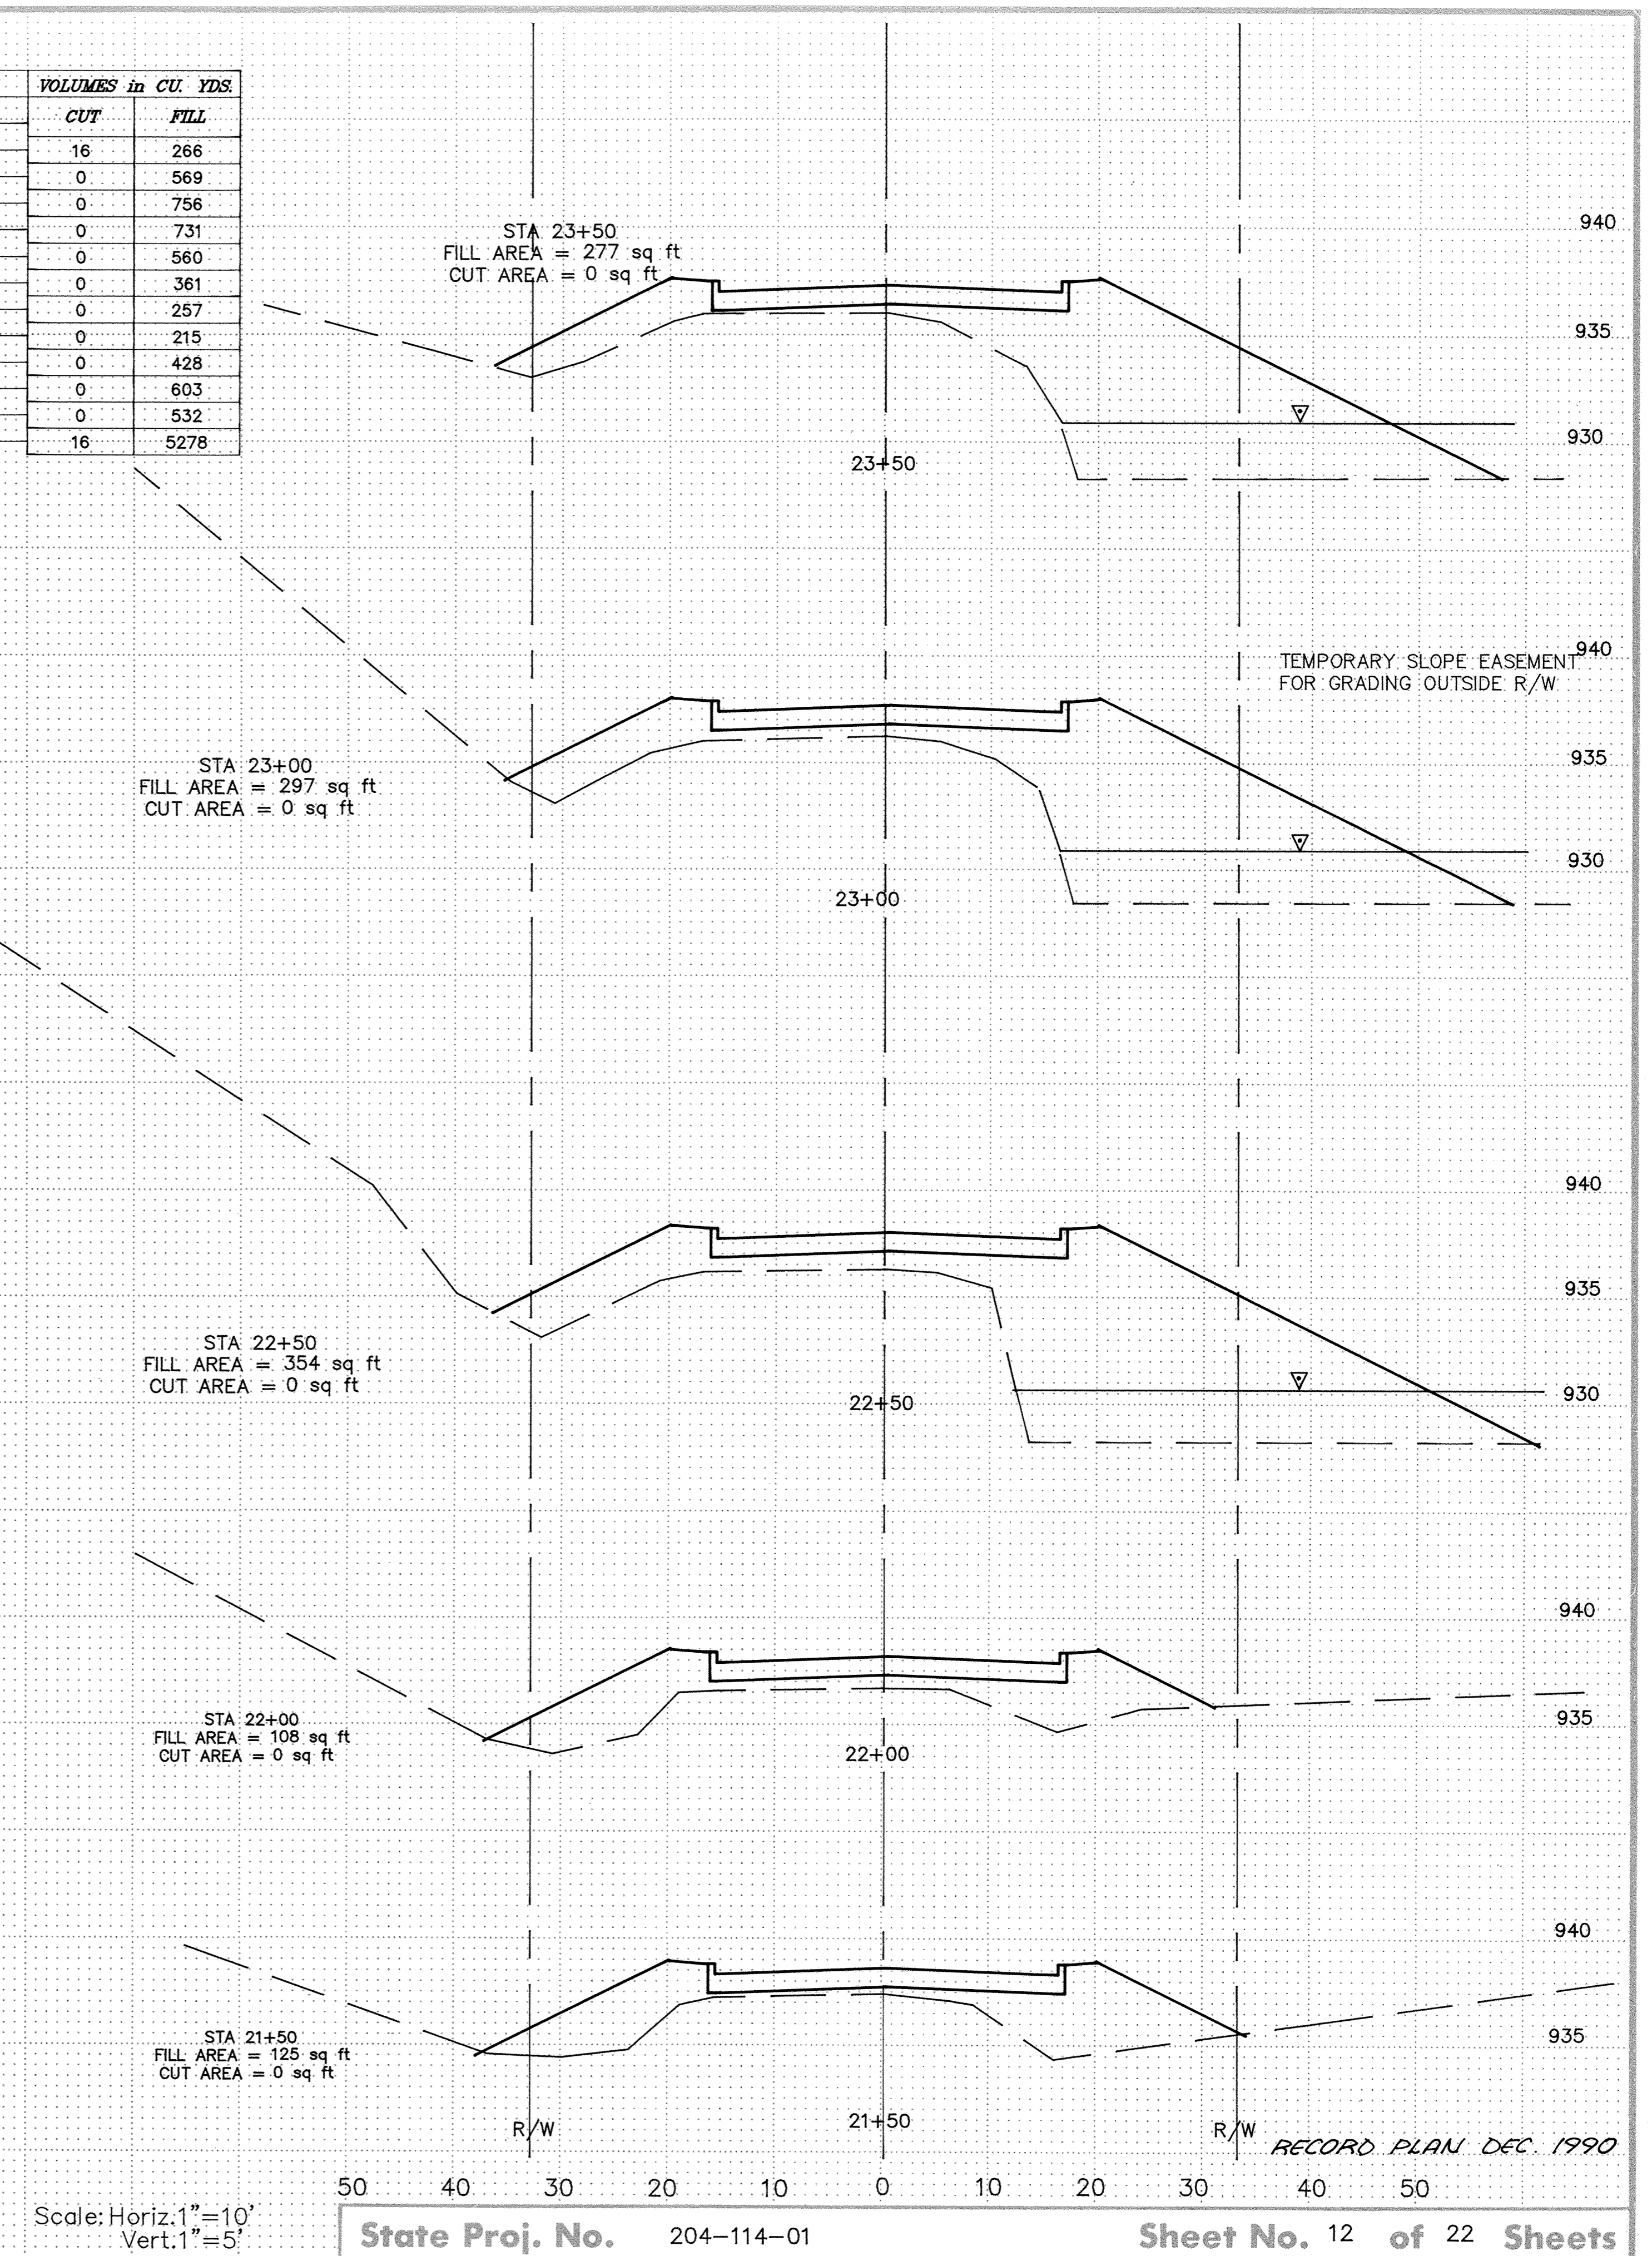


SDPC PRODUCTS • NEW HOPE, MINNESOTA  
REORDER BY PART NUMBER 6592  
SDPC PRODUCTS • NEW HOPE, MINNESOTA  
REORDER BY PART NUMBER 6592  
SDPC PRODUCTS • NEW HOPE, MINNESOTA  
REORDER BY PART NUMBER 6592  
SDPC PRODUCTS • NEW HOPE, MINNESOTA  
REORDER BY PART NUMBER 6592

STATION	AREAS in SQ FT		VOLUMES in CU. YDS.	
	CUT	FILL	CUT	FILL
18+00	17	68	16	266
18+50	0	219	0	569
19+00	0	396	0	756
19+50	0	421	0	731
20+00	0	368	0	560
20+50	0	237	0	361
21+00	0	153	0	257
21+50	0	125	0	215
22+00	0	108	0	428
22+50	0	354	0	603
23+00	0	297	0	532
23+50	0	277	16	5278

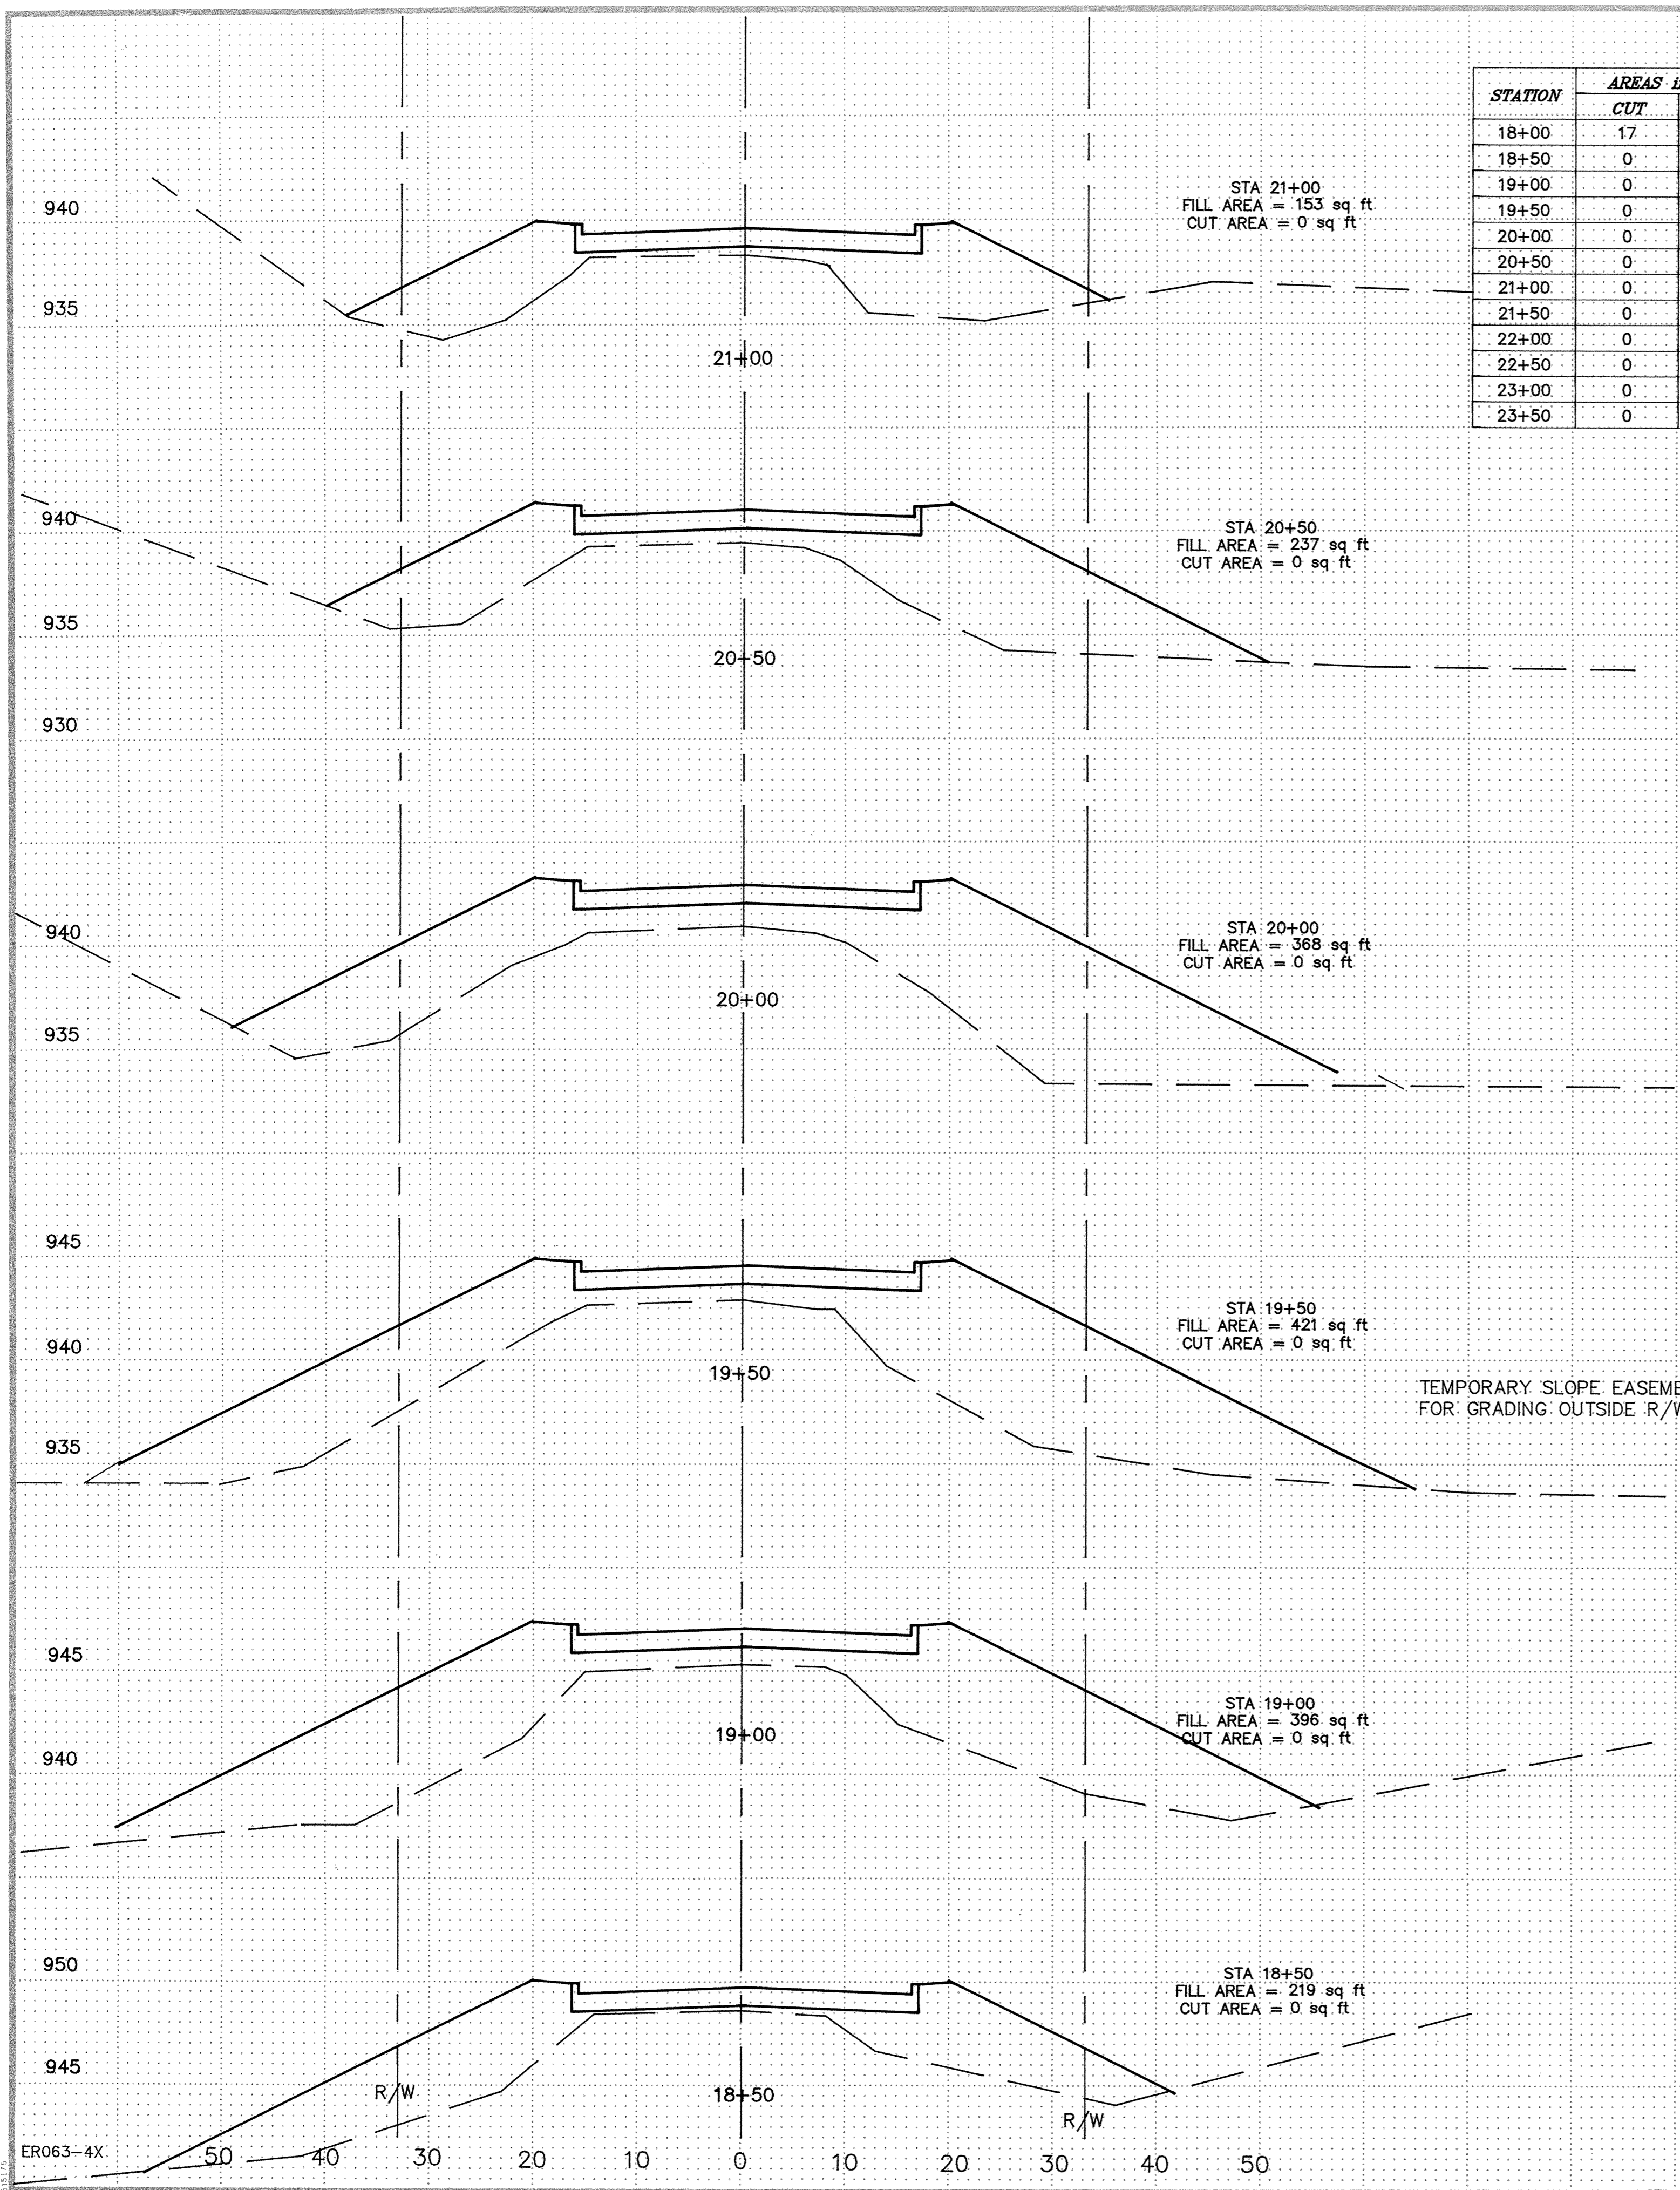

Scale: Horiz. 1" = 10'  
Vert. 1" = 5'

State Proj. No. 204-114-01

Sheet No. 12 of 22 Sheets

RECORD PLAN DEC. 1990

ER063-4X