


STATION	AREAS in SQ FT		VOLUMES in CU. YDS.	
	CUT	FILL	CUT	FILL
23+50	0	277	4	479
24+00	4	241	11	424
24+50	8	217	22	399
25+00	16	214	33	251
25+50	19	57	36	307
26+00	19	274	29	530
26+50	12	298	11	574
27+00	0	322	0	607
27+50	0	333	0	635
28+00	0	353	0	668
28+50	0	369	0	663
29+00	0	347	0	666
29+50	0	373	145	6204

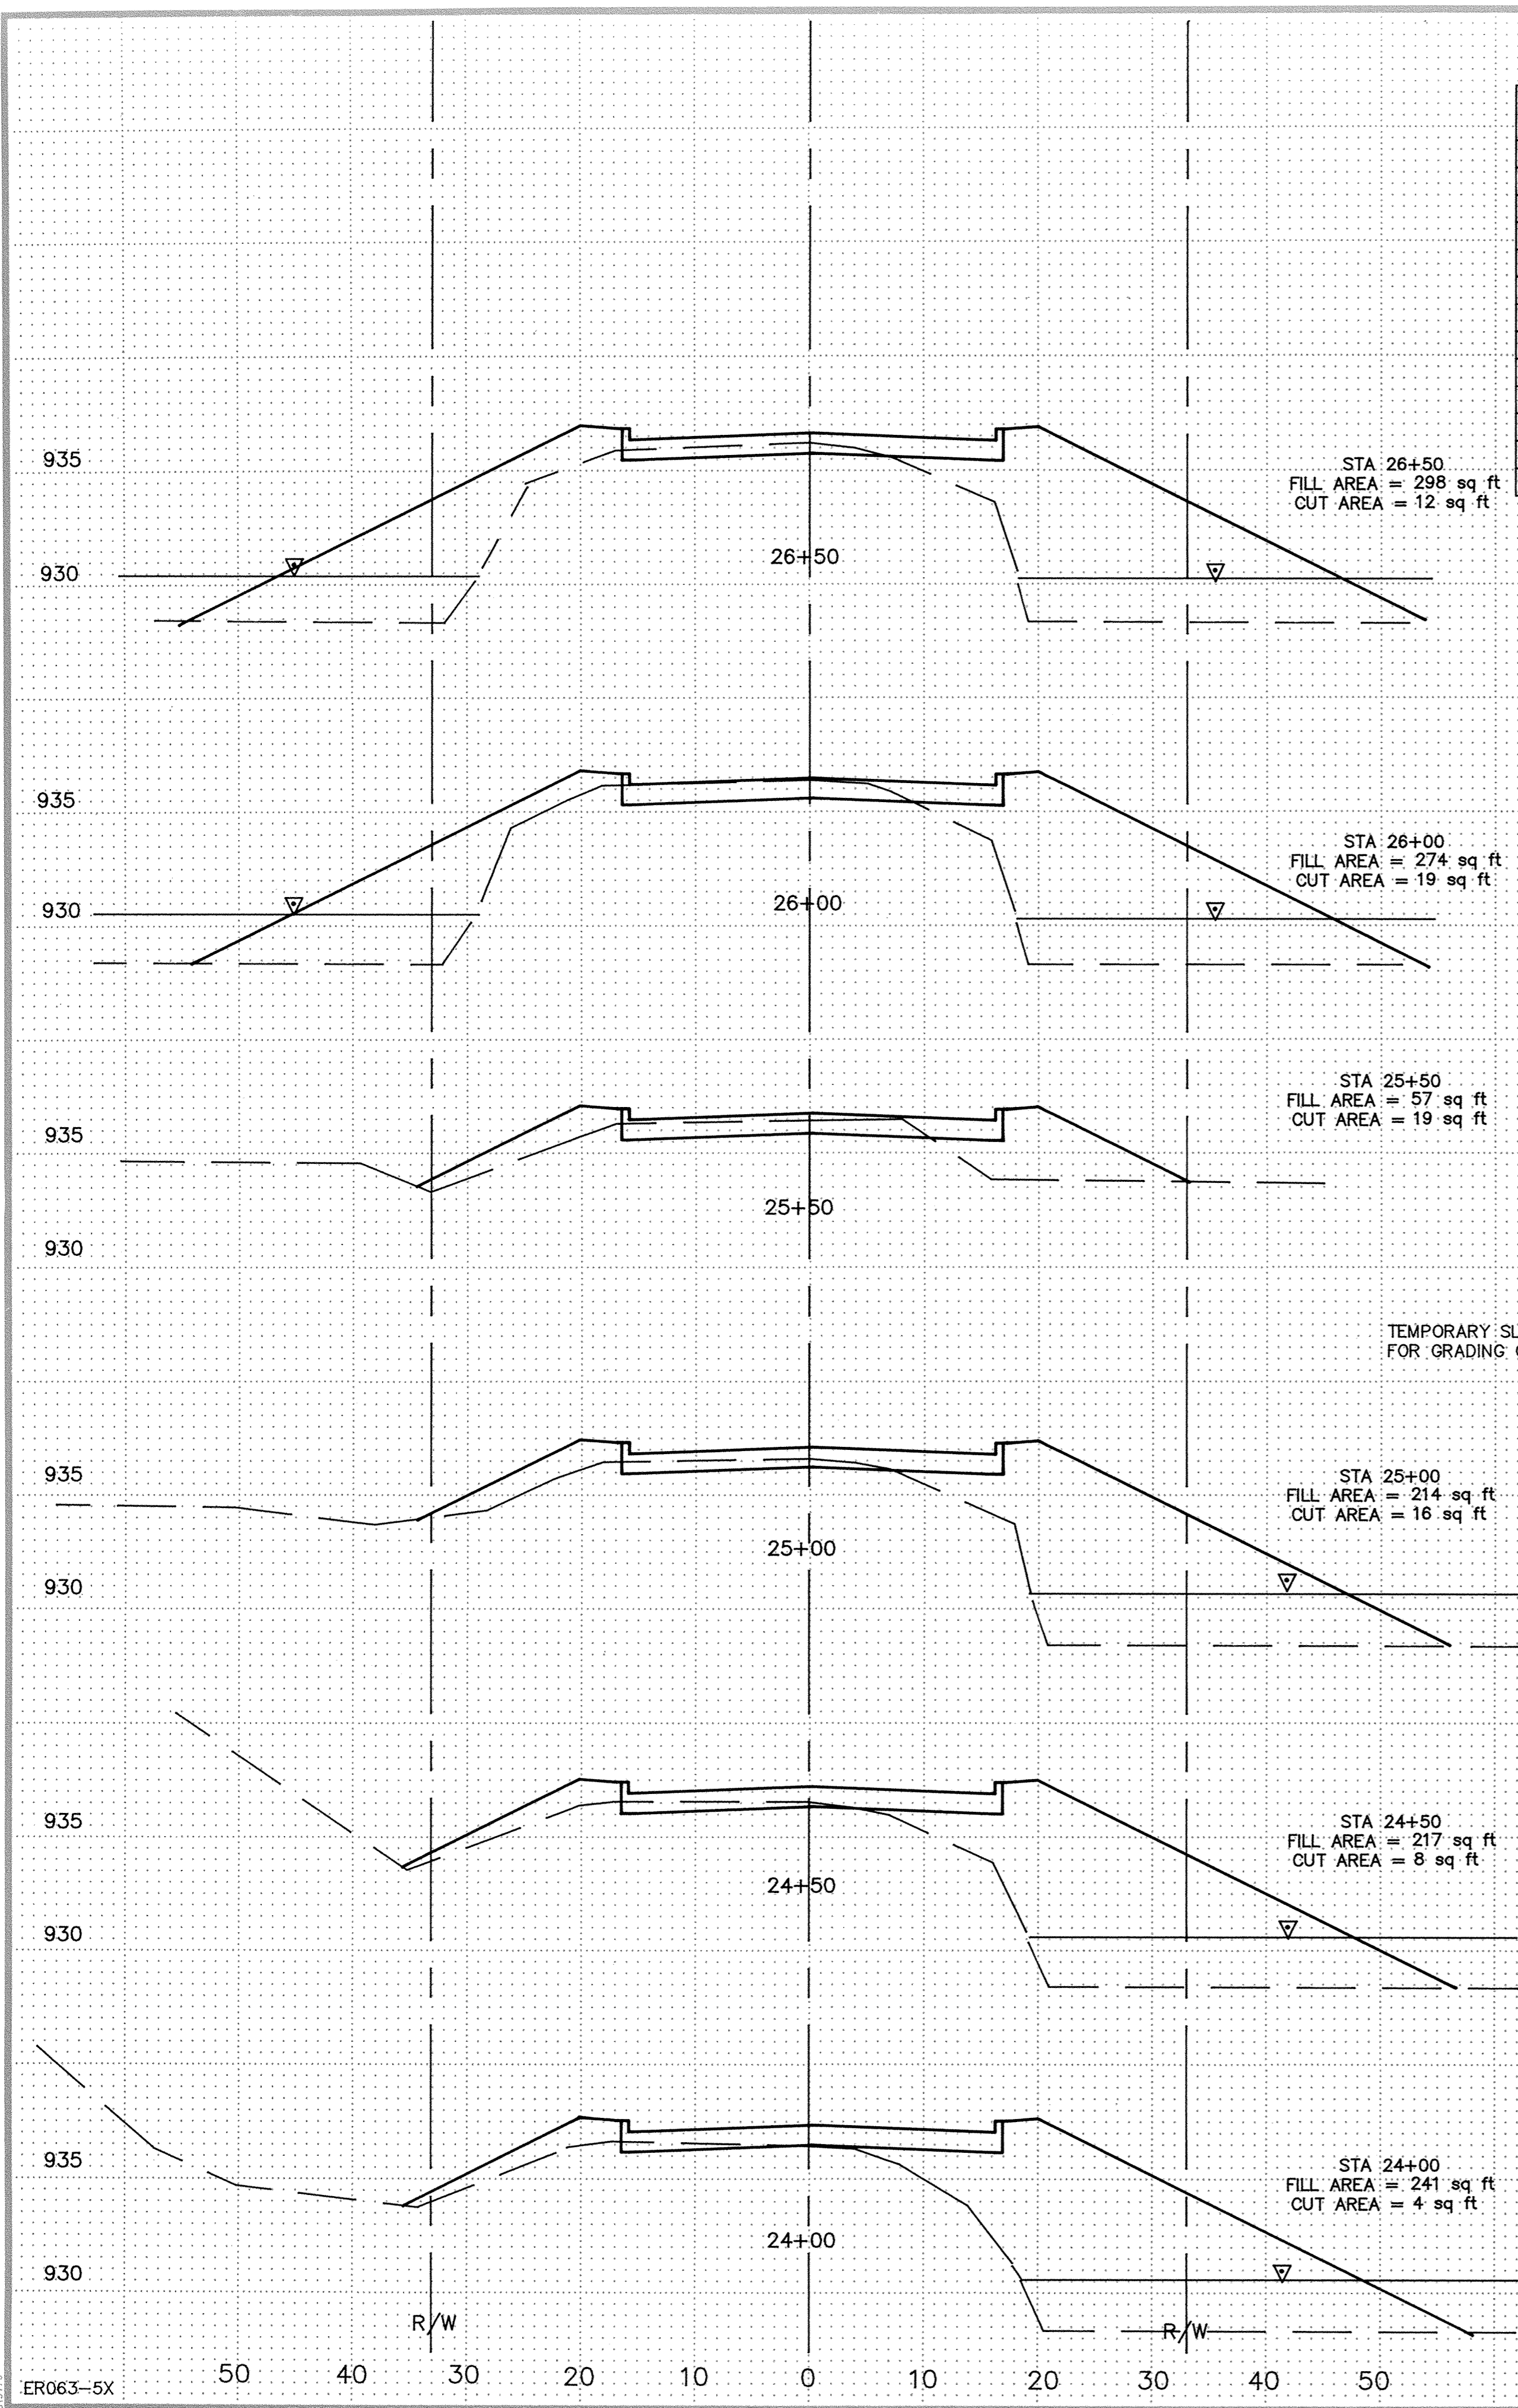

STA 29+50
FILL AREA = 373 sq ft
CUT AREA = 0 sq ft


STA 29+00
FILL AREA = 347 sq ft
CUT AREA = 0 sq ft

STA 28+50
FILL AREA = 369 sq ft
CUT AREA = 0 sq ft

STA 28+00
FILL AREA = 353 sq ft
CUT AREA = 0 sq ft

STA 27+50
FILL AREA = 333 sq ft
CUT AREA = 0 sq ft

STA 27+00
FILL AREA = 322 sq ft
CUT AREA = 0 sq ft

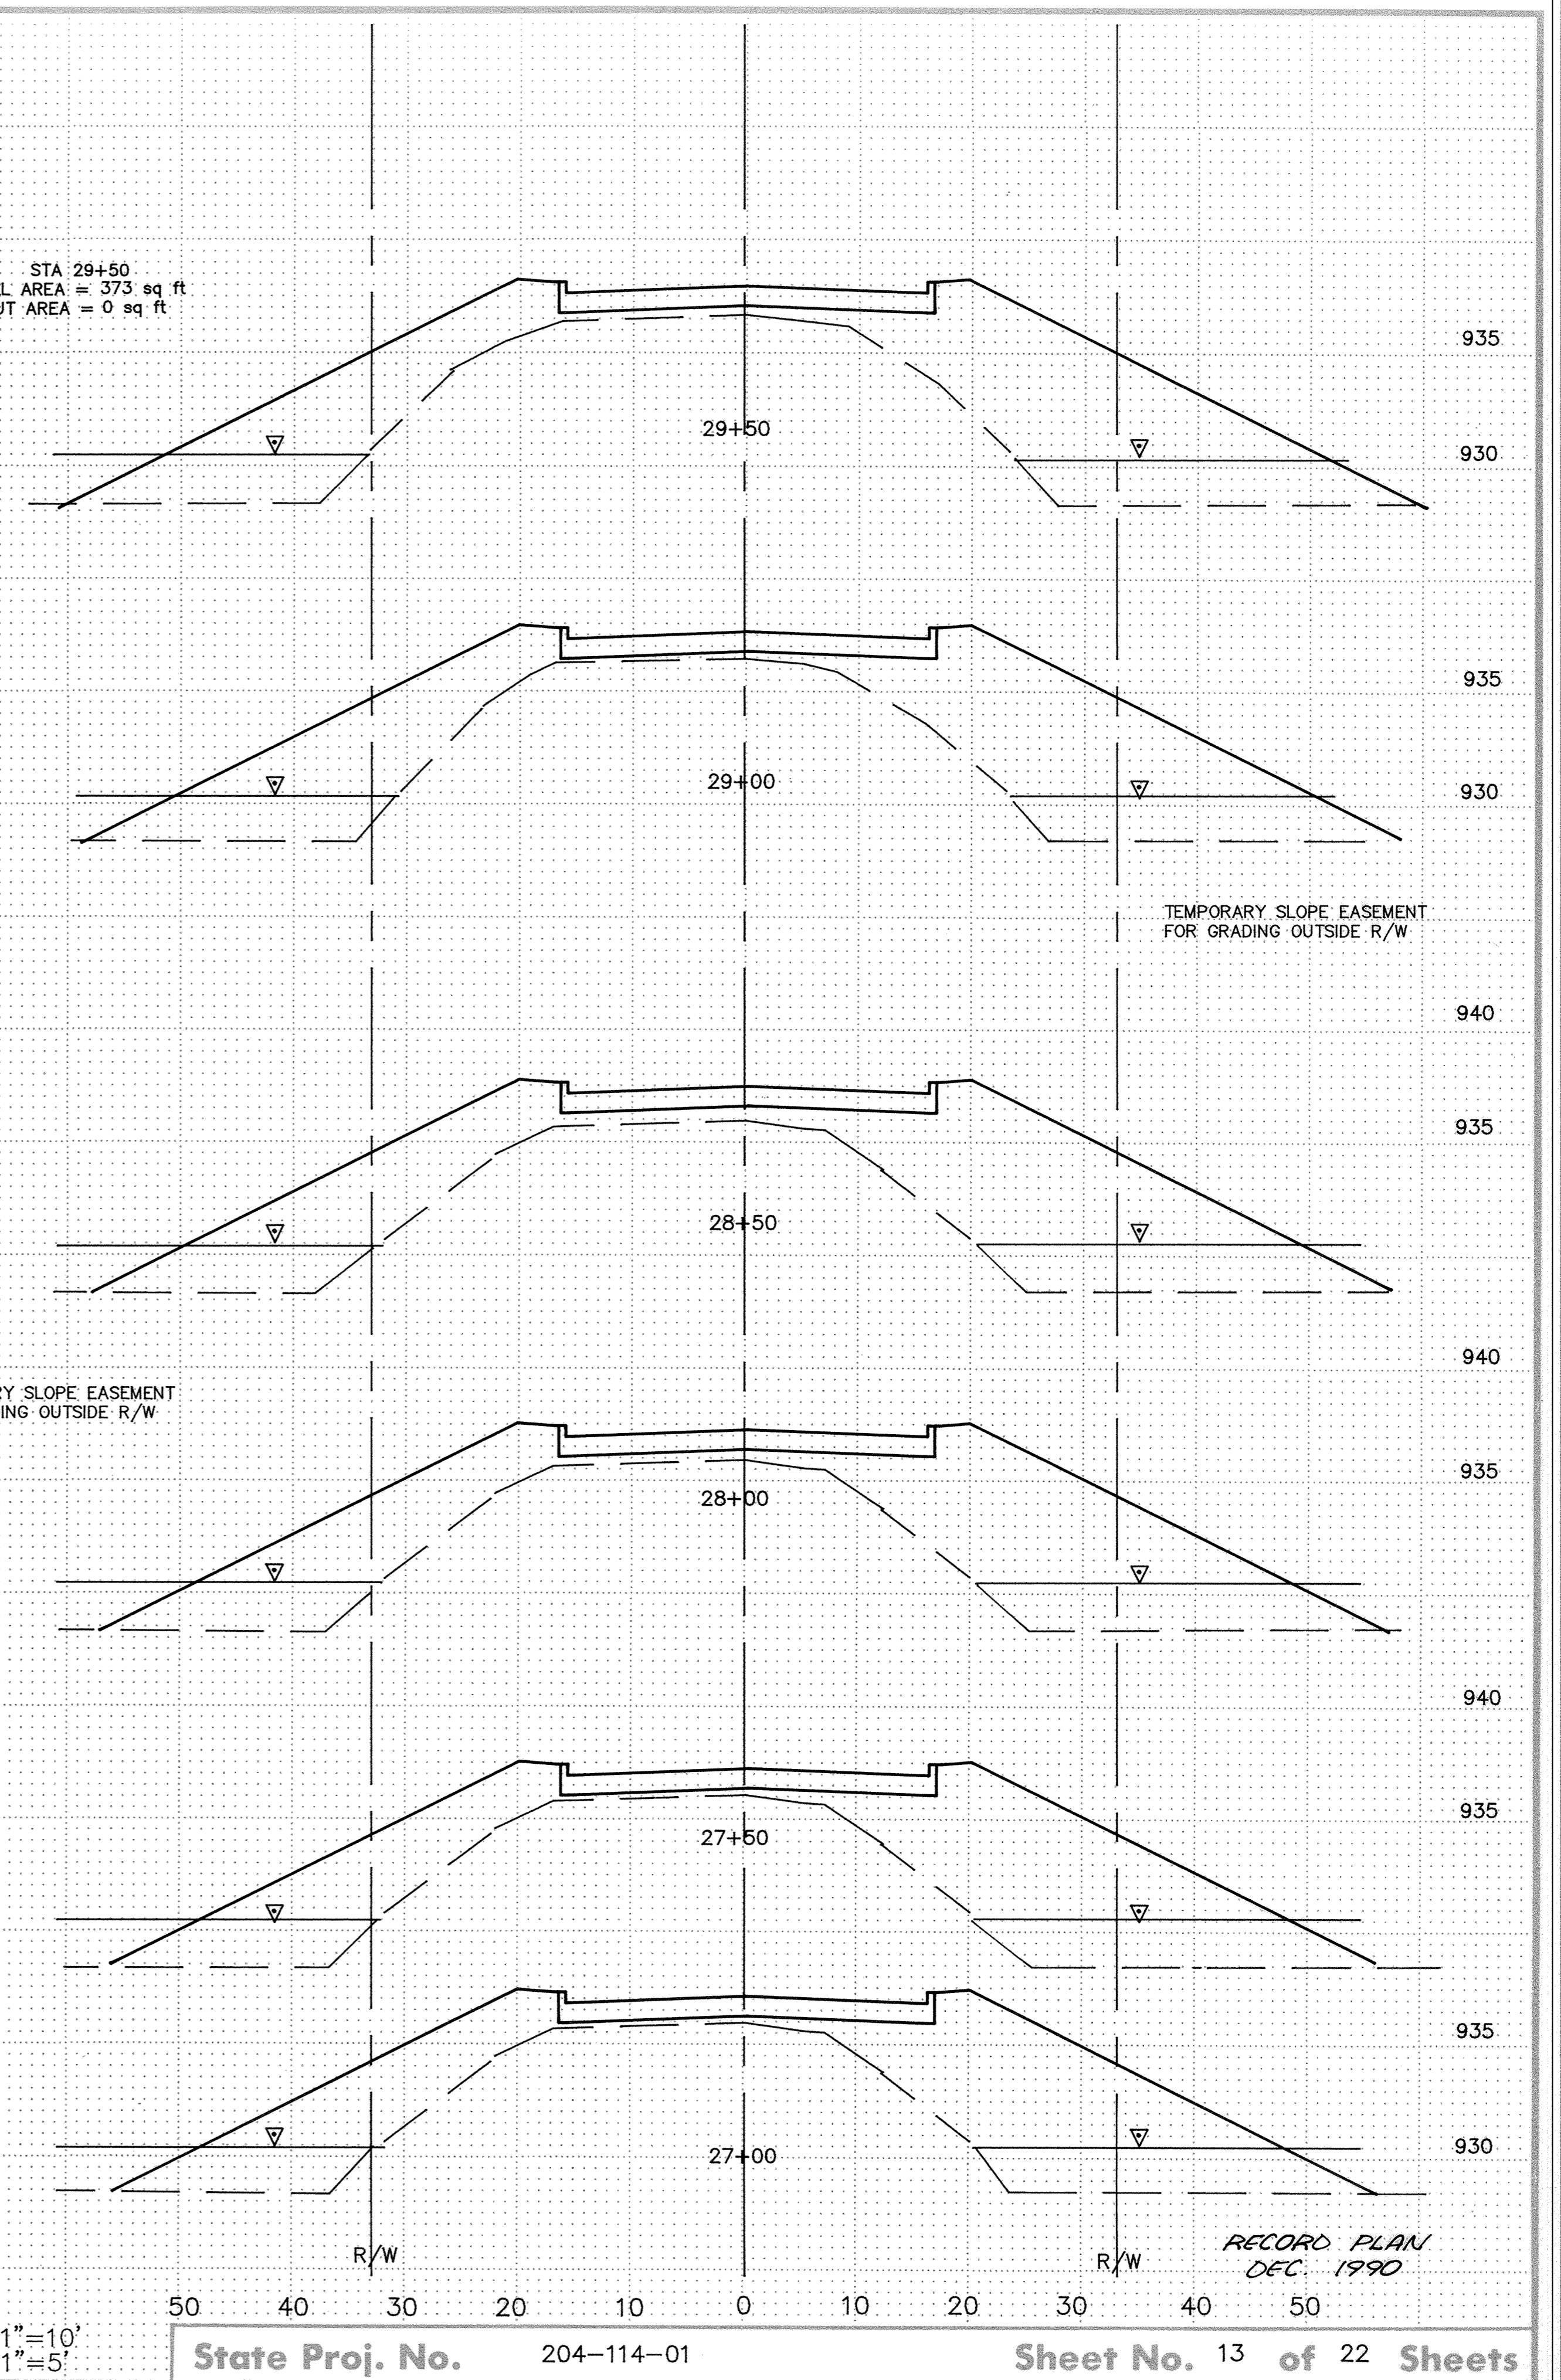

Scale: Horiz. 1" = 10'
Vert. 1" = 5'

RECORD PLAN
DEC. 1990