



SAICO PRODUCTS • NEW HOPE, MINNESOTA  
REORDER BY PART NUMBER 8552

STATION	AREAS in SQ FT		VOLUMES in CU. YDS.	
	CUT	FILL	CUT	FILL
44+50	0	953	0	1642
45+00	0	821	0	1028
45+50	0	289	18	429
46+00	20	174	74	172
46+50	60	12	151	11
47+00	103	0	197	0
47+50	110	0	119	38
48+00	19	41	559	3319

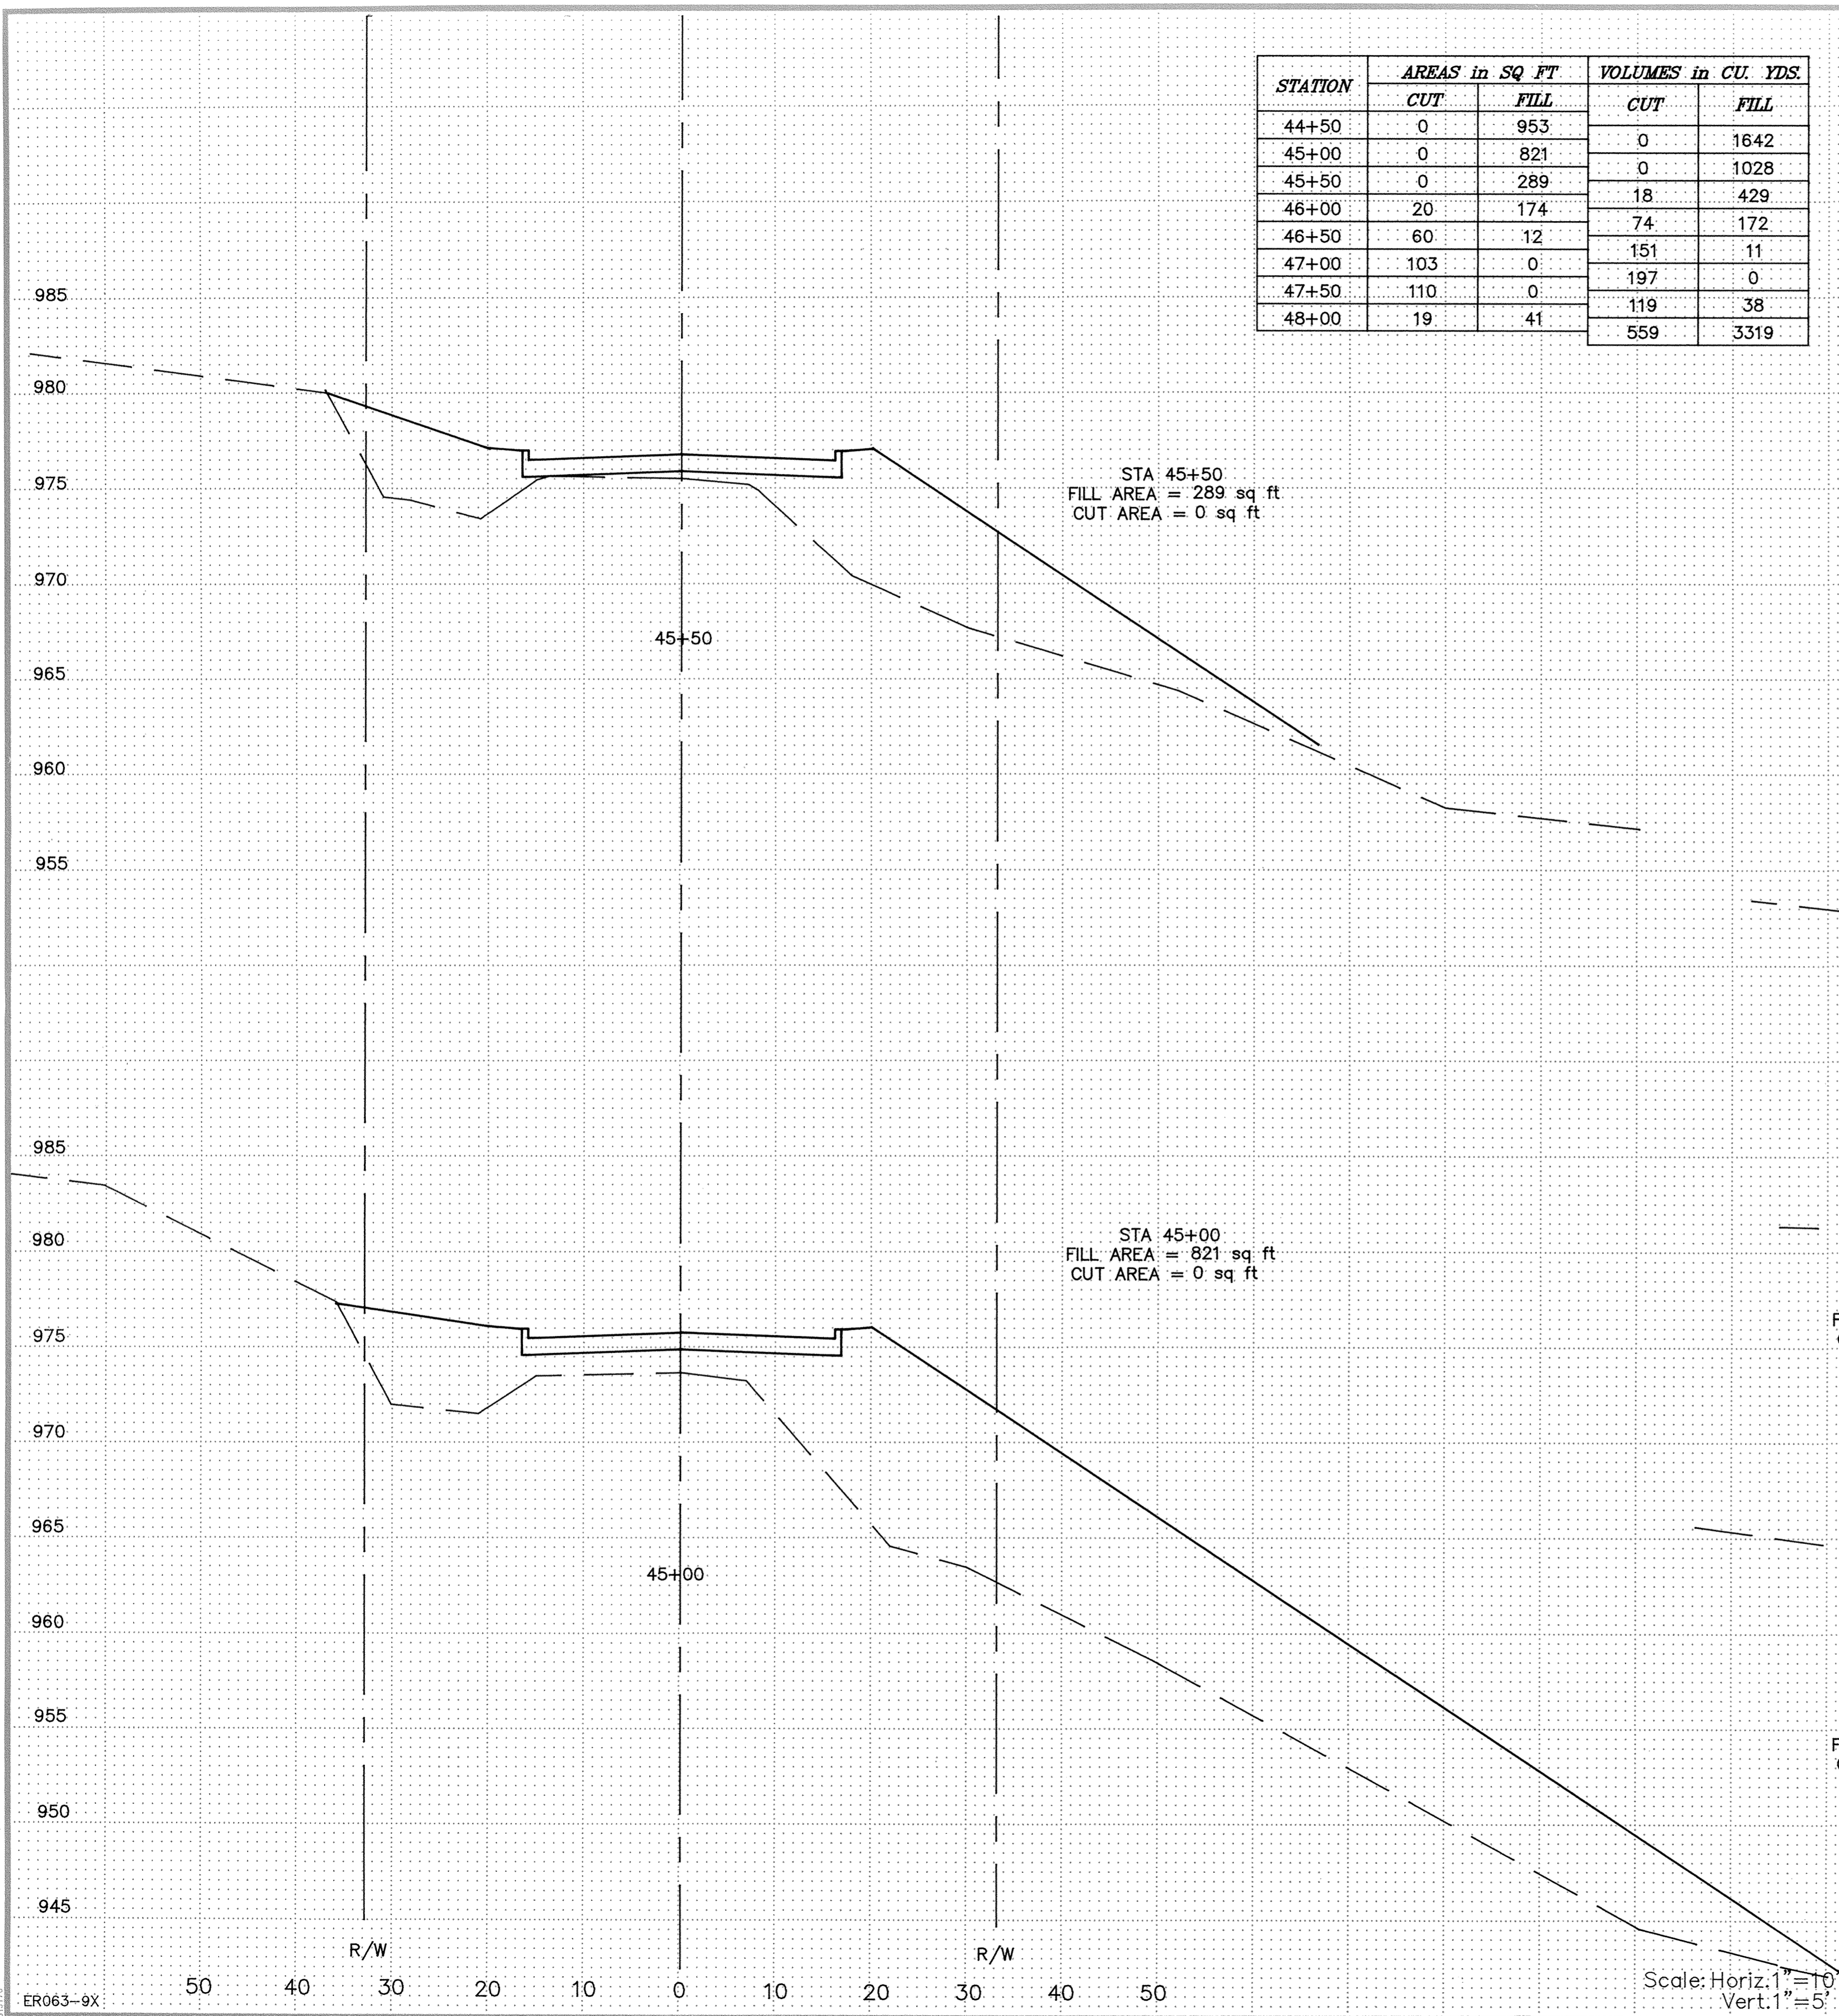

STA 45+50  
FILL AREA = 289 sq ft  
CUT AREA = 0 sq ft

STA 45+00  
FILL AREA = 821 sq ft  
CUT AREA = 0 sq ft

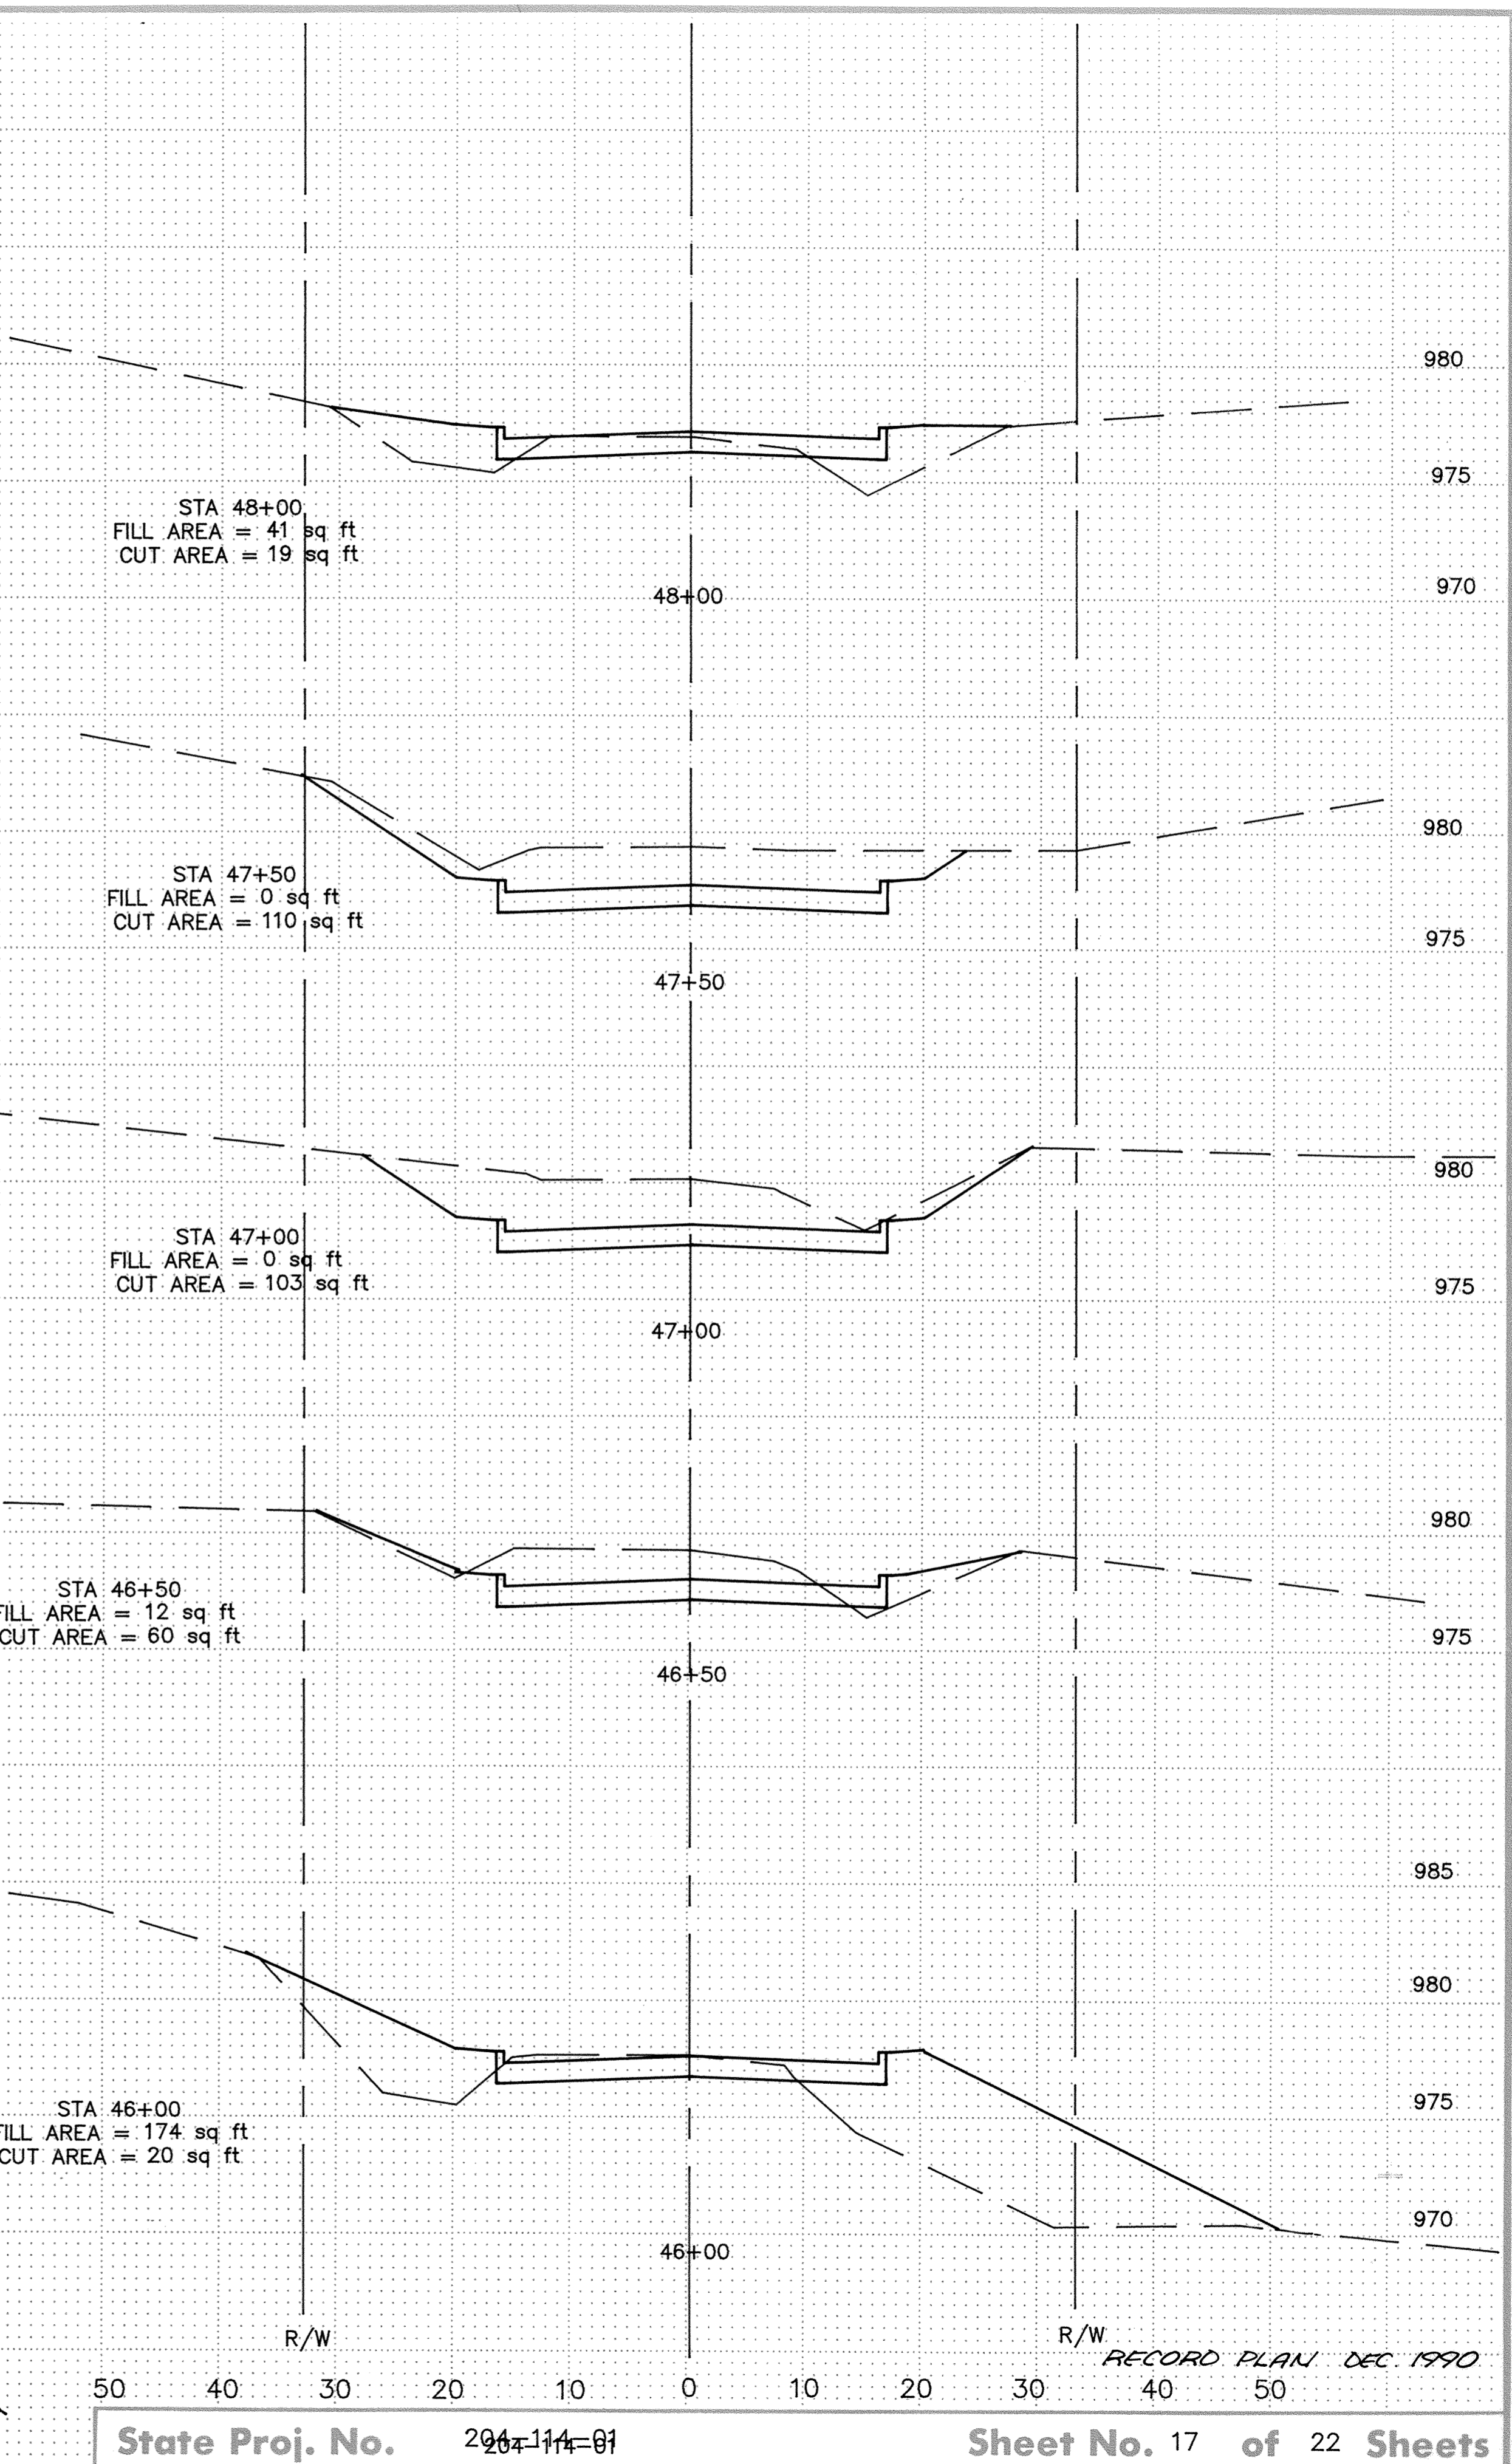

STA 48+00  
FILL AREA = 41 sq ft  
CUT AREA = 19 sq ft

STA 47+50  
FILL AREA = 0 sq ft  
CUT AREA = 110 sq ft

STA 47+00  
FILL AREA = 0 sq ft  
CUT AREA = 103 sq ft

STA 46+50  
FILL AREA = 12 sq ft  
CUT AREA = 60 sq ft

STA 46+00  
FILL AREA = 174 sq ft  
CUT AREA = 20 sq ft

Scale: Horiz. 1" = 10'  
Vert. 1" = 5'

State Proj. No. 204-114-01

Sheet No. 17 of 22 Sheets

RECORD PLAN DEC. 1990