


ELK RIVER TYLER ST. @ STA. 45+50 ±

1" = 20'



980+1

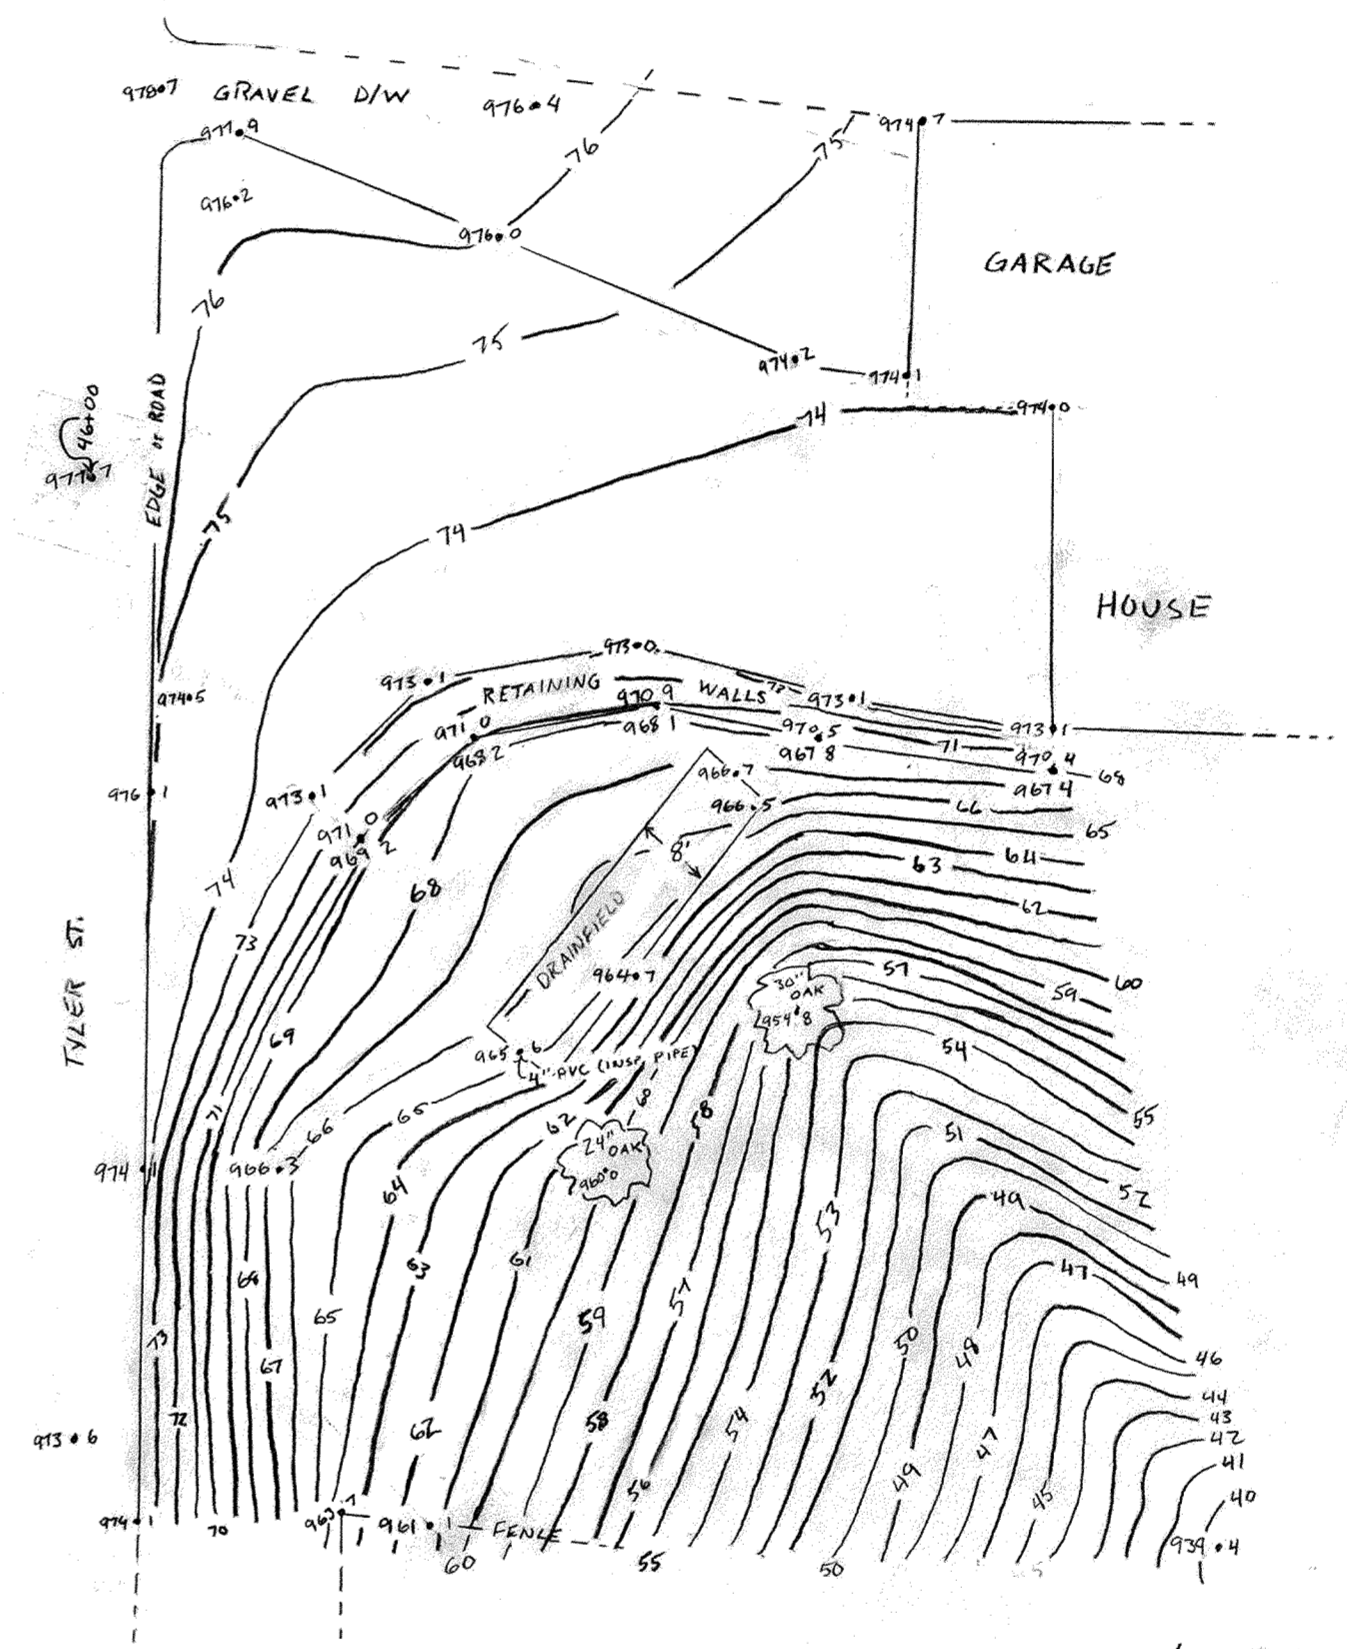

6/6/99 SRH

TYLER ST @ 45+00 to 46+00

TYLER ST
230-063

334B

DRAWING NUMBER

DRAWING NUMBER

DRAWING NUMBER

DRAWING NUMBER
TYLER 90
24

SAFCO PRODUCTS • NEW LODE, MINNESOTA
PRODUCED BY PART NUMBER 6582

SAFCO PRODUCTS • NEW LODE, MINNESOTA
PRODUCED BY PART NUMBER 6582

SAFCO PRODUCTS • NEW LODE, MINNESOTA
PRODUCED BY PART NUMBER 6582

SAFCO PRODUCTS • NEW LODE, MINNESOTA
PRODUCED BY PART NUMBER 6582