

Construction Plans

for

Sanitary Sewer, Water Main, Storm Sewer, and Streets

for

Van Den Berg Property Elk River, Minnesota

Prepared for:


Bob Van Den Berg
10811 181st Avenue Northwest
Elk River, Minnesota 55330
Contact: Bob Van Den Berg
Phone: 763-574-9480
Fax: 763-574-9486

Prepared by:

Westwood Professional Services, Inc.
7599 Anagram Drive
Eden Prairie, MN 55344
Phone: 952/937-5150 Fax: 952/937-5822

Project Number: 20021059
Contact: Jason McCarty, P.E.

Vicinity Map

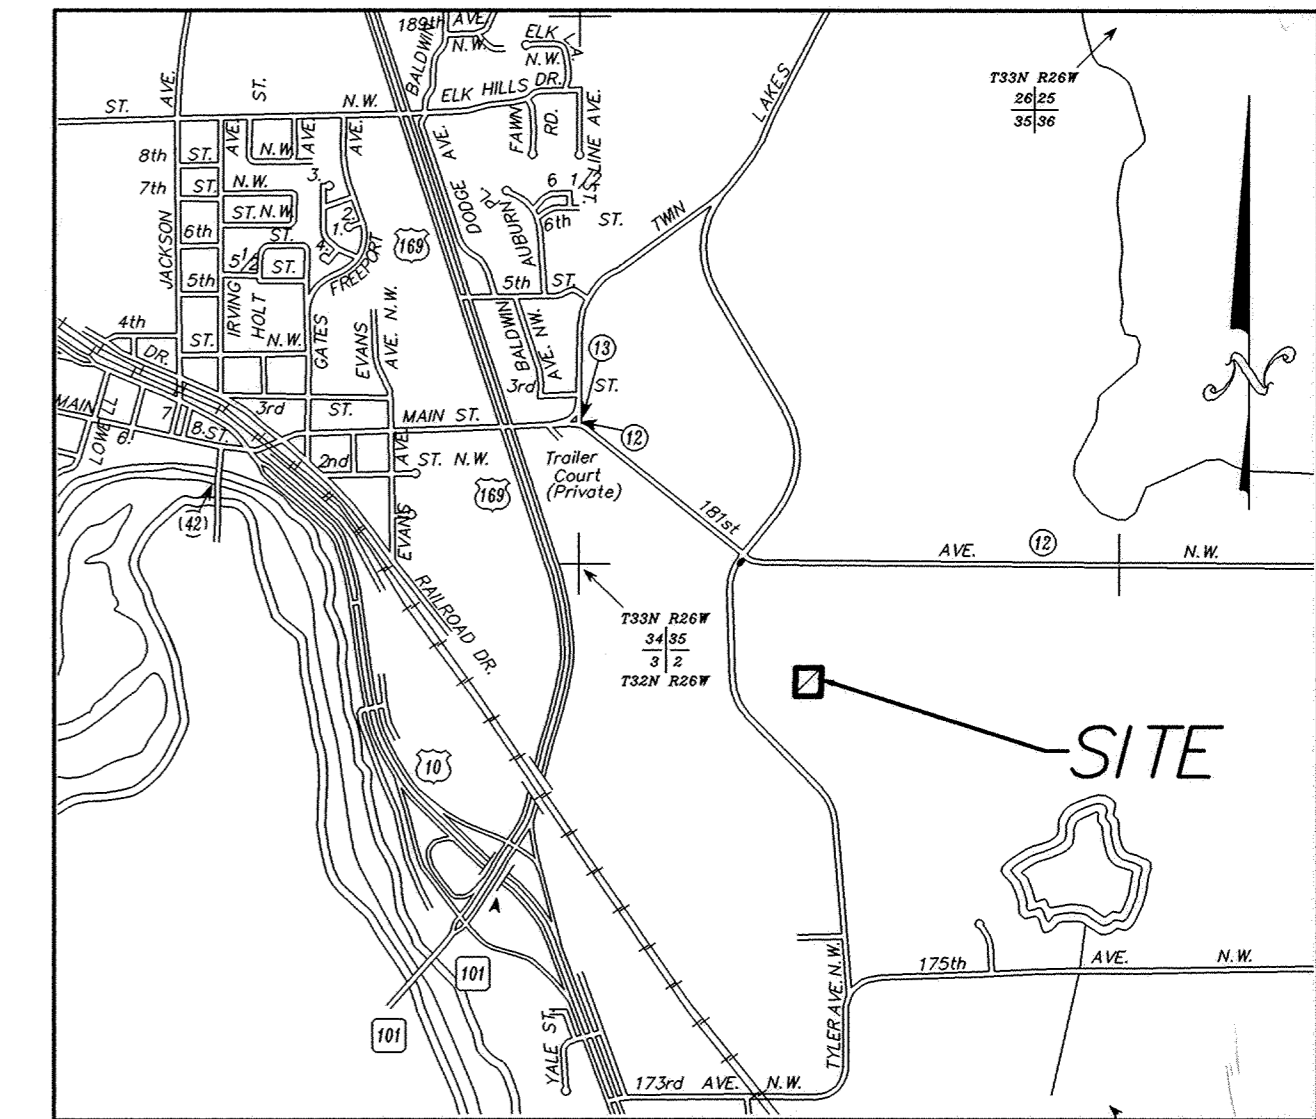

ELK RIVER
No Scale

NO.	DATE	REVISION	SHEETS
1	08/16/02	CITY REVIEW-CLJ	1-4
2	04/15/03	RECORD DRAWINGS	ALL

CONTRACTOR: RYAN CONTRACTING CO.
RECORD DRAWING
CONFORMING TO CONSTRUCTION RECORDS.
BY AL SPILLES DATE 04/15/03
WESTWOOD PROFESSIONAL SERVICES

Construction Plans

for
**Sanitary Sewer, Water Main, Storm Sewer
and Streets**
for
Van Den Berg Property
Elk River, Minnesota

Date: 07/19/02 Sheet: 1 of 8

INDEX	
SHEET NO.	DESCRIPTION
1	COVER
2	SANITARY SEWER & WATER MAIN
3	STORM SEWER & STREET CONSTRUCTION
4	STREET GRADING PLAN
5 - 8	DETAILS

DRAWING NUMBER

DRAWING NUMBER

DRAWING NUMBER

DRAWING NUMBER
VANDE 03
1

Van Den Berg
Property—2003