

Record Drawings

for

Sanitary Sewer, Water Main, Storm Sewer, and Streets

for

Van Den Berg Property Elk River, Minnesota

Prepared for:

Bob Van Den Berg
 10811 181st Avenue Northwest
 Elk River, Minnesota 55330
 Contact: Bob Van Den Berg
 Phone: 763-574-9480
 Fax: 763-574-9486


Prepared by



Westwood Professional Services
 7699 Anagram Drive
 Eden Prairie, MN 55344
 PHONE 952-461-1150
 FAX 952-461-8222
 TOLL FREE 1-800-461-1150

Project Number: 2001059
 Drawing Number: 1001

Vicinity Map

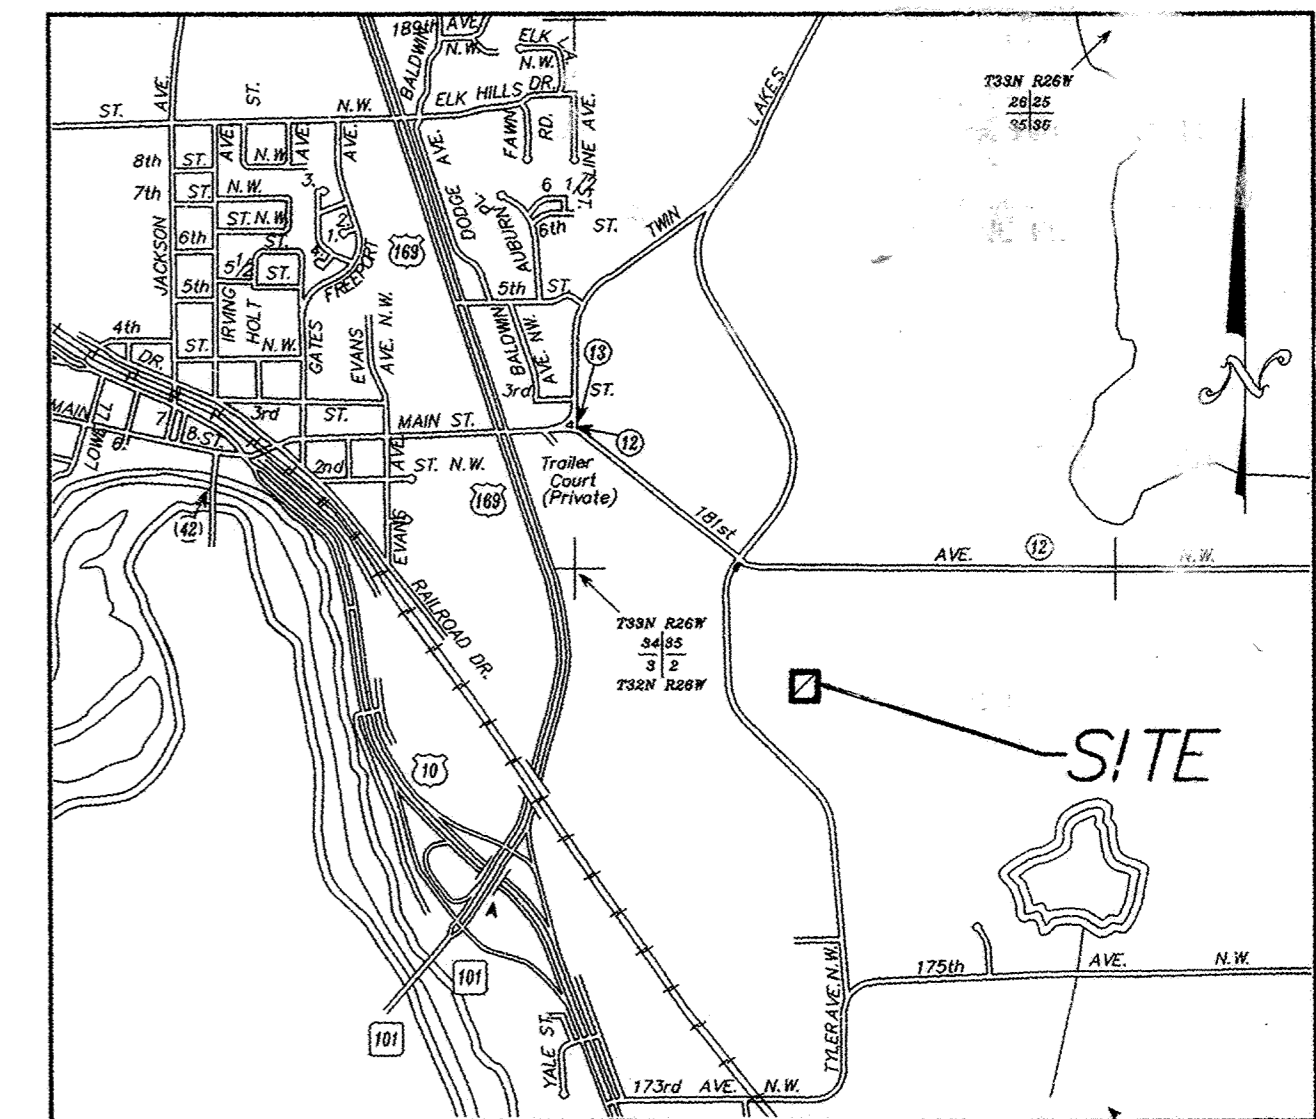

ELK RIVER
No Scale

NO.	DATE	REVISION	SHEETS
1	08/16/02	CITY REVIEW-CLJ	1-4
2	03/20/06	CLIENT COMMENTS	ALL
3	10/20/06	RECORD DRAWINGS	ALL
4	01/15/07	RECORD DRAWINGS	ALL
5	04/26/07	FINAL RECORD DRAWINGS	ALL

CONTRACTOR: RYAN CONTRACTING CO.
 RECORD DRAWING
 CONFORMING TO CONSTRUCTION RECORDS.
 BY STEVE PFLIPSEN DATE 04/26/07
 WESTWOOD PROFESSIONAL SERVICES

INDEX	
SHEET NO.	DESCRIPTION
1	COVER
2	SANITARY SEWER & WATER MAIN
3	STORM SEWER & STREET CONSTRUCTION
4	STREET GRADING PLAN
5 - 8	DETAILS

Record Drawings

for

Sanitary Sewer, Water Main, Storm Sewer and Streets

for

Van Den Berg Property
 Elk River, Minnesota

Date: 07/19/02 Sheets: 1 of 8