
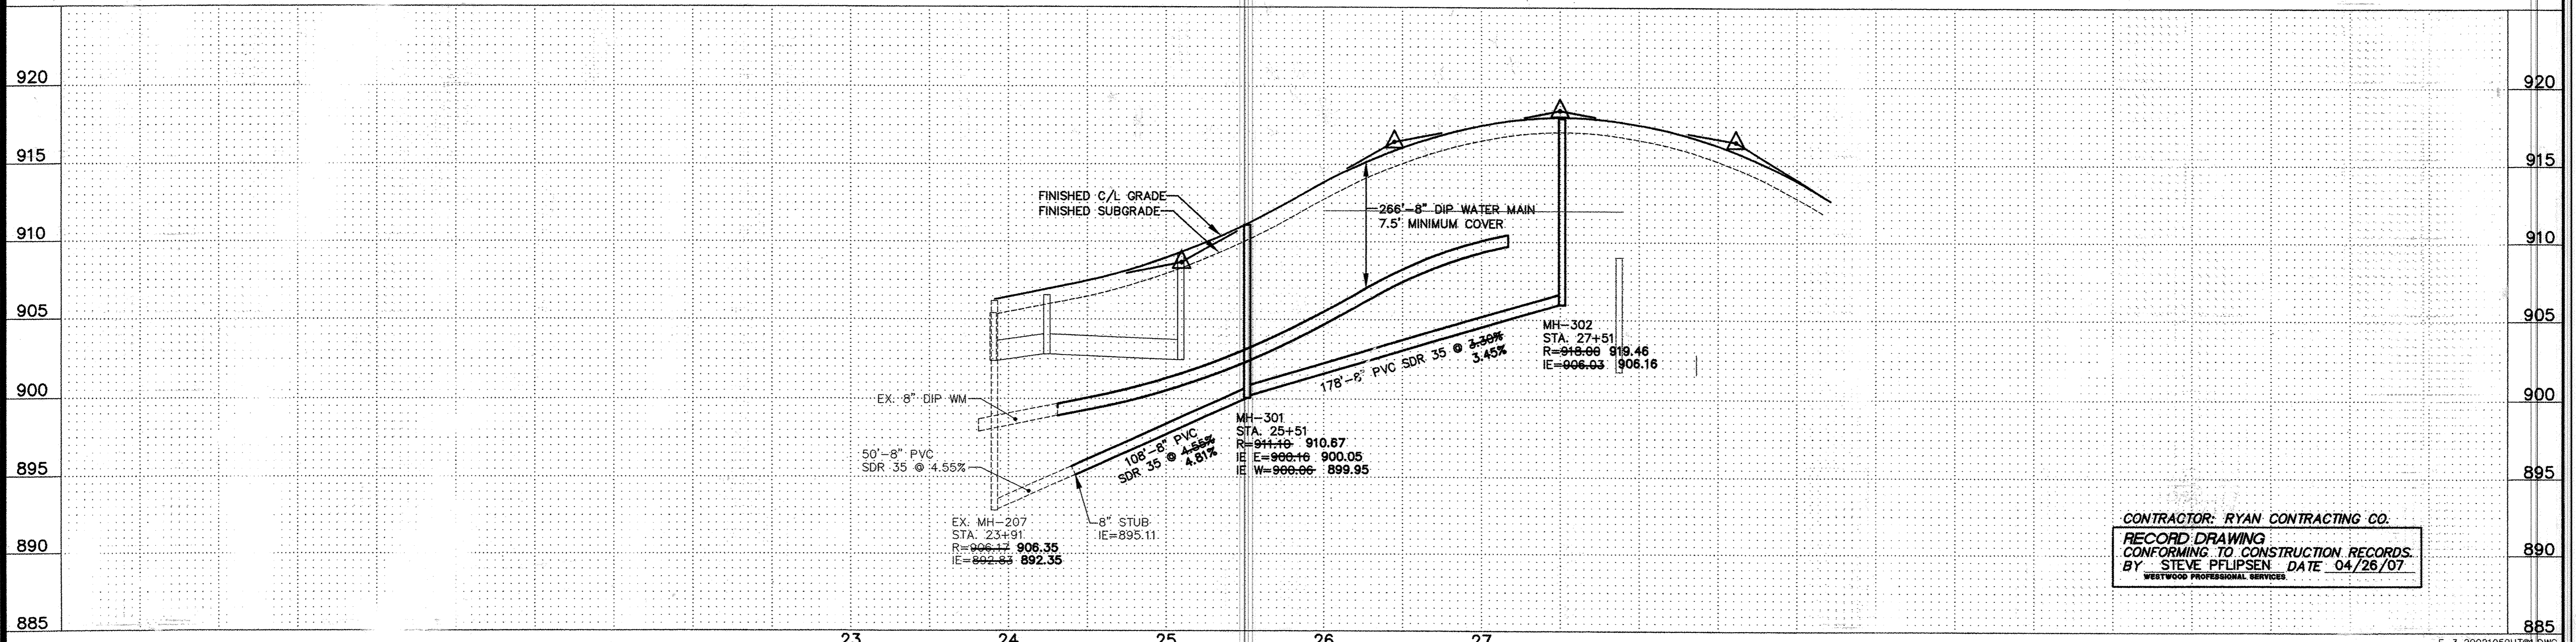
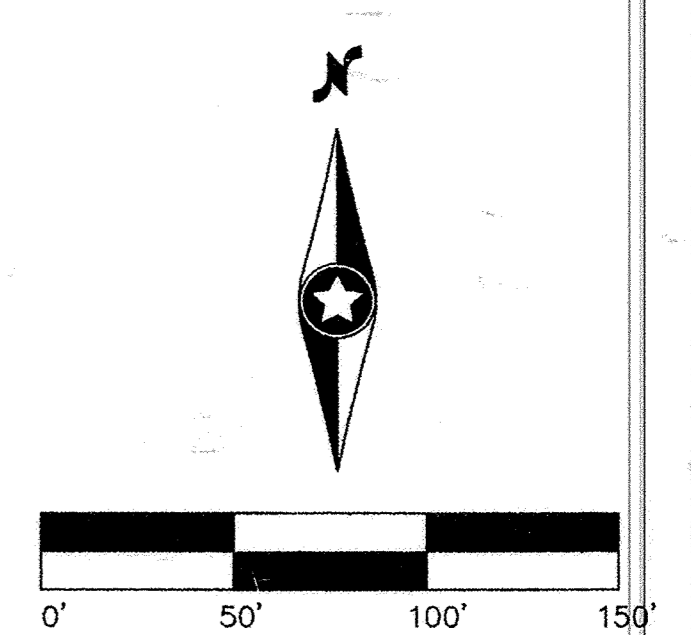


Call 48 Hours before digging:  
**GOPHER STATE ONE CALL**  
 Twin City Area 651-454-0002  
 Mn. Toll Free 1-800-252-1166

**GENERAL NOTES:**

- (XXX.X) DENOTES SANITARY SEWER SERVICE INVERT @ TOWNHOME PROPERTY LINE.
- WYE=X+XX DENOTES SANITARY SEWER SERVICE WYE LOCATED ON MAINLINE FROM DOWN STREAM M.H.
- FLAG HYDRANTS.
- EXTEND RODS ON DEEP VALVES.
- ALL DROP MANHOLES TO BE CONSTRUCTED USING OUTSIDE DROPS.
- HYDRANTS TO BE PLACED 5' BEHIND CURB
- SERVICES TO BE EXTENDED 10' PAST R.O.W. UNLESS OTHERWISE NOTED.

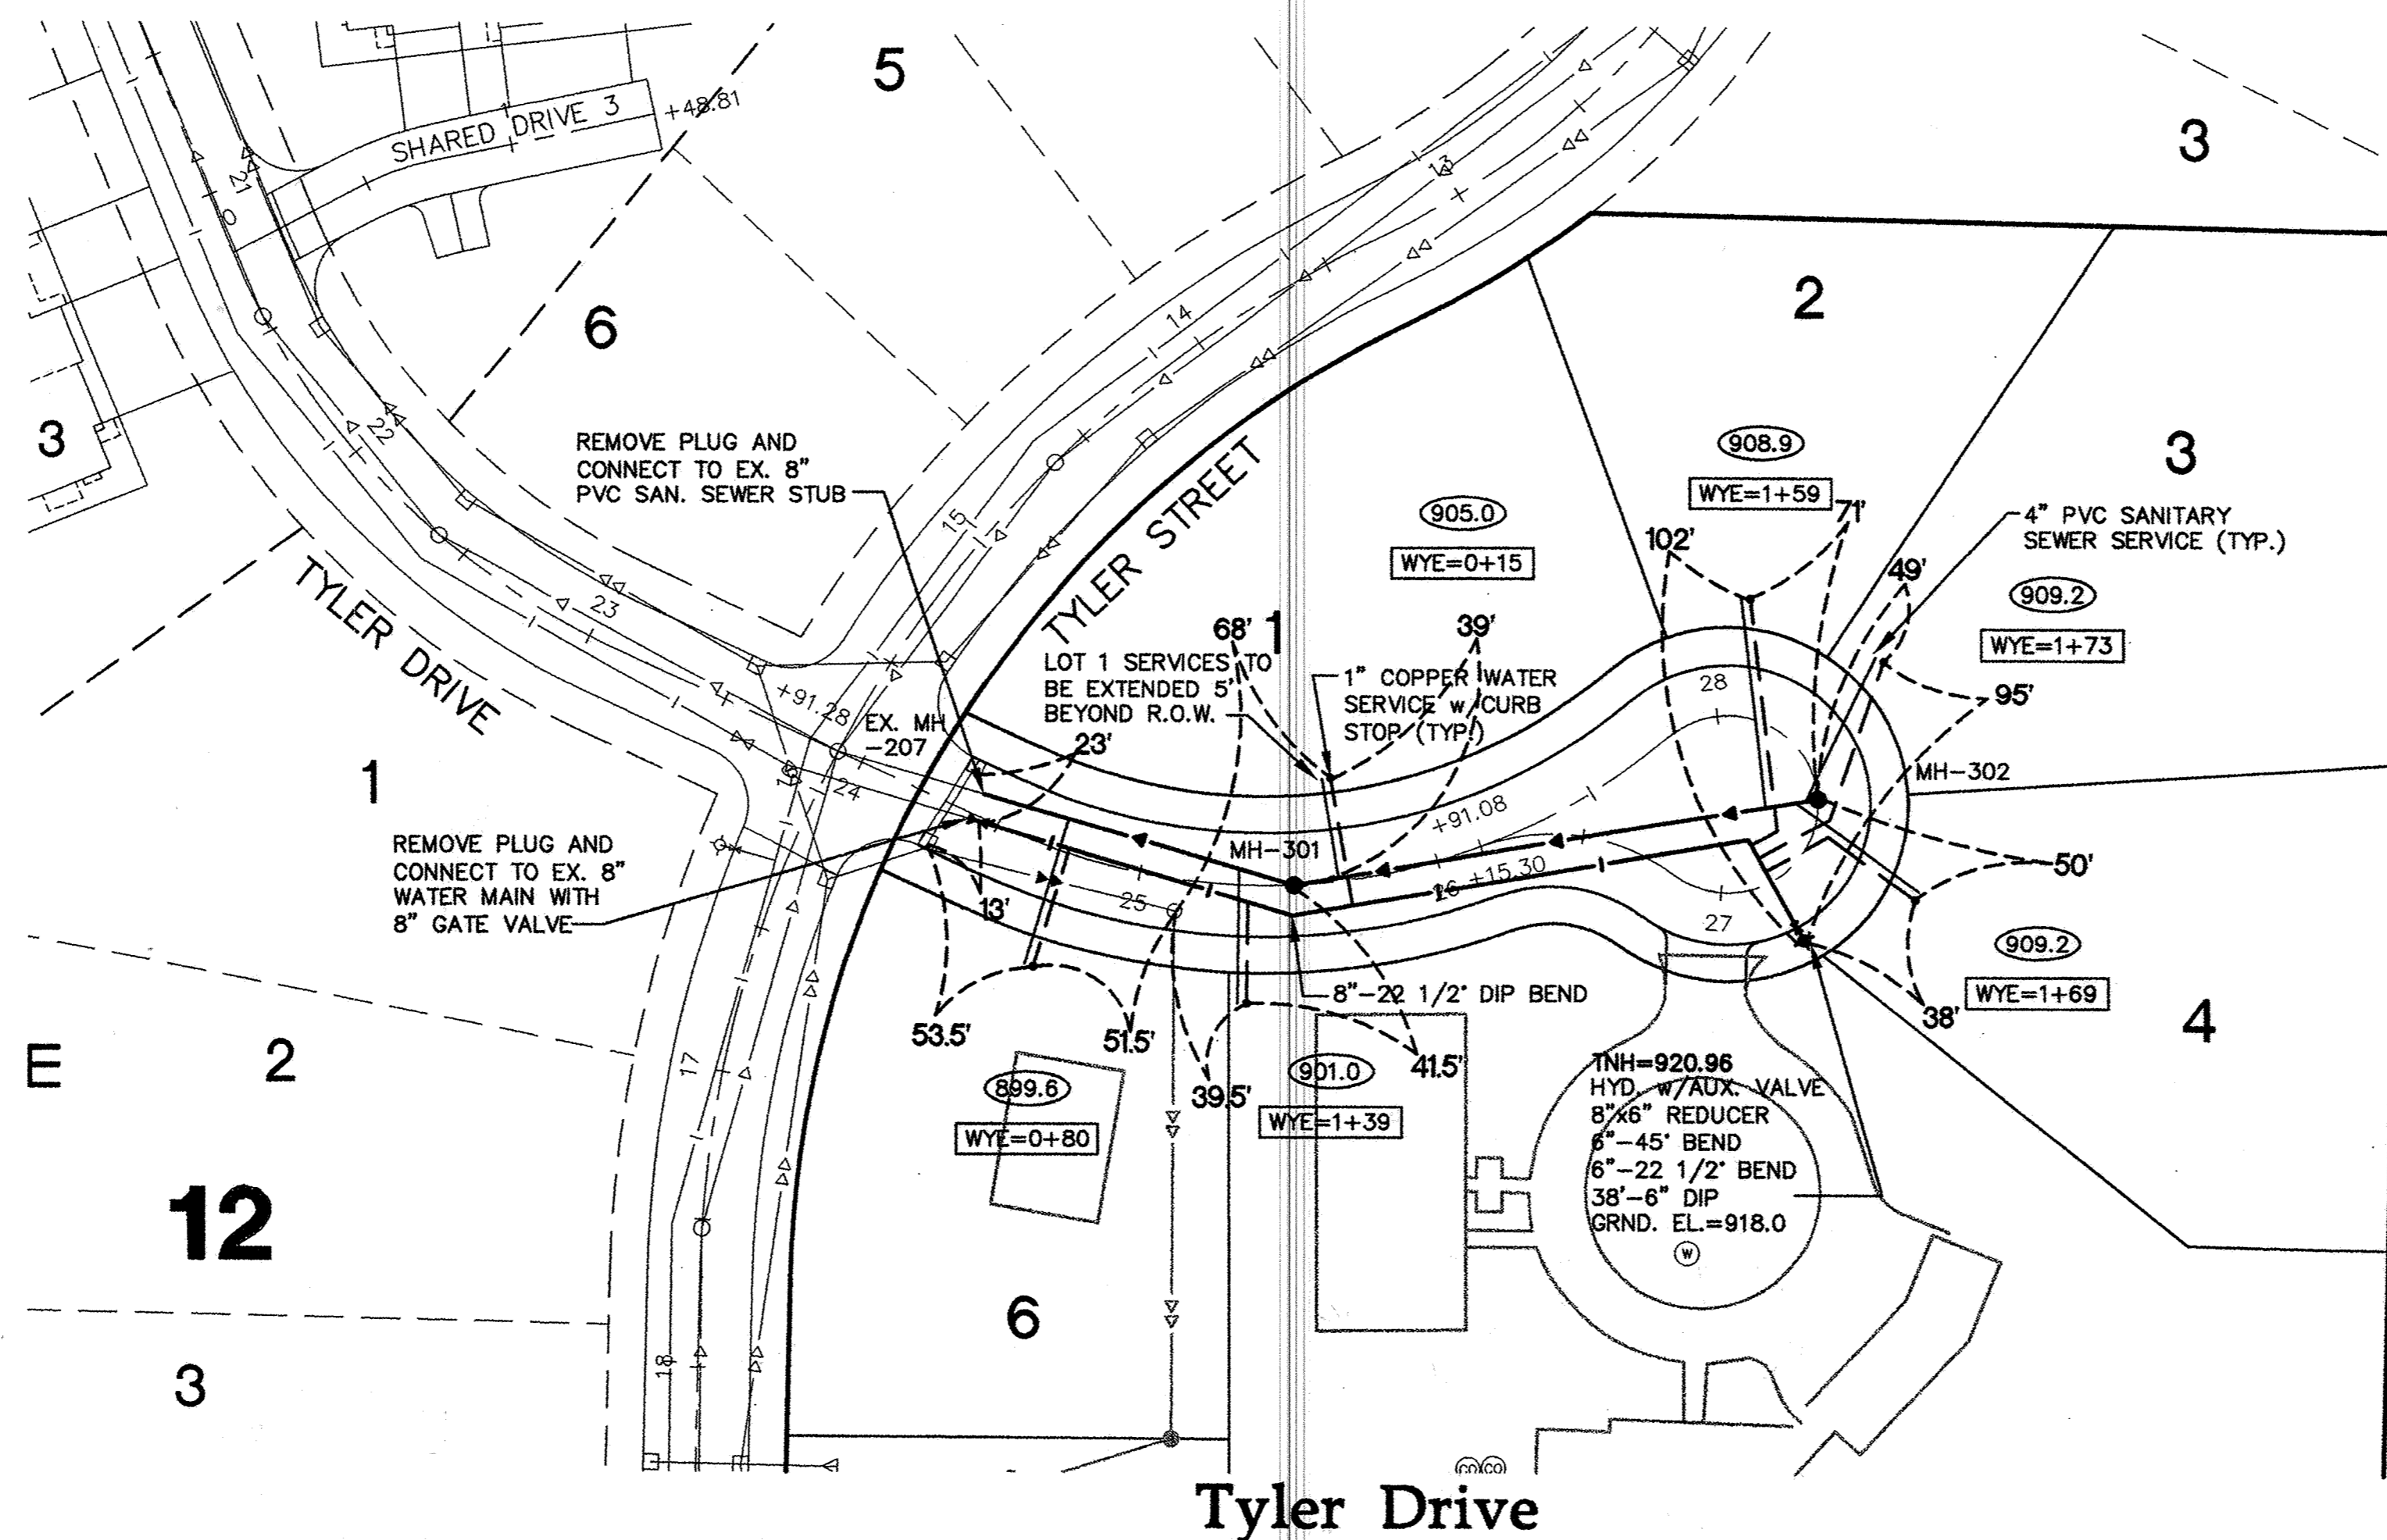

CONTRACTOR: RYAN CONTRACTING CO.  
 RECORD DRAWING CONFORMING TO CONSTRUCTION RECORDS.  
 BY STEVE PFLIPSEN DATE 04/26/07  
 WESTWOOD PROFESSIONAL SERVICES

E-3 20021059UT01.DWG  
 Latest Revision Date: 04/26/07  
 Date: 08/16/02 Sheet: 2 OF 8

**Westwood**  
 Westwood Professional Services, Inc.  
 7699 Anagram Drive  
 Eden Prairie, MN 55344  
 PHONE 952-937-5150  
 FAX 952-937-5822  
 TOLL FREE 1-888-937-5150  
 www.westwoodps.com

I hereby certify that this plan was prepared by me or under my direct supervision and that I am a duly licensed PROFESSIONAL ENGINEER under the laws of the State of Minnesota.  
 Francis D. Hagen, II  
 Date: 04/26/07 License No. 17716

Revisions:  
 08/16/02 CITY REVIEW-CLJ  
 03/25/06 CLIENT COMMENTS  
 10/20/06 RECORD DRAWINGS (06B) 04/26/07 FINAL RECORD DRAWINGS (SWW)  
 01/15/07 RECORD DRAWINGS (SWW)

Designed: FDH, II  
 Checked: JMM  
 Drawn: WH/ENS  
 Record Drawing by/date: 4/26/07 AS

Prepared for:  
**Bob Van Den Berg**  
 10811 181st Avenue Northwest  
 Elk River, Minnesota 55330

**Van Den Berg Property**  
 Elk River, Minnesota

**Sanitary Sewer and Water Main Construction Plan**  
 Tyler Drive

F:\20021059\DWG\RECORD\20021059UT01.dwg 1/15/2007 9:21:58 AM CST

SARGO PRODUCTS • NEW HOPE, MINNESOTA  
 REPRODUCED BY PART NUMBER 6532  
 SARGO PRODUCTS • NEW HOPE, MINNESOTA  
 REPRODUCED BY PART NUMBER 6532  
 SARGO PRODUCTS • NEW HOPE, MINNESOTA  
 REPRODUCED BY PART NUMBER 6532  
 SARGO PRODUCTS • NEW HOPE, MINNESOTA  
 REPRODUCED BY PART NUMBER 6532