


DRAWING NUMBER


DRAWING NUMBER

DRAWING NUMBER

DRAWING NUMBER

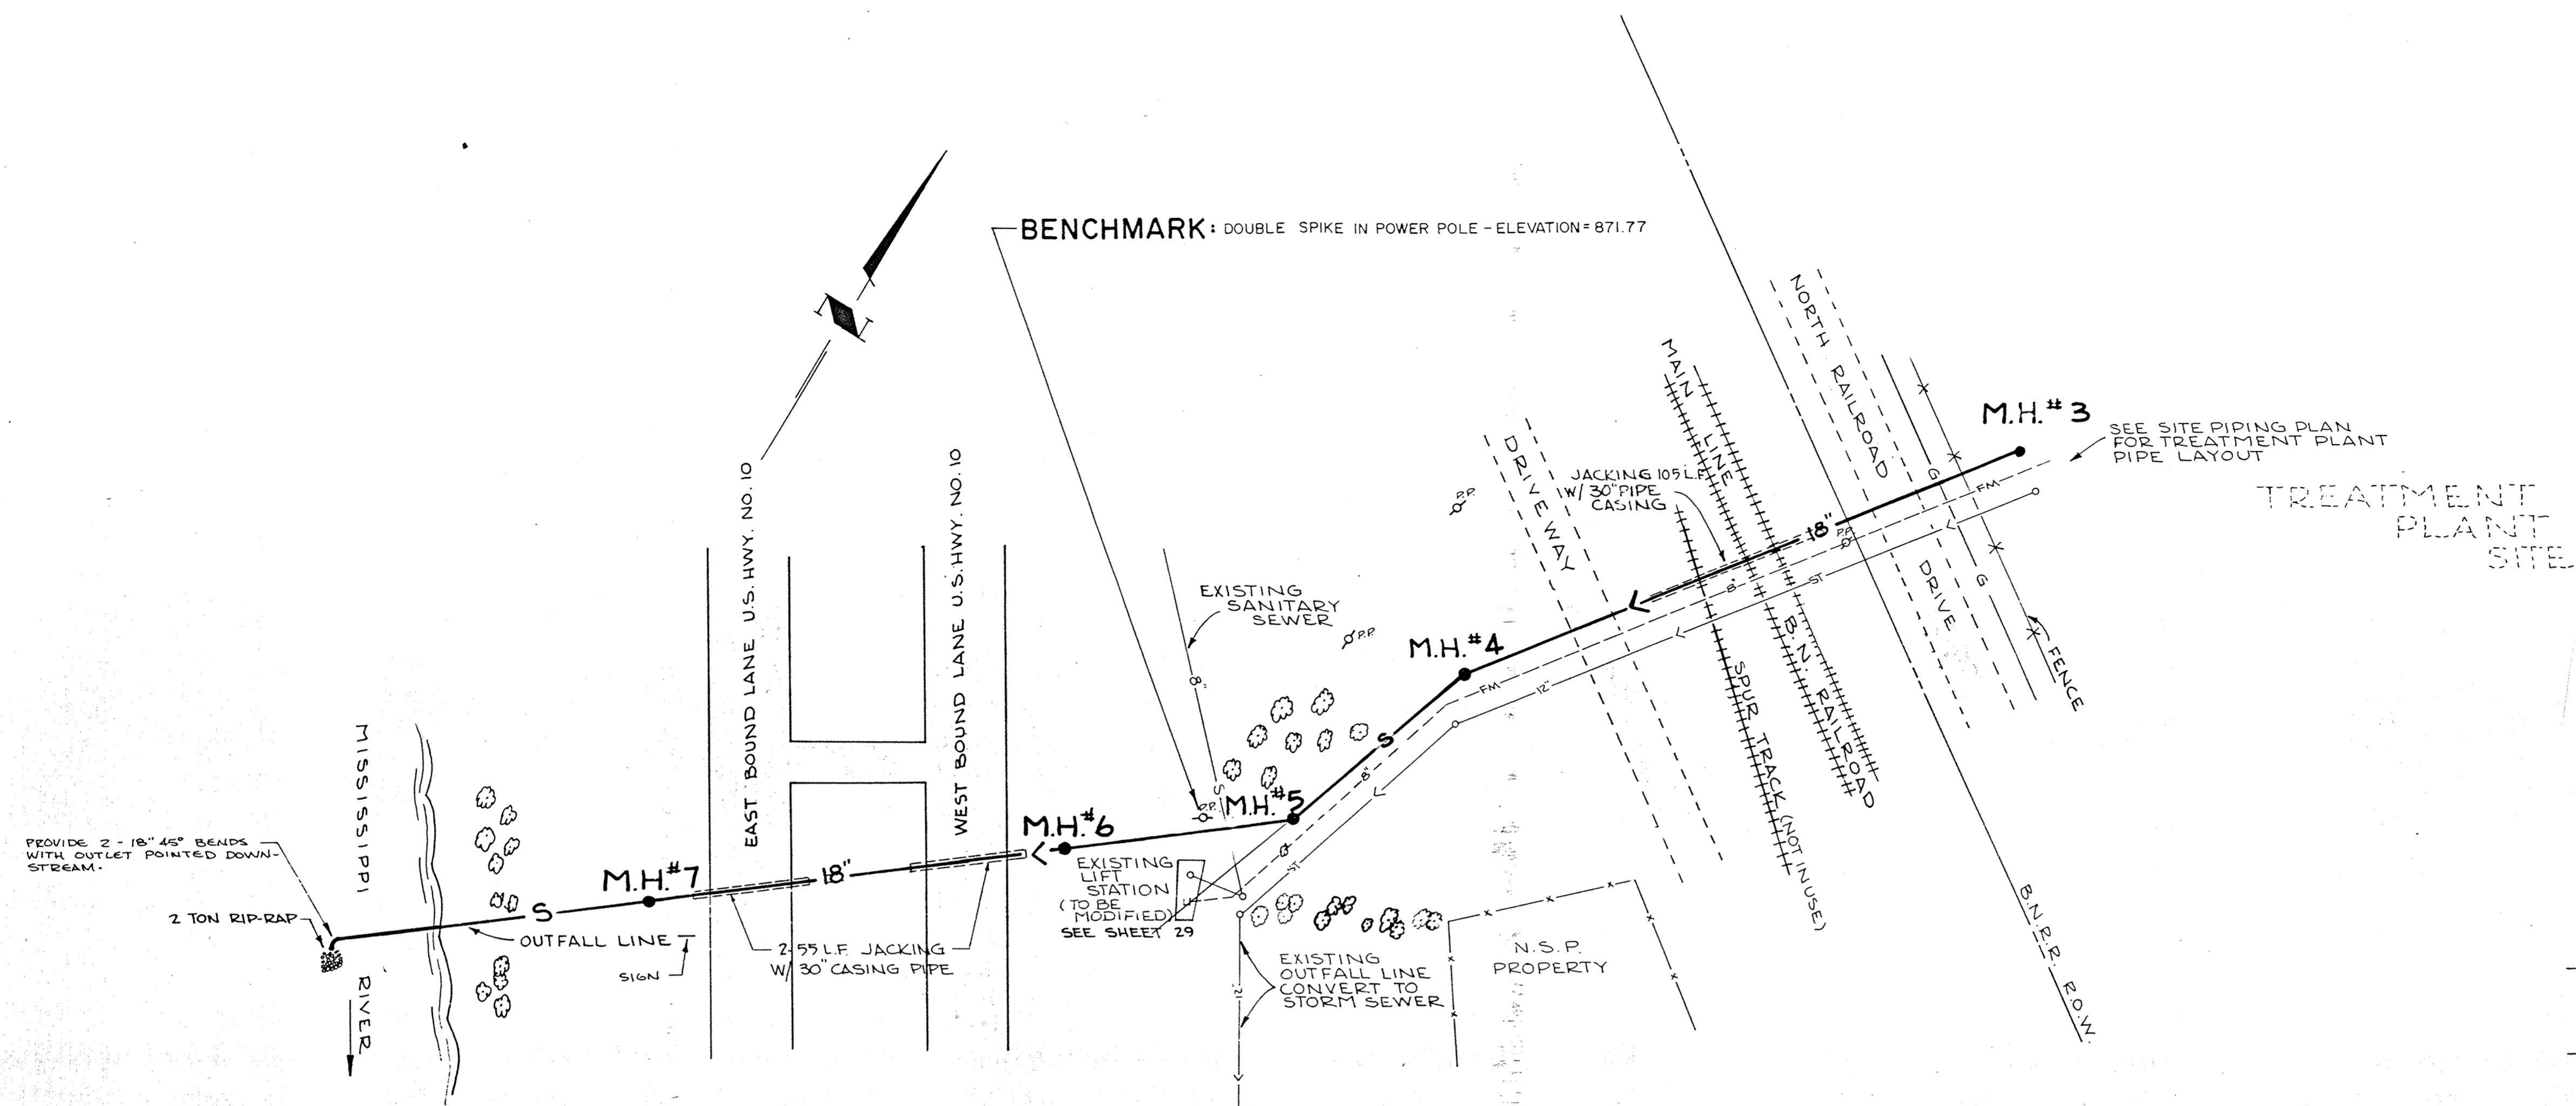

SCALE:  
 HORIZ. 1" = 50'  
 VERT. 1" = 10'

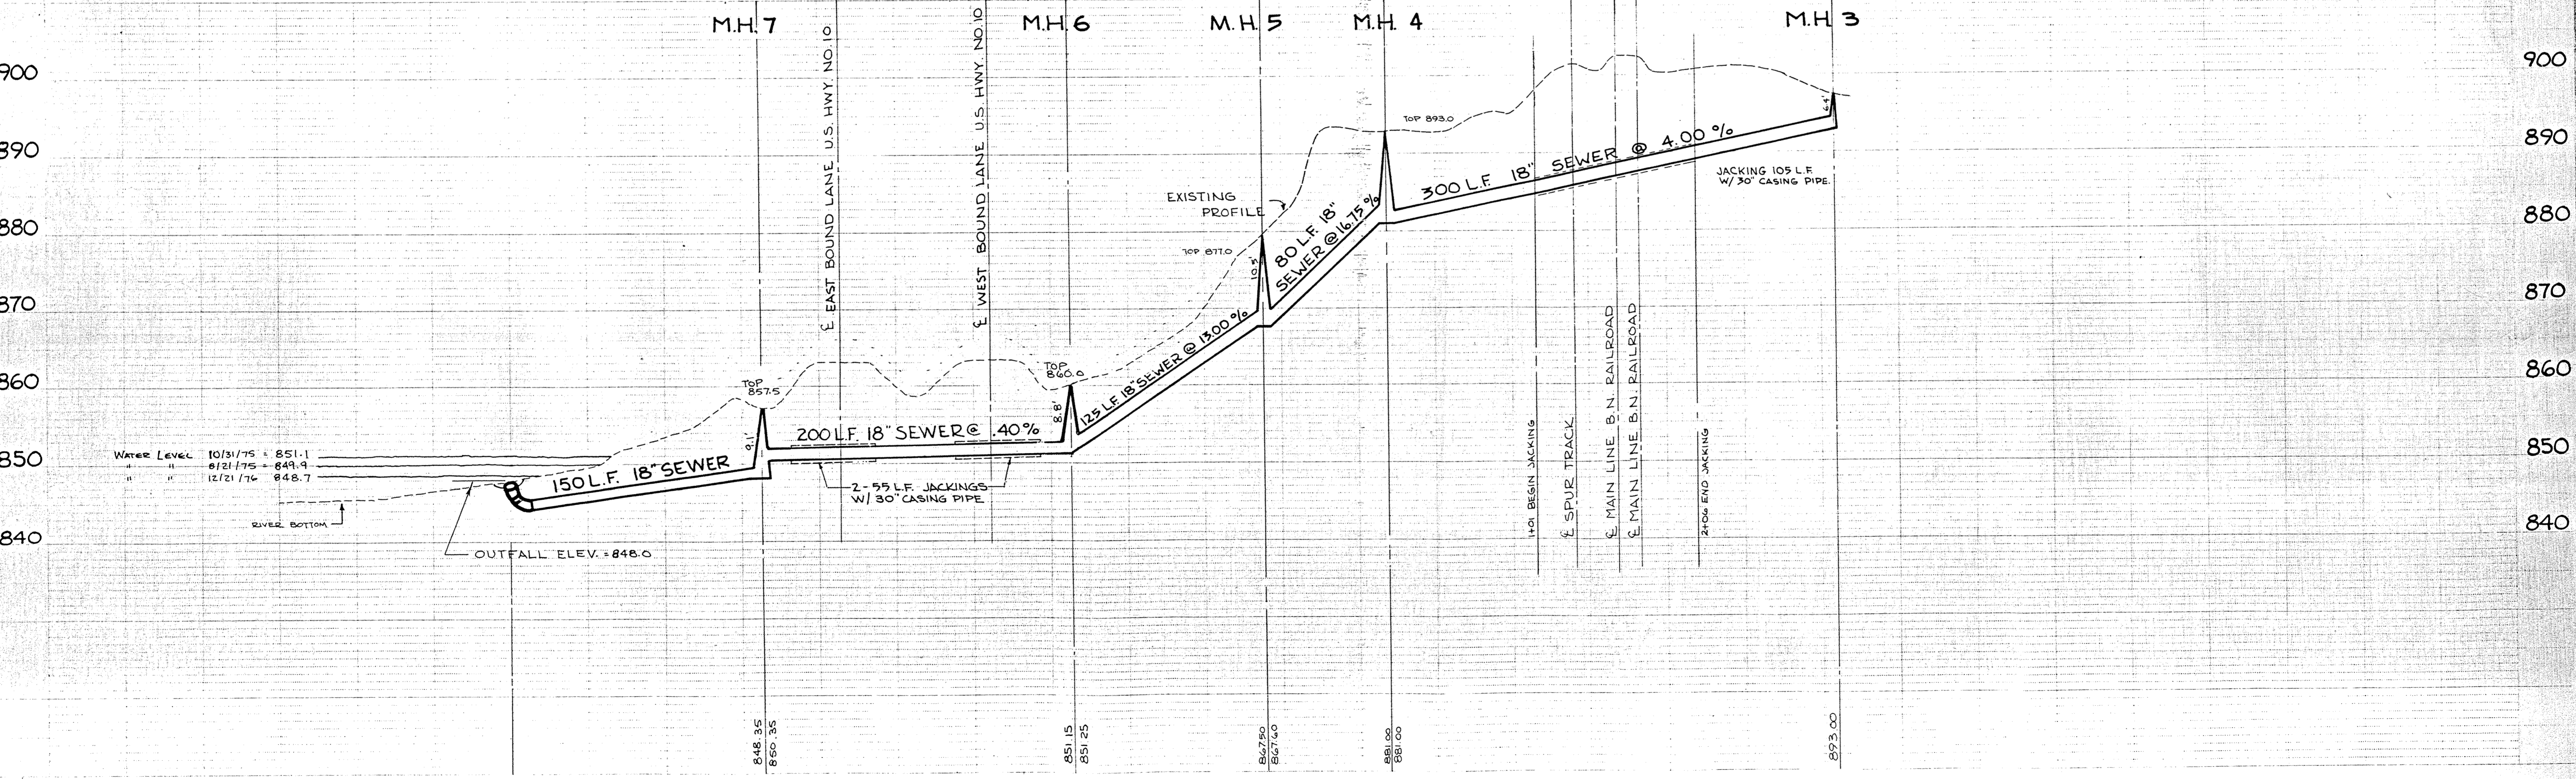

NO.	DATE	BY	REVISIONS
D	2-23-79	T.L.C.	AS BUILT
C	1-4-77	P.W.R.	REVISED PROFILE FROM M.H. 5 WEST (MCL RIVER)
B	12-21-76	J.R.C.	CHANGED LENGTH OF RR JACKING
A	7-6-76	J.R.C.	MISC. REVISIONS

DESIGNED BY: K.L.V.  
 DRAWN BY: J.J.A.  
 DATE: 8/26/75

CHECKED BY: K.L.V.  
 APPROVED BY: W.H.M.  
 DATE: Aug 29, 1975 REG. NO. 10159

*Karen Van Raeken*

McCOMBS-KNUTSON ASSOCIATES, INC.  
 CONSULTING ENGINEERS AND SUPERVISORS  
 1101 BROADWAY, MINNEAPOLIS, MINN. 55402

WASTE WATER TREATMENT FACILITIES  
 FOR  
 ELK RIVER, MINNESOTA

SHEET NO.	TOTAL SHEETS	DATE
6	6	D
31		

2603