
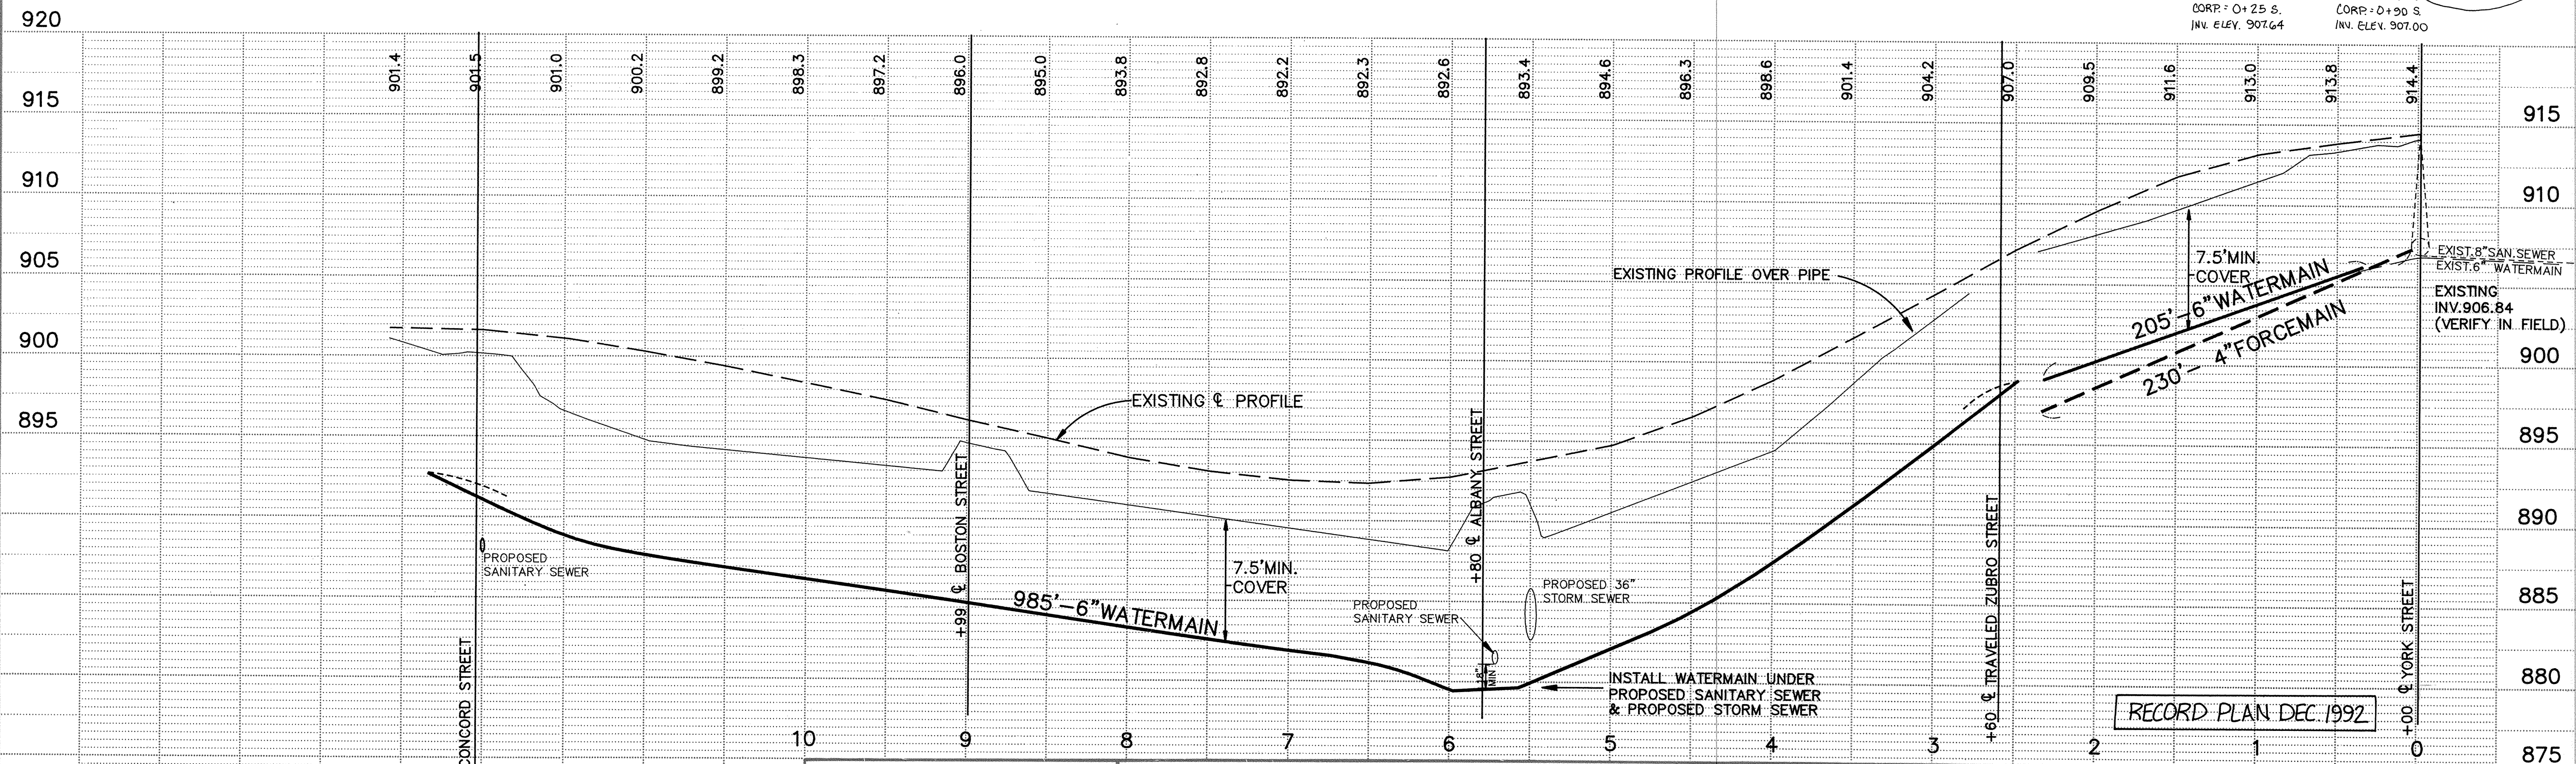


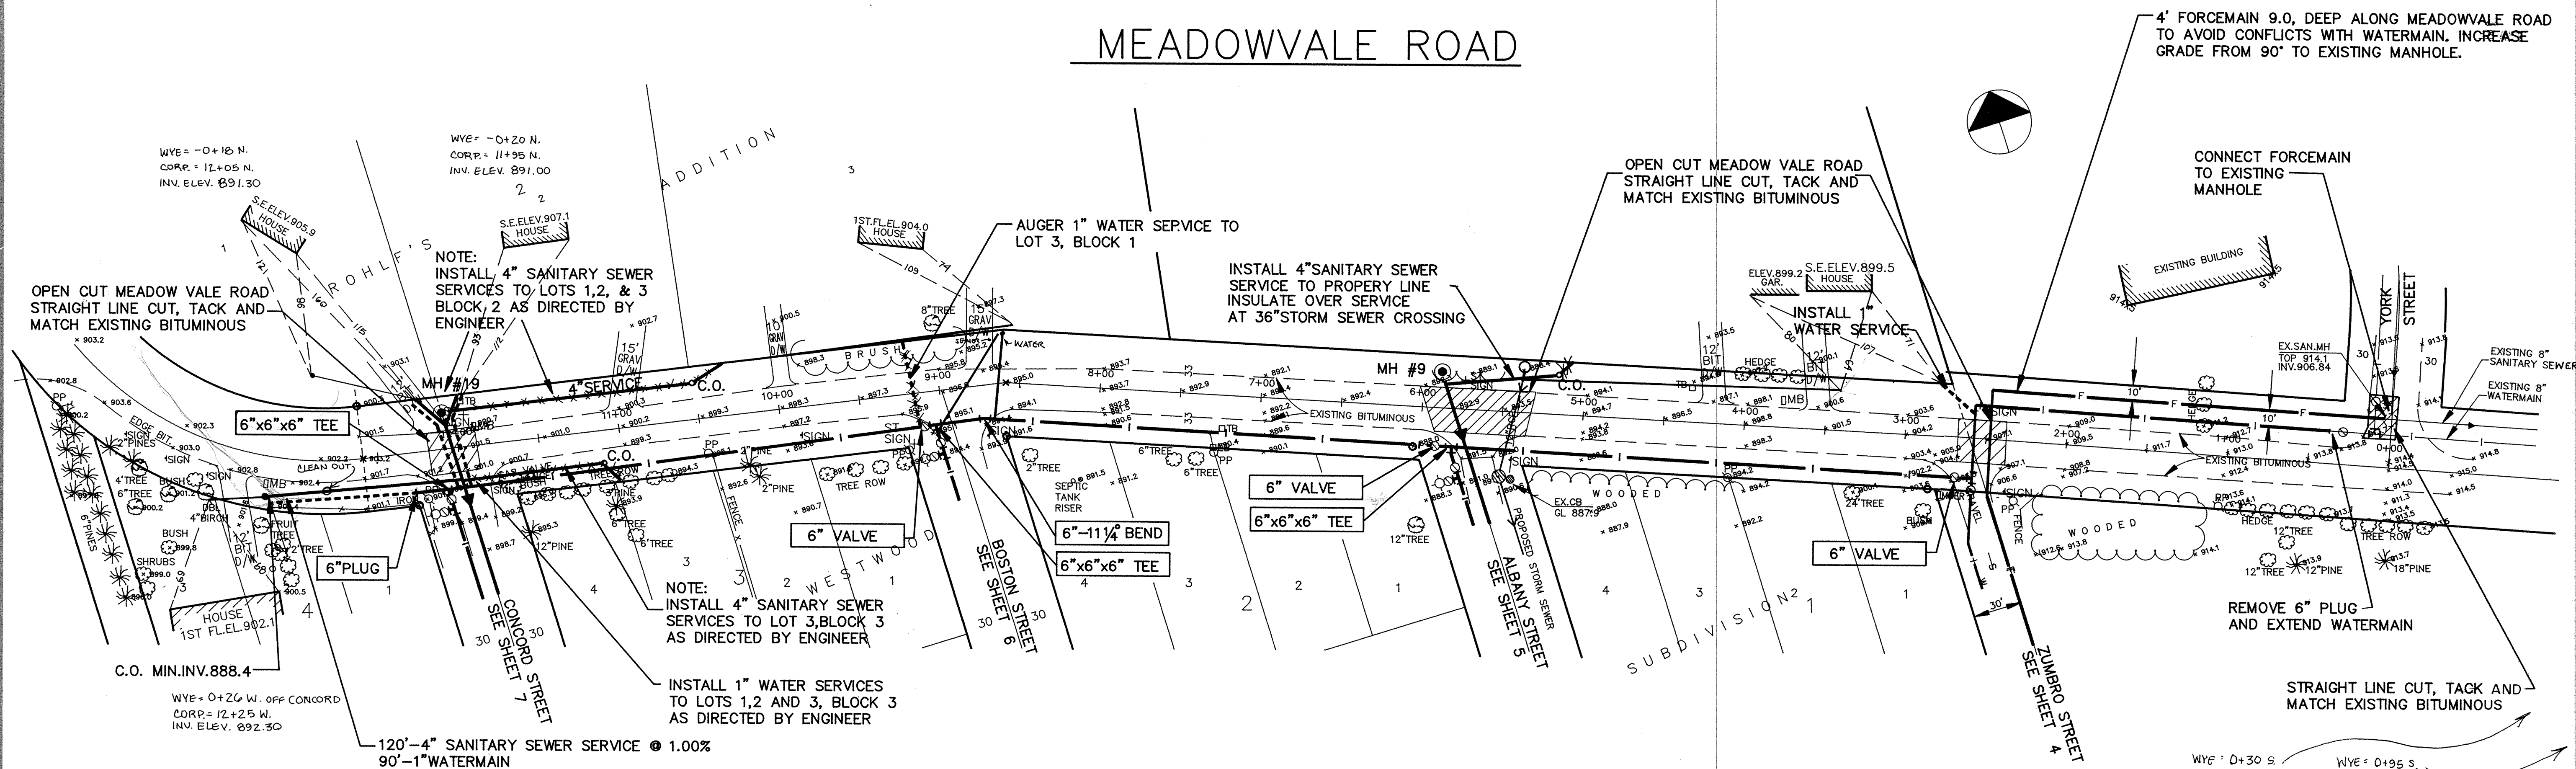

I HEREBY CERTIFY THAT THIS PLAN, SPECIFICATION, OR REPORT WAS PREPARED BY ME OR UNDER MY DIRECT SUPERVISION AND THAT I AM A DULY REGISTERED PROFESSIONAL ENGINEER UNDER THE LAWS OF THE STATE OF MINNESOTA.

Terry J. Maurer

DATE 2/6/92 REG. NO. 15316

WSA
9800 SHELARD PARKWAY
1959 SLOAN PLACE

CONSULTING ENGINEERS
Maier Stewart & Associates Inc.
(612) 546-0432 MINNEAPOLIS, MINNESOTA 55447
(612) 774-6021 ST. PAUL, MINNESOTA 55117

REVISIONS	DATE		DESCRIPTION

DESIGNED _____
CHECKED _____
DRAWN <i>[Signature]</i>
GRAPHIC SCALE
0 HORIZ. 50
0 VERT. 5

CITY OF ELK RIVER
SANITARY SEWER, FORCEMAIN AND WATERMAIN
MEADOWVALE ROAD

SANITARY SEWER, FORCEMAIN AND WATERMAIN
MEADOWVALE ROAD

DATE	JAN, 1992	SHEET	3	OF	23	SHEETS	PROJECT NO.	230-116
------	-----------	-------	---	----	----	--------	-------------	---------