
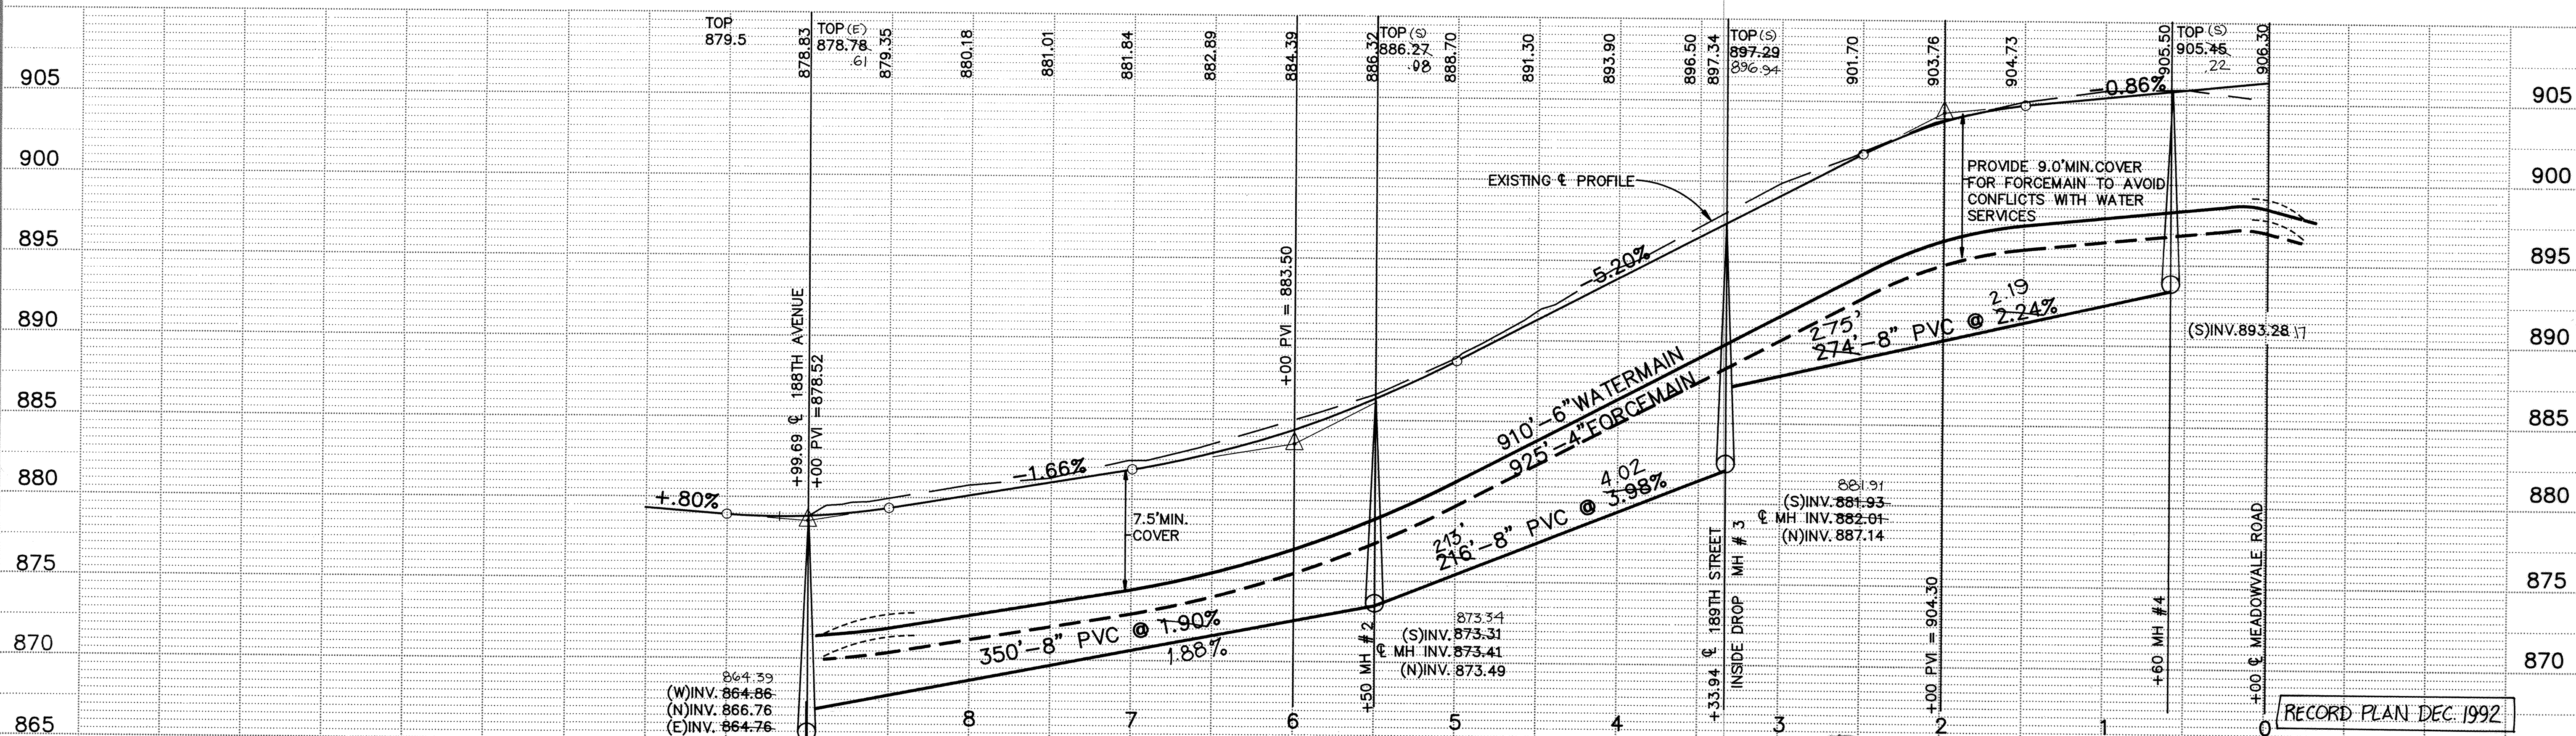
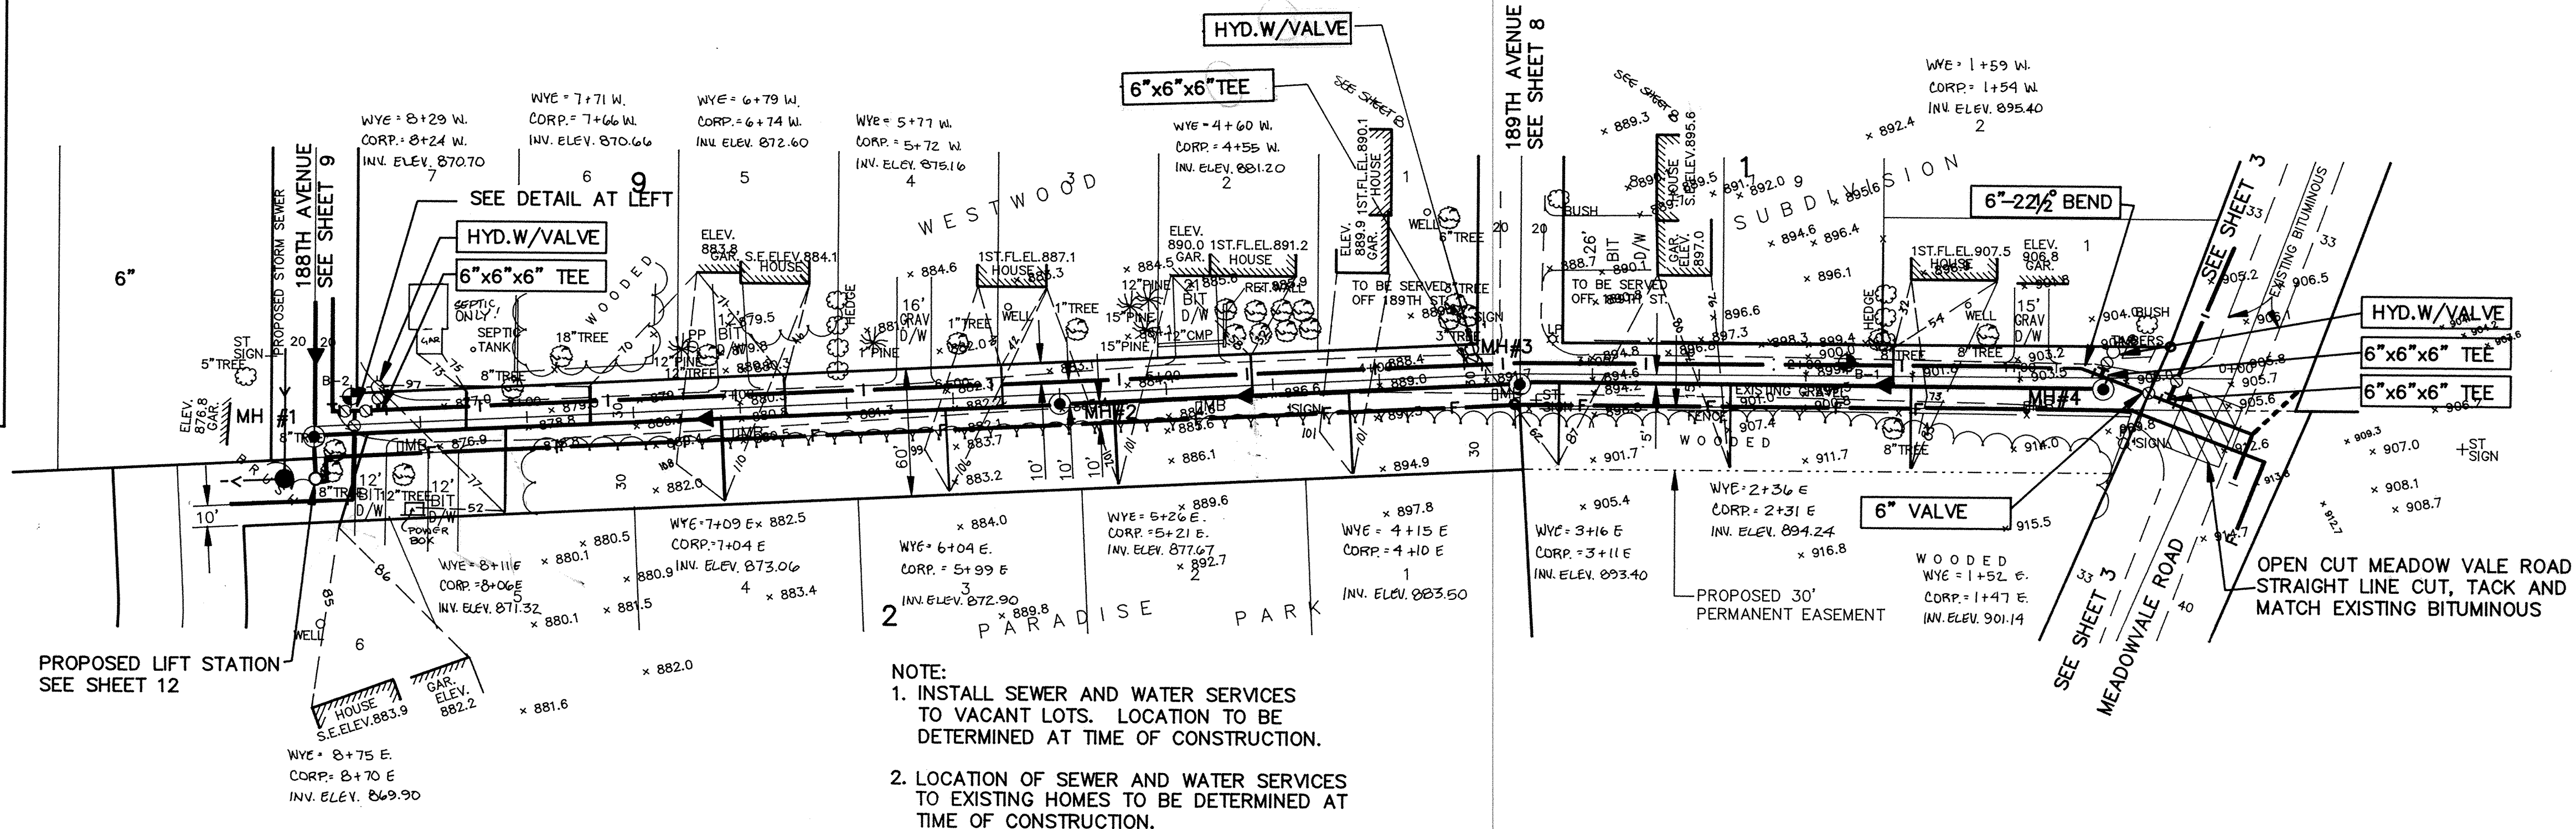


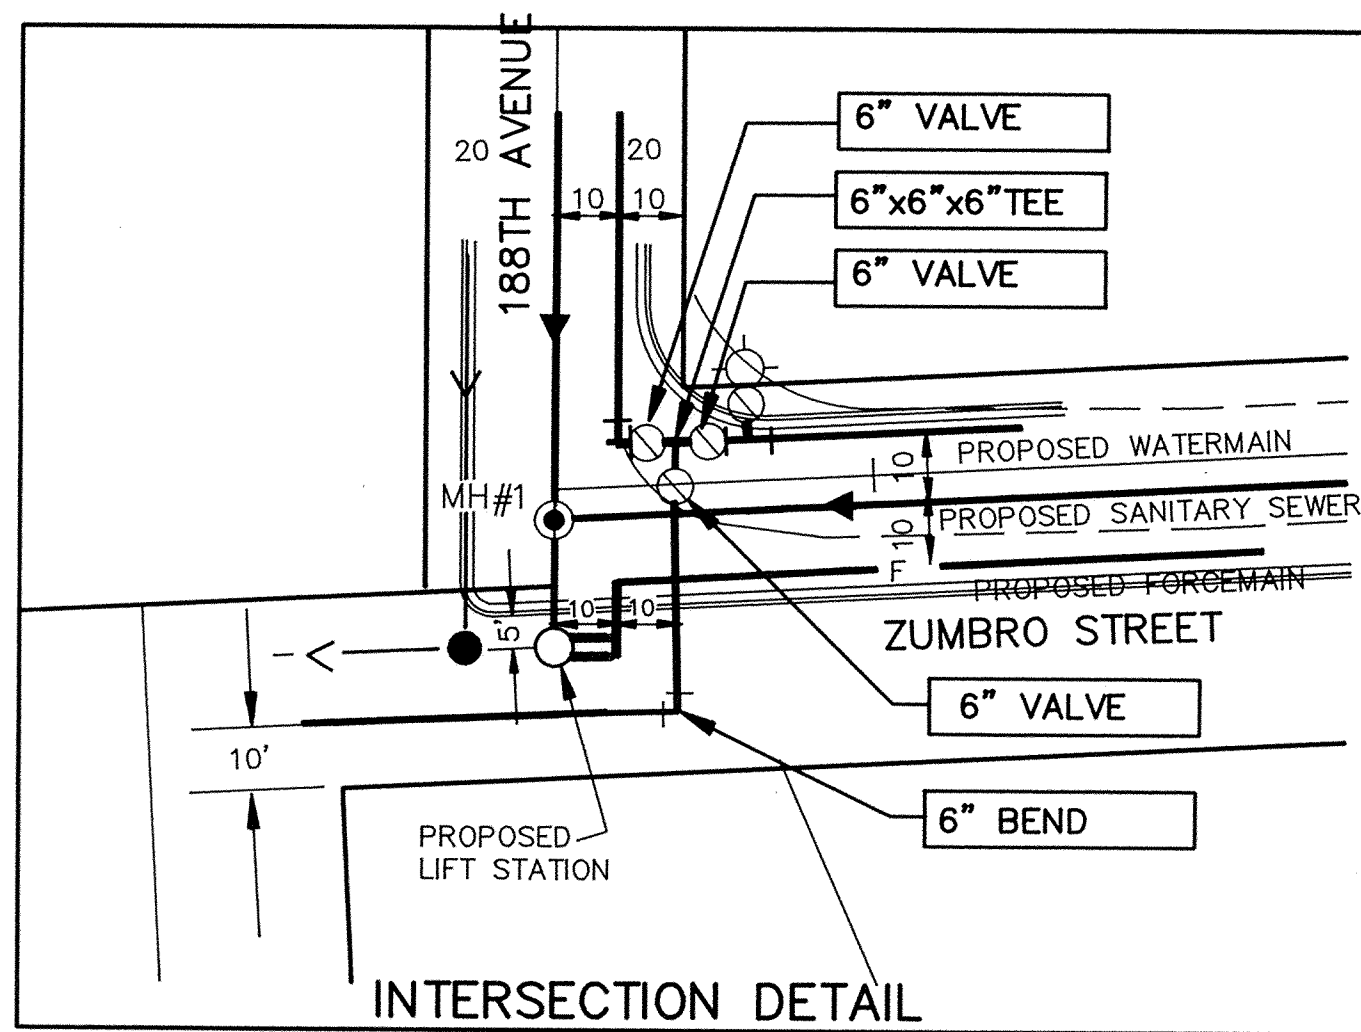

I HEREBY CERTIFY THAT THIS PLAN, SPECIFICATION, OR REPORT WAS PREPARED BY ME OR UNDER MY DIRECT SUPERVISION AND THAT I AM A DULY REGISTERED PROFESSIONAL ENGINEER UNDER THE LAWS OF THE STATE OF MINNESOTA.

Ken J. Maier
DATE 2/4/92 REG. NO. 15316

MSA
8900 SHELARD PARKWAY
1959 SLOAN PLACE

CONSULTING ENGINEERS
Maier Stewart & Associates Inc.
(612) 546-0432
(612) 774-6021
MINNEAPOLIS, MINNESOTA 55441
ST. PAUL, MINNESOTA 55117

DATE	DESCRIPTION

DESIGNED	CHECKED

CIT OF ELK RIVER
SANITARY SEWER, FORCEMAIN AND WATERMAIN
ZUMBRO STREET

DATE JAN, 1992 SHEET 4 OF 23 SHEETS PROJECT NO. 230-116