



DRAWING NUMBER

DRAWING NUMBER


DRAWING NUMBER

DRAWING NUMBER

ALBANY STREET

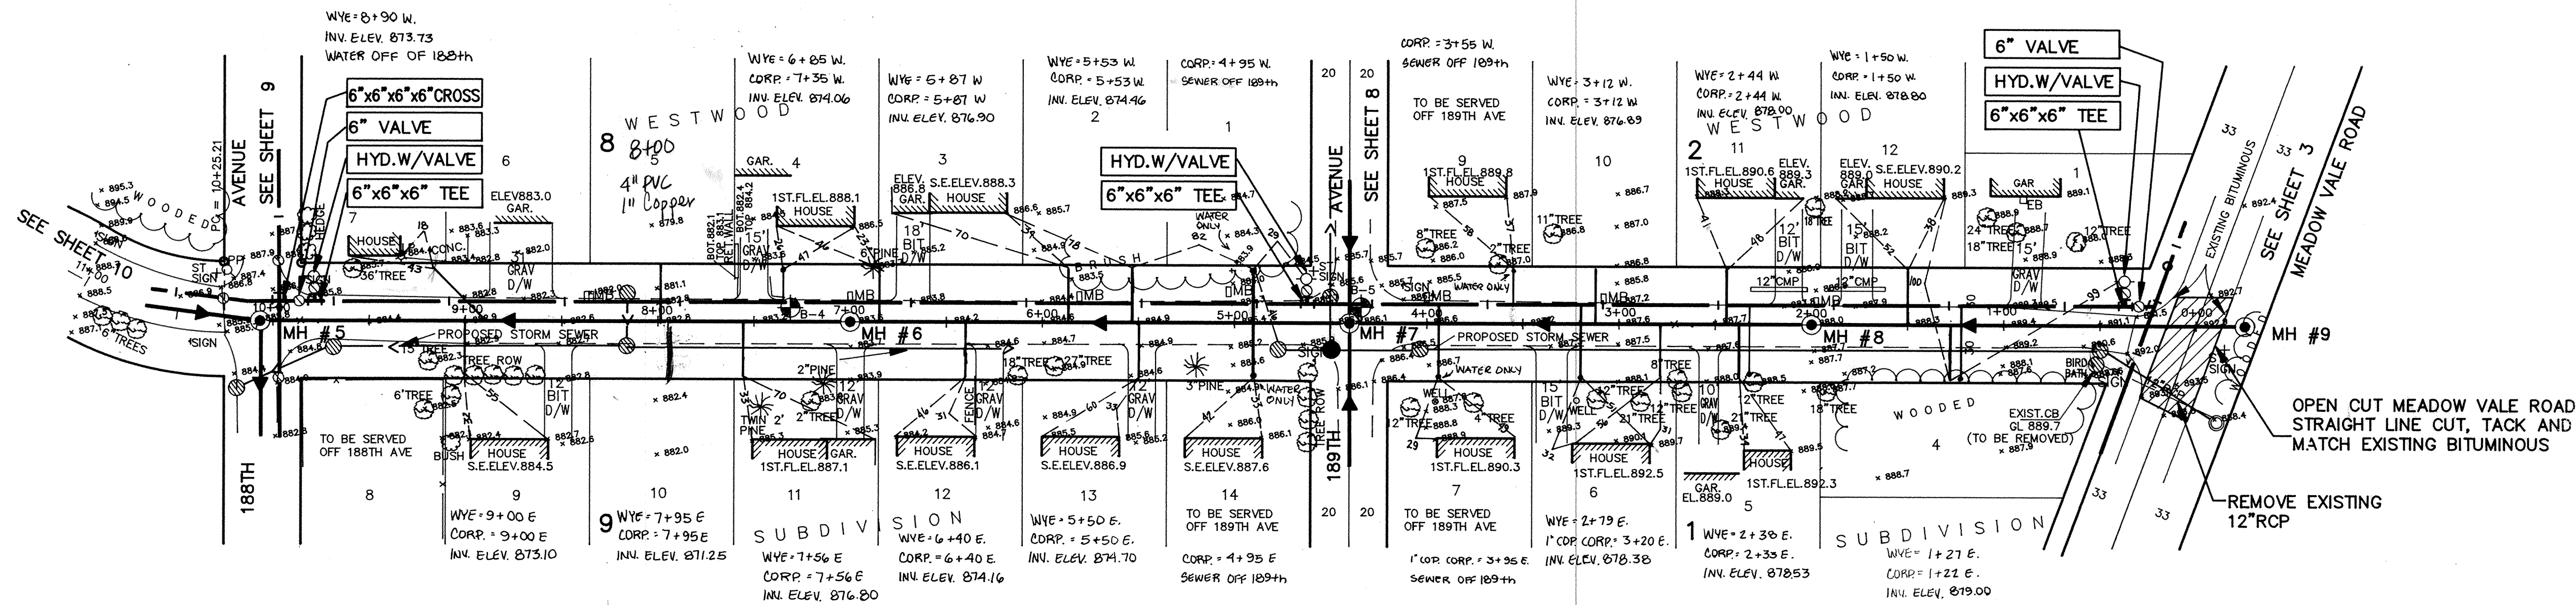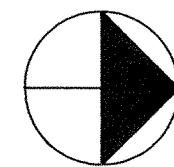

- NOTE:
1. INSTALL SEWER AND WATER SERVICES TO VACANT LOTS. LOCATION TO BE DETERMINED AT TIME OF CONSTRUCTION.
 2. LOCATION OF SEWER AND WATER SERVICES TO EXISTING HOMES TO BE DETERMINED AT TIME OF CONSTRUCTION.

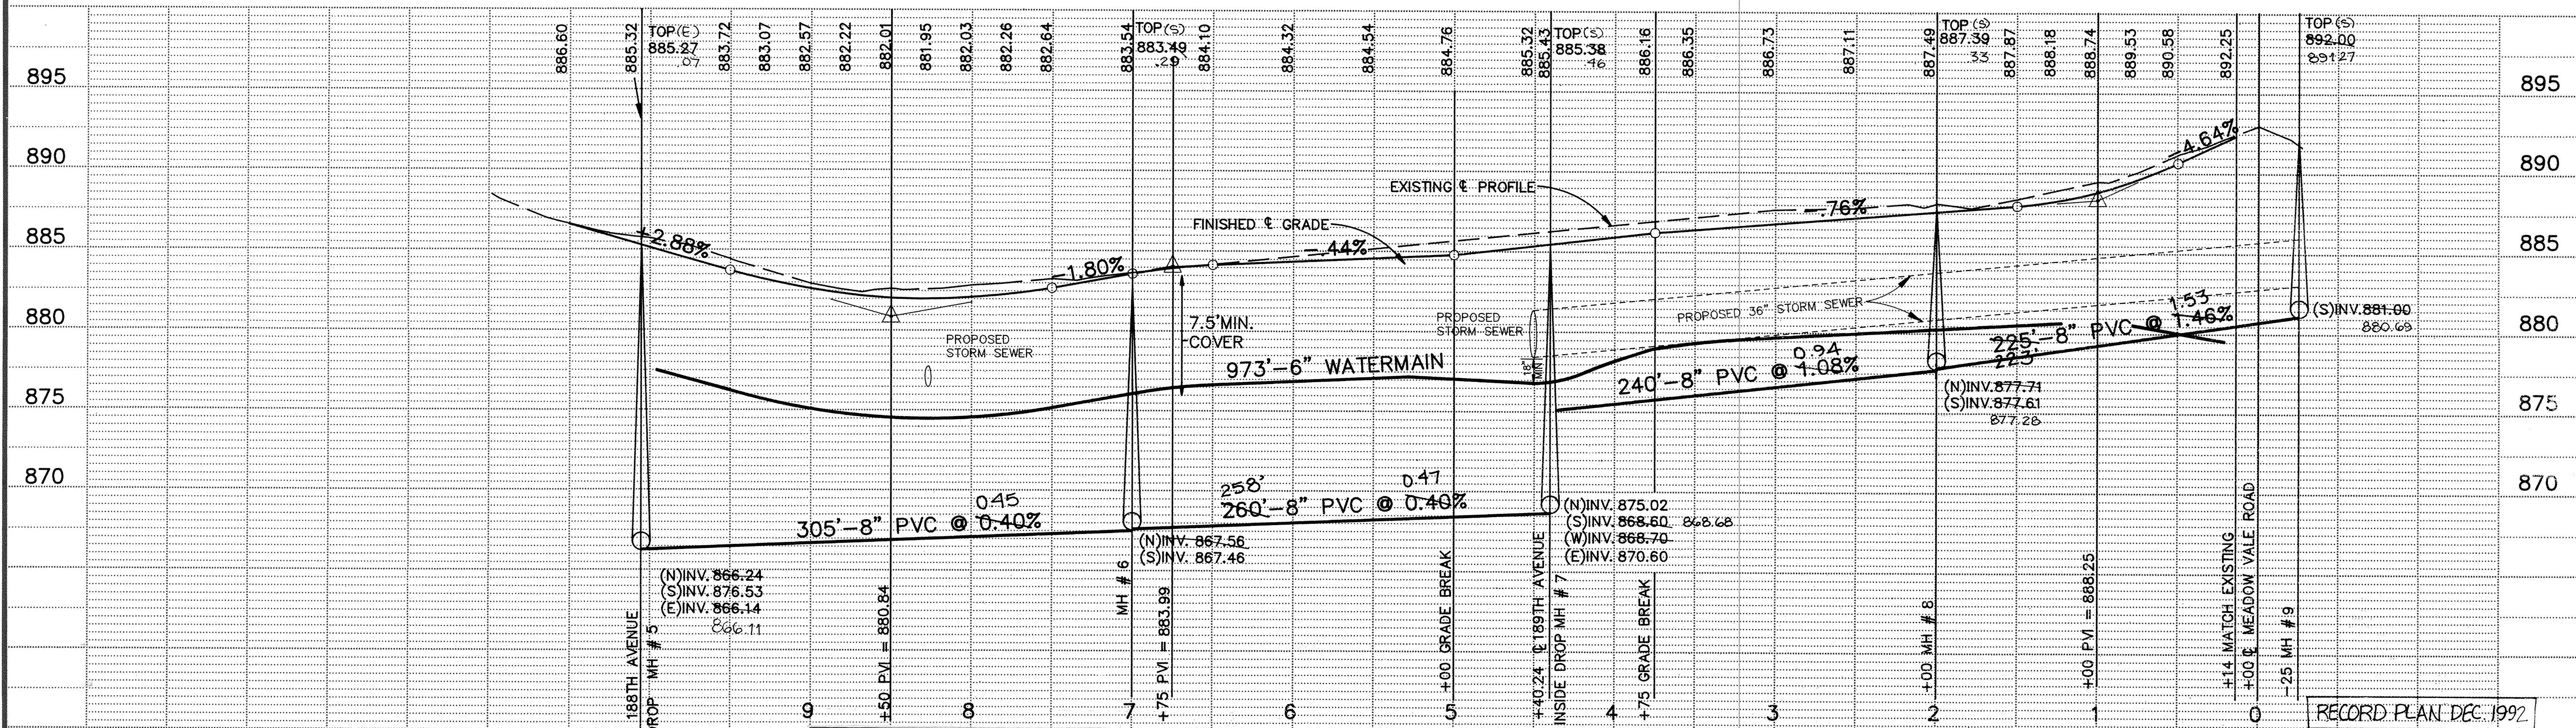

I HEREBY CERTIFY THAT THIS PLAN, SPECIFICATION, OR REPORT WAS PREPARED BY ME OR UNDER MY DIRECT SUPERVISION AND THAT I AM A DULY REGISTERED PROFESSIONAL ENGINEER UNDER THE LAWS OF THE STATE OF MINNESOTA.

Terry Maier
DATE 2/16/92 REG. NO. 15316

MSA CONSULTING ENGINEERS
Maier Stewart & Associates Inc.
1959 SLOAN PLACE (612) 774-6021 ST. PAUL, MINNESOTA 55117

REVISIONS	DATE	DESCRIPTION	DESIGNED	CHECKED	DRAWN

GRAPHIC SCALE
0 HORIZ. 50
0 VERT. 5

CITY OF ELK RIVER
SANITARY SEWER AND WATERMAIN
ALBANY STREET

DATE NOV. 1991 SHEET 5 OF 23 SHEETS PROJECT NO. 230-116