

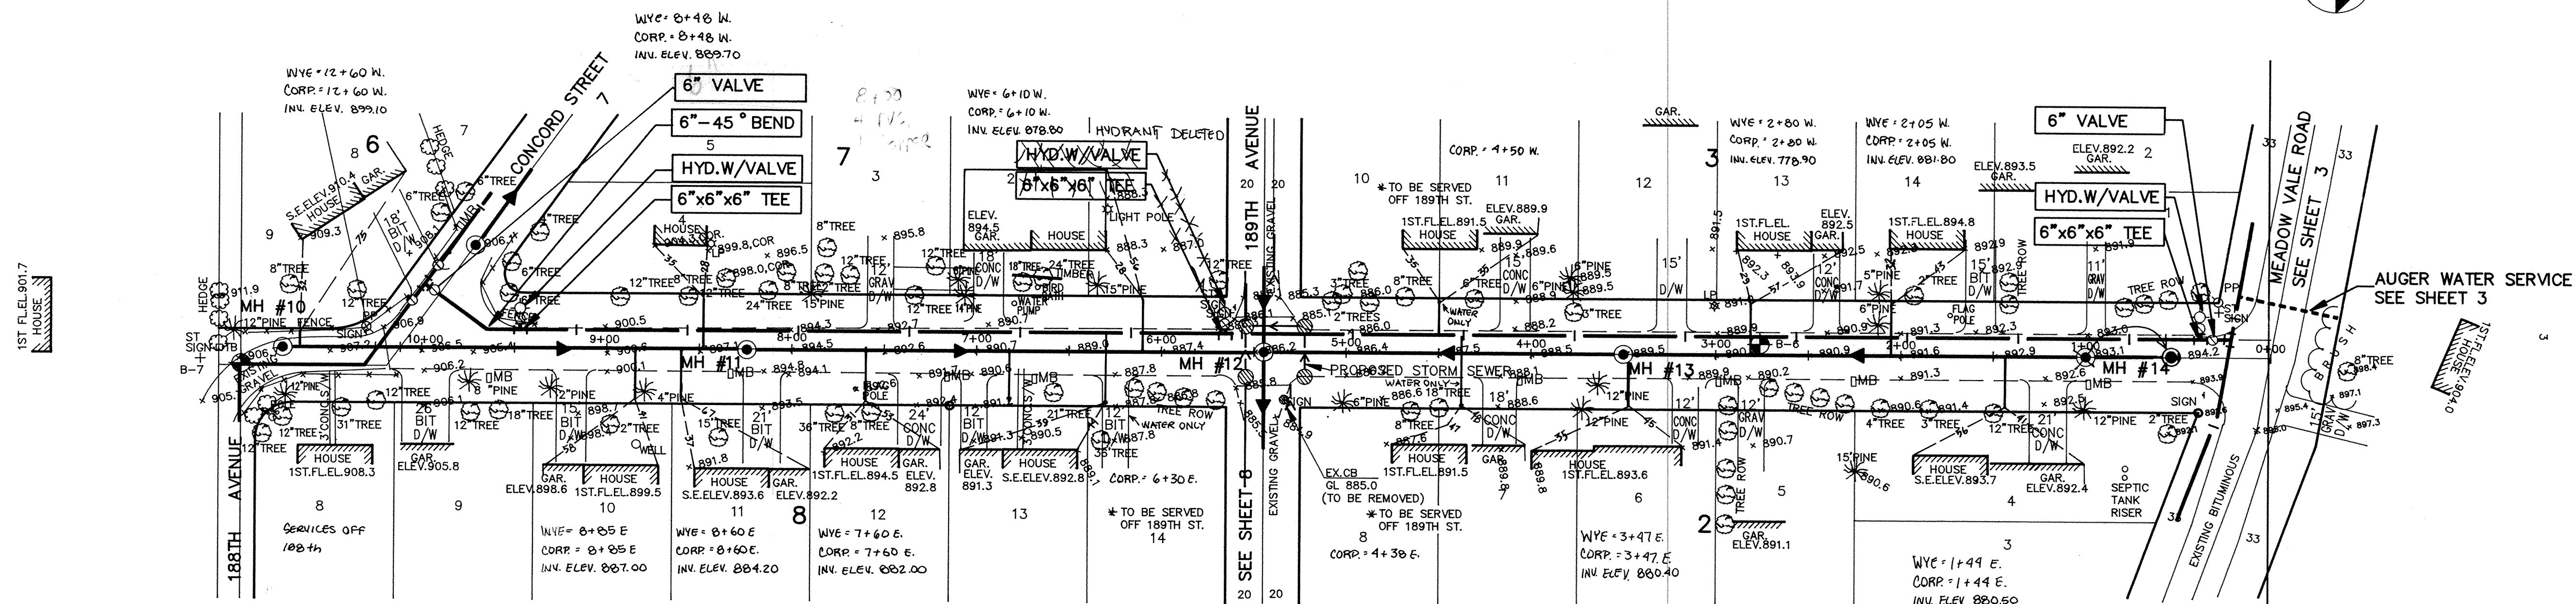


BOSTON STREET

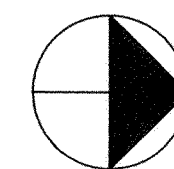

NOTE:

1. INSTALL SEWER AND WATER SERVICES TO VACANT LOTS. LOCATION TO BE DETERMINED AT TIME OF CONSTRUCTION.
2. LOCATION OF SEWER AND WATER SERVICES TO EXISTING HOMES TO BE DETERMINED AT TIME OF CONSTRUCTION.

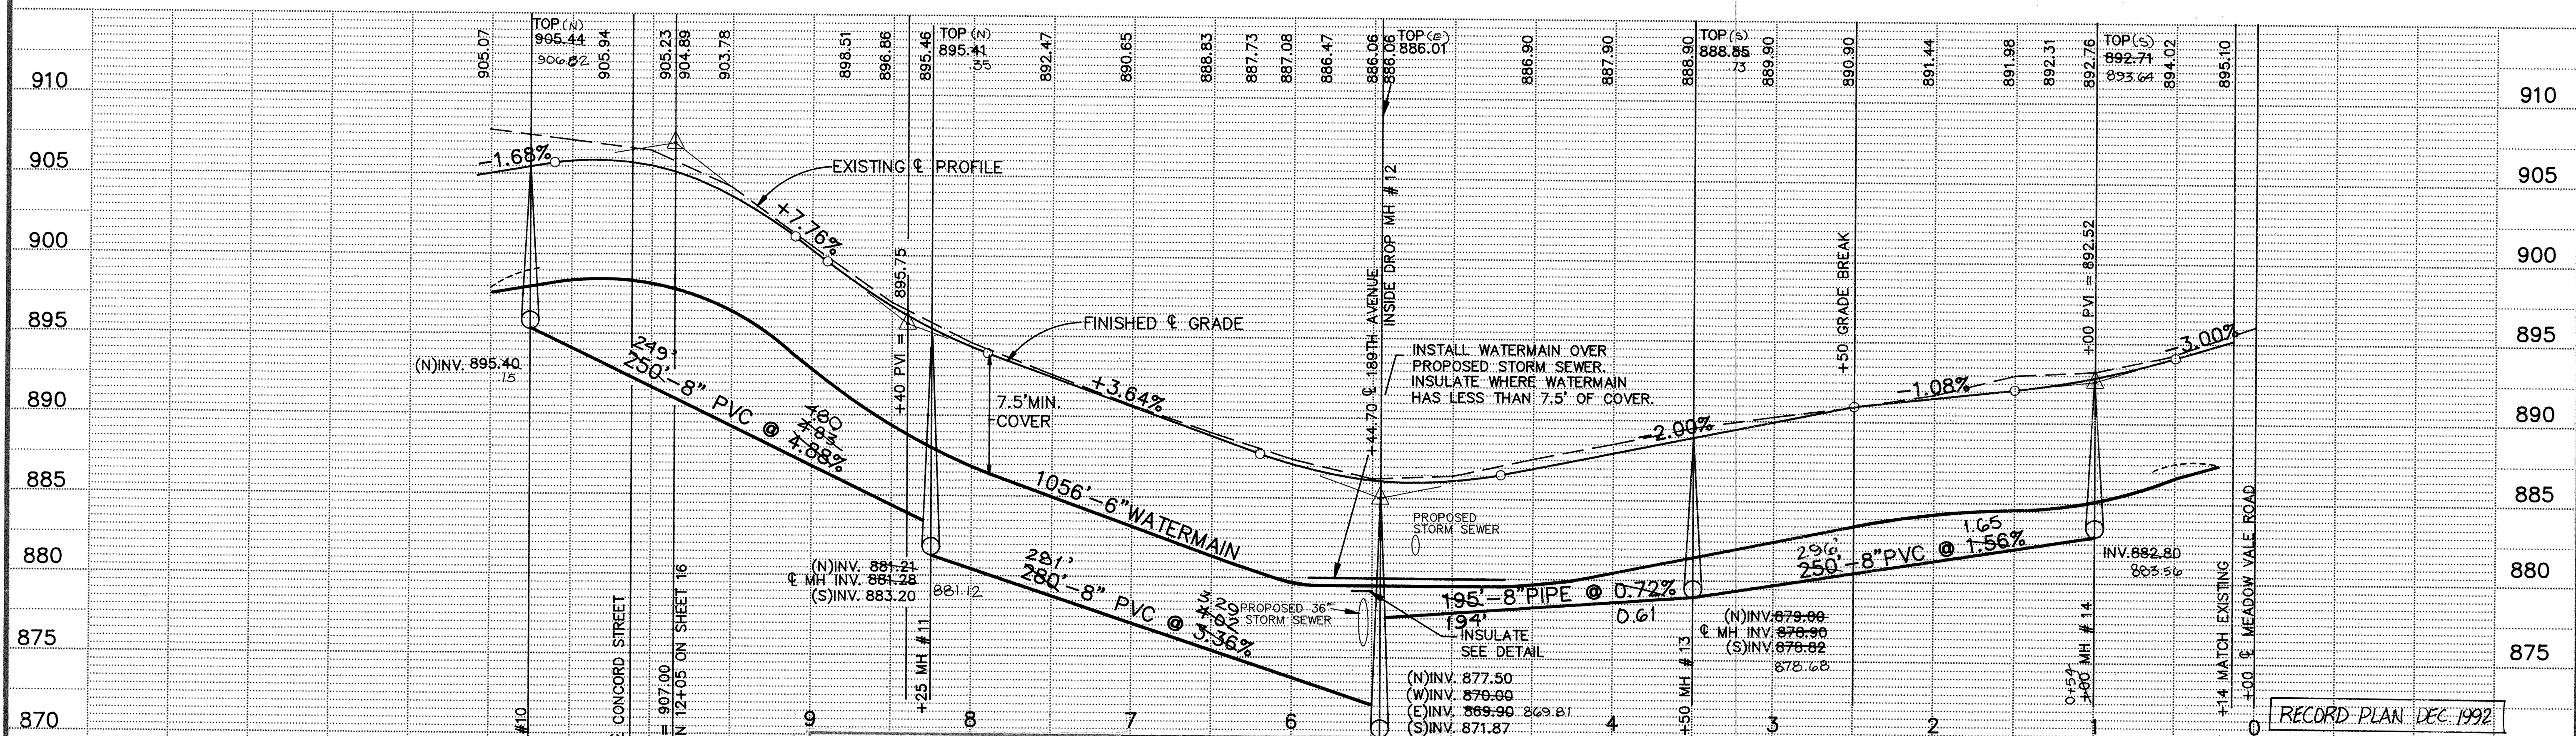

I HEREBY CERTIFY THAT THIS PLAN, SPECIFICATION, OR REPORT WAS PREPARED BY ME OR UNDER MY DIRECT SUPERVISION AND THAT I AM A DULY REGISTERED PROFESSIONAL ENGINEER UNDER THE LAWS OF THE STATE OF MINNESOTA.

Terry J. Maier
DATE 2/4/92 REG. NO. 15316



CONSULTING ENGINEERS
Maier Stewart & Associates Inc.

1959 SLOAN PLACE

(612) 774-6021

ST. PAUL, MINNESOTA 55117

DATE	DESCRIPTION

DESIGNED	CHECKED

GRAPHIC SCALE	HORIZ.	VERT.

CITY OF ELK RIVER

SANITARY SEWER AND WATERMAIN
BOSTON STREET

DATE JAN, 1992 SHEET 6 OF 23 SHEETS PROJECT NO. 230-116