

DRAWING NUMBER

DRAWING NUMBER

DRAWING NUMBER



DRAWING NUMBER

SANDO PRODUCTS • NEW HOPE, MINNESOTA  
REORDER BY PART NUMBER 6553

SANDO PRODUCTS • NEW HOPE, MINNESOTA  
REORDER BY PART NUMBER 6553

SANDO PRODUCTS • NEW HOPE, MINNESOTA  
REORDER BY PART NUMBER 6553

SANDO PRODUCTS • NEW HOPE, MINNESOTA  
REORDER BY PART NUMBER 6553

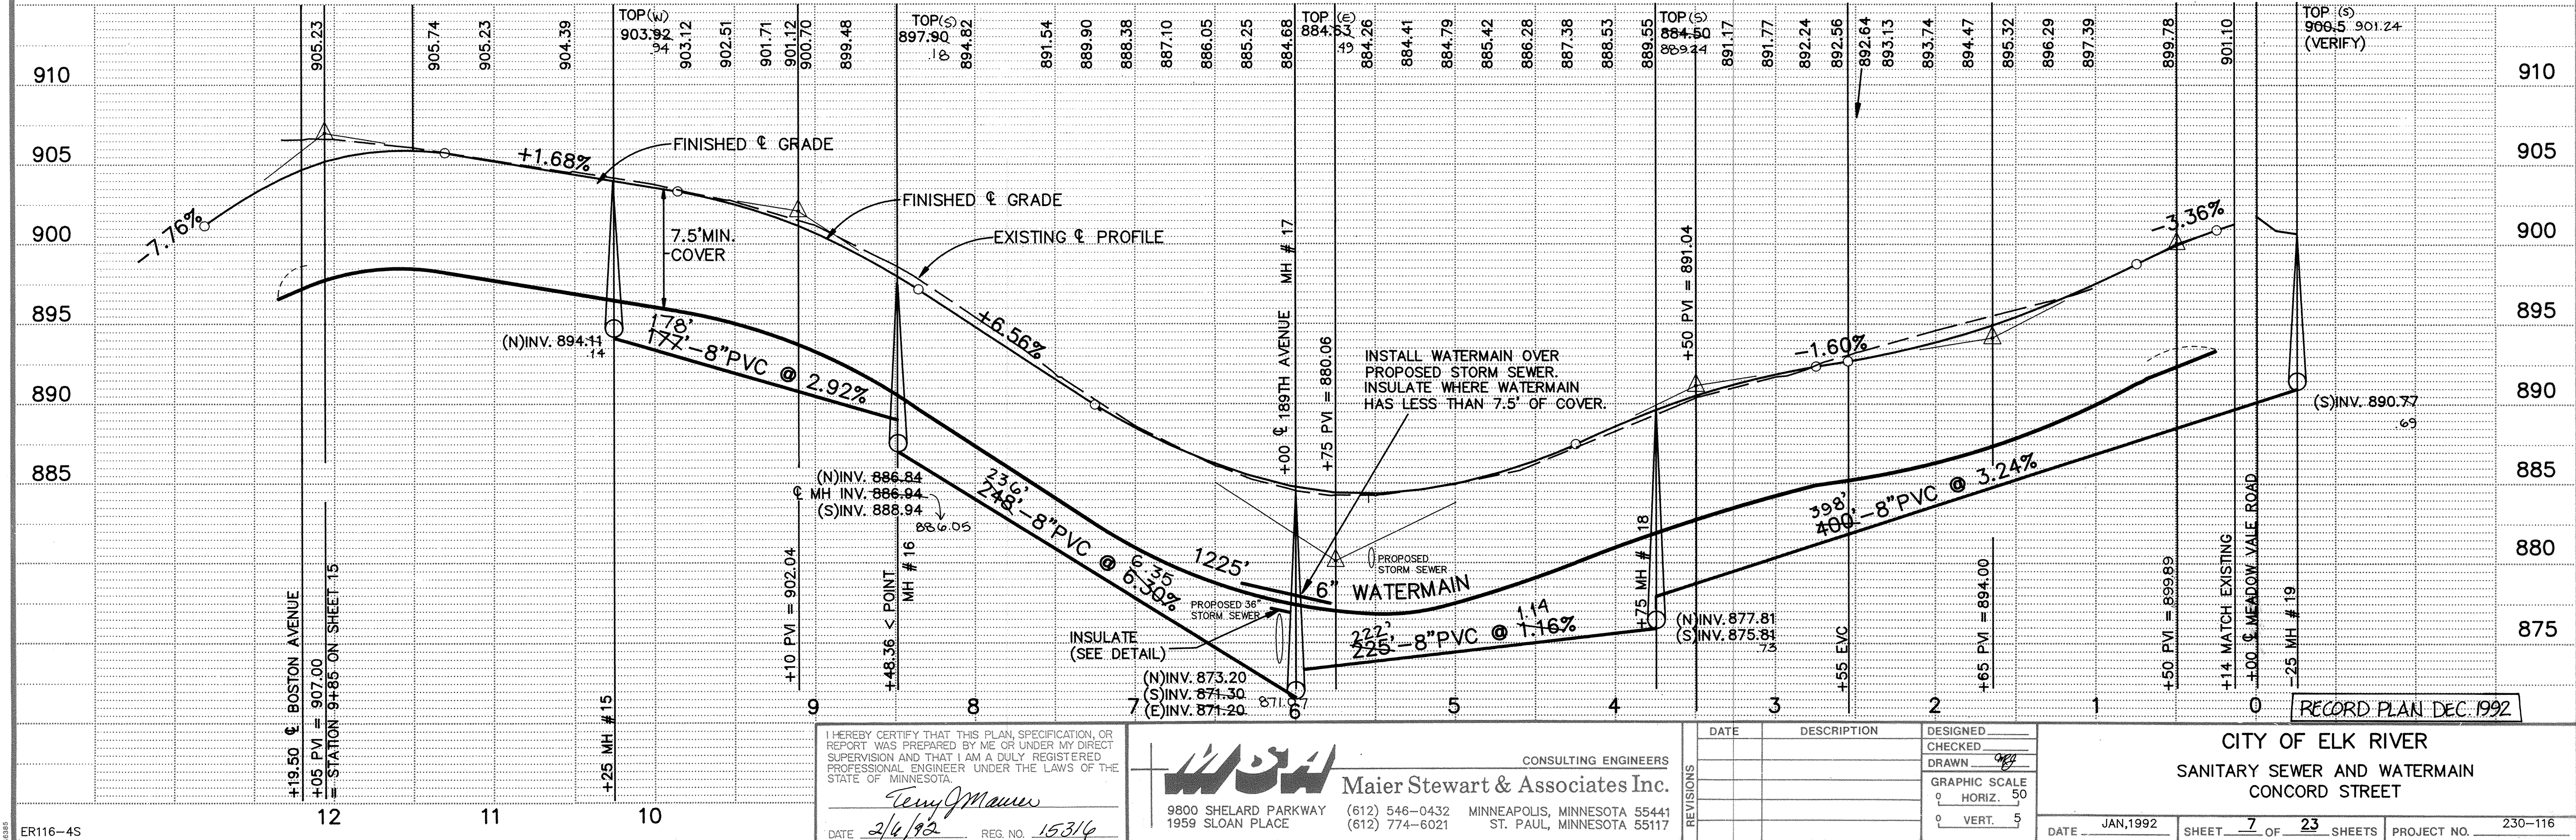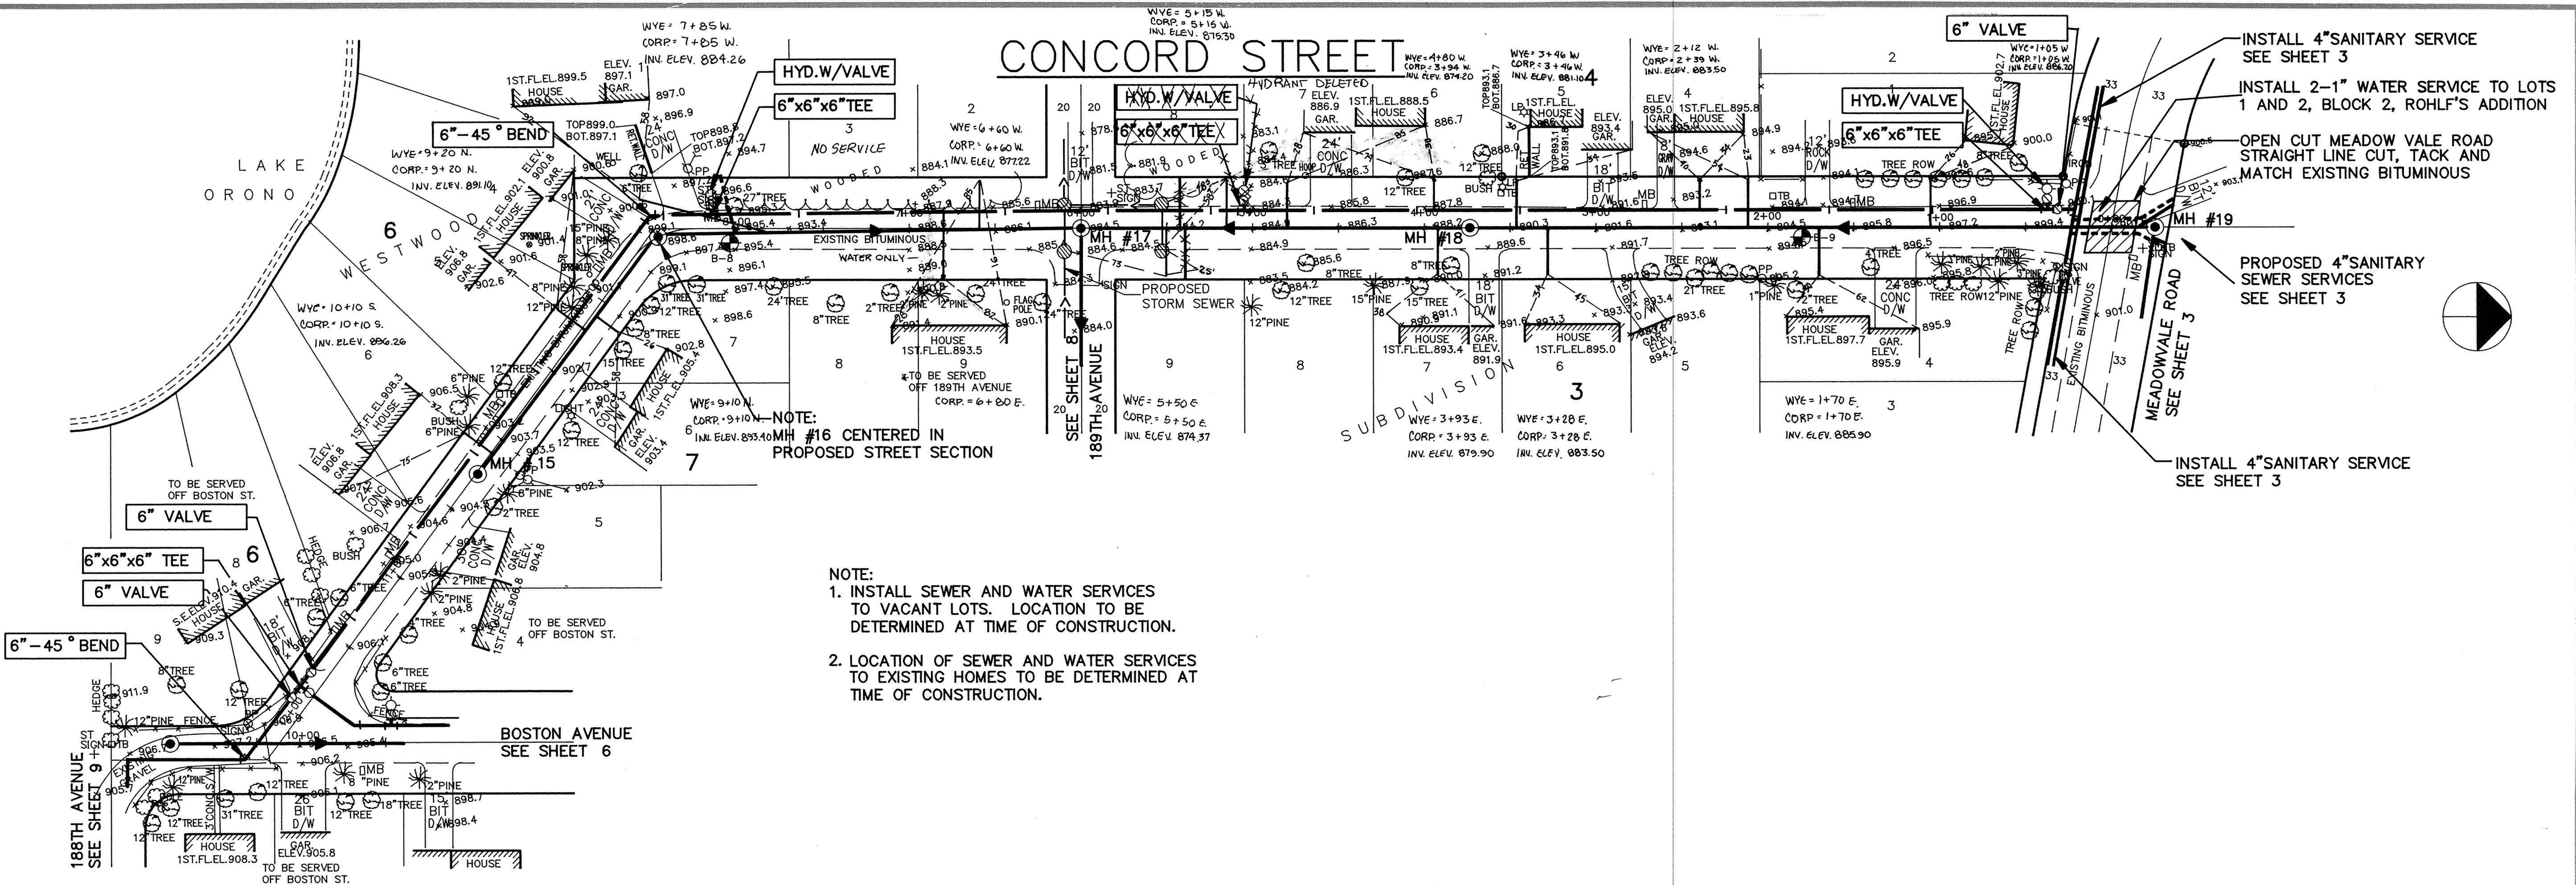

I HEREBY CERTIFY THAT THIS PLAN, SPECIFICATION, OR REPORT WAS PREPARED BY ME OR UNDER MY DIRECT SUPERVISION AND THAT I AM A DULY REGISTERED PROFESSIONAL ENGINEER UNDER THE LAWS OF THE STATE OF MINNESOTA.

*Terry J. Maier*

DATE 2/4/92 REG. NO. 15314

**MSA** CONSULTING ENGINEERS  
**Maier Stewart & Associates Inc.**  
9800 SHELARD PARKWAY (612) 546-0432 MINNEAPOLIS, MINNESOTA 55441  
1959 SLOAN PLACE (612) 774-6021 ST. PAUL, MINNESOTA 55117

| DATE | DESCRIPTION | DESIGNED      |
|------|-------------|---------------|
|      |             | CHECKED       |
|      |             | DRAWN         |
|      |             | GRAPHIC SCALE |
|      |             | 0 HORIZ. 50   |
|      |             | 0 VERT. 5     |

|                              |           |       |                |
|------------------------------|-----------|-------|----------------|
| CITY OF ELK RIVER            |           |       |                |
| SANITARY SEWER AND WATERMAIN |           |       |                |
| CONCORD STREET               |           |       |                |
| DATE                         | JAN, 1992 | SHEET | 7 OF 23 SHEETS |
| PROJECT NO.                  | 230-116   |       |                |