
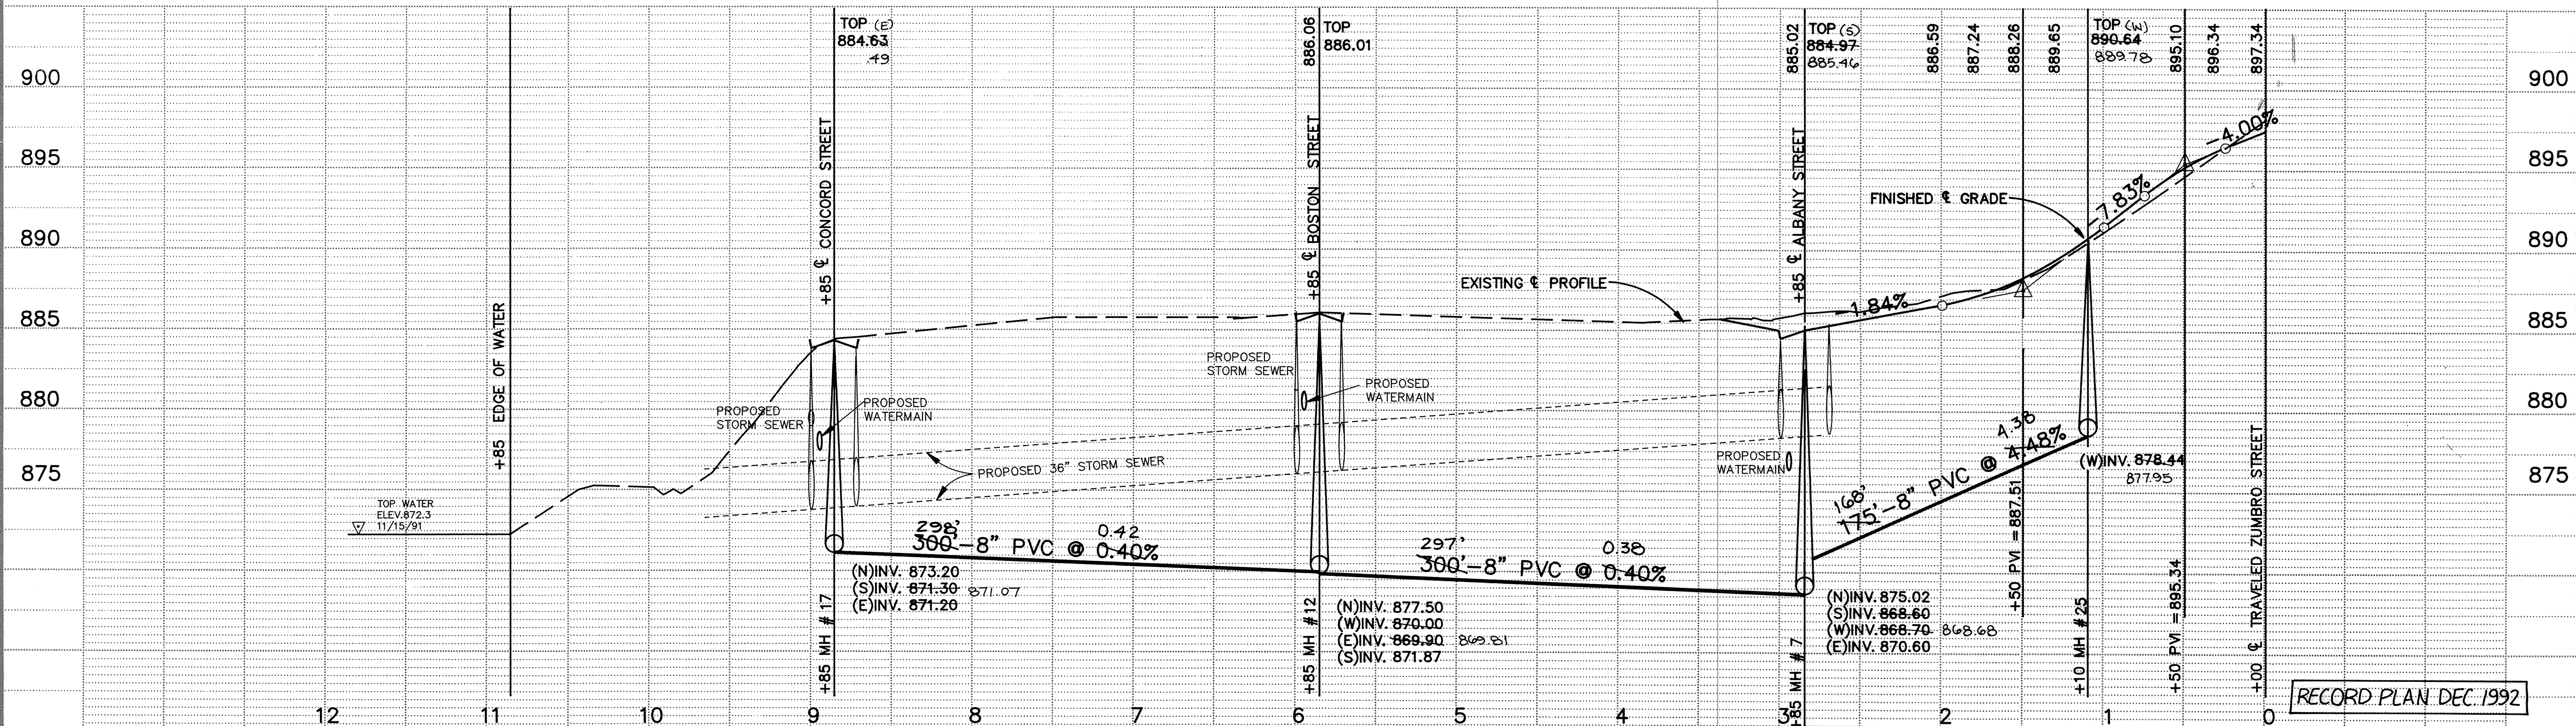
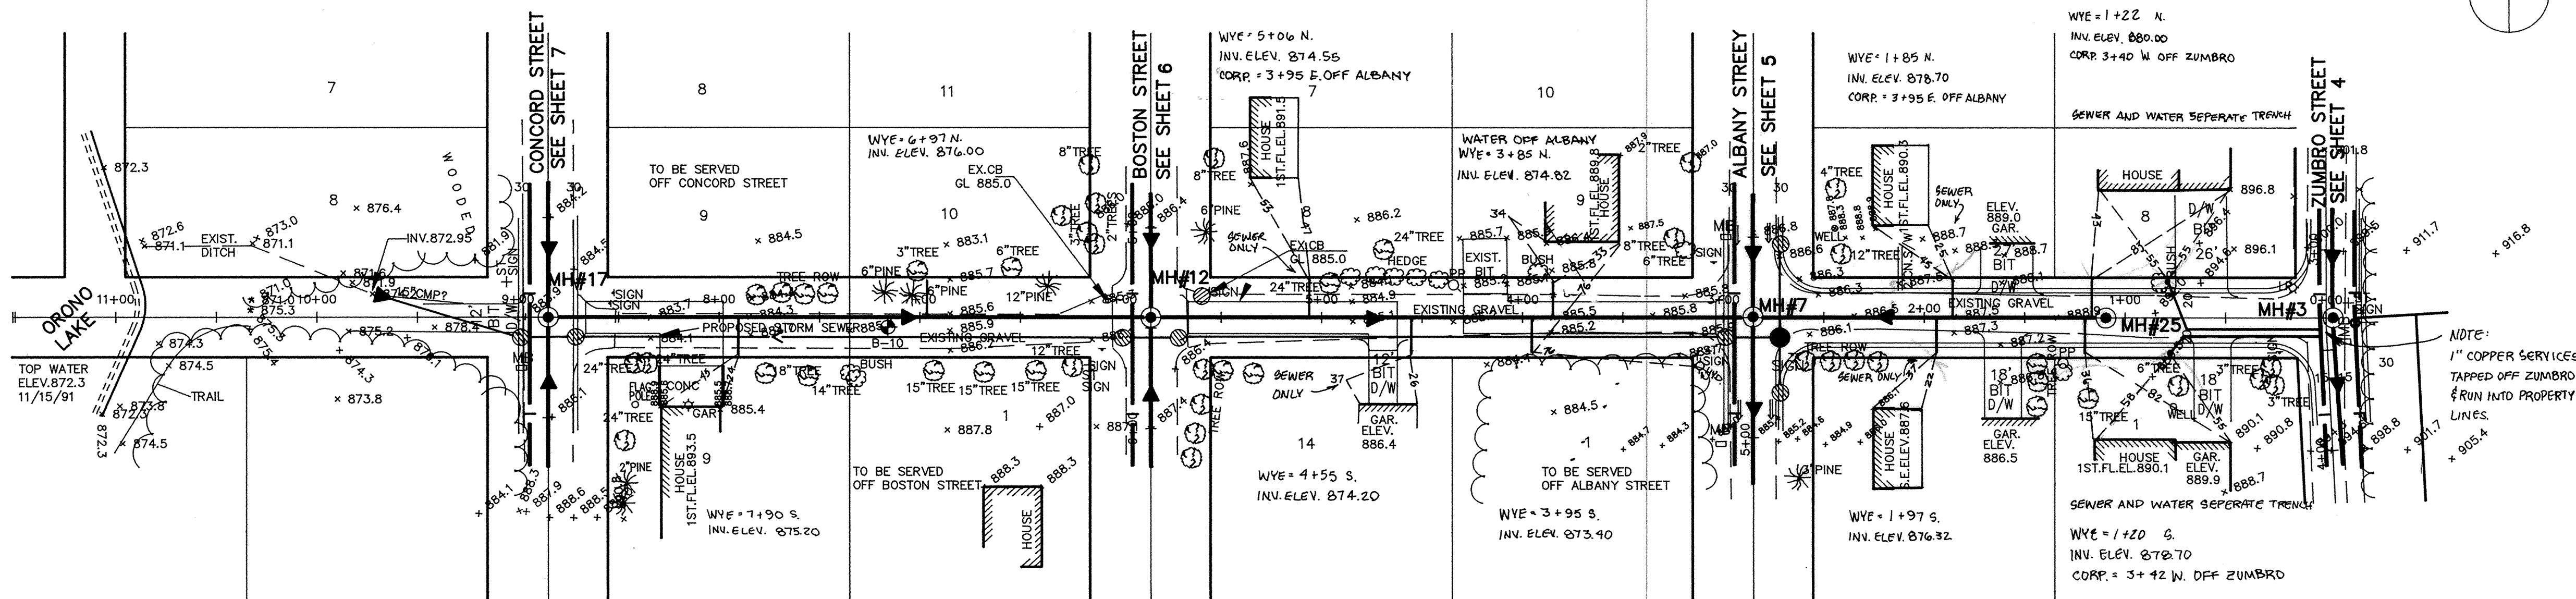


SAECO PRODUCTS • NEW HOPKINS, MINNESOTA
MANUFACTURED BY SAECO PRODUCTS, INC.

SAECO PRODUCTS • NEW HOPKINS, MINNESOTA
MANUFACTURED BY SAECO PRODUCTS, INC.

SAECO PRODUCTS • NEW HOPKINS, MINNESOTA
MANUFACTURED BY SAECO PRODUCTS, INC.

SAECO PRODUCTS • NEW HOPKINS, MINNESOTA
MANUFACTURED BY SAECO PRODUCTS, INC.

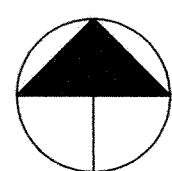

I HEREBY CERTIFY THAT THIS PLAN, SPECIFICATION, OR REPORT WAS PREPARED BY ME OR UNDER MY DIRECT SUPERVISION AND THAT I AM A DULY REGISTERED PROFESSIONAL ENGINEER UNDER THE LAWS OF THE STATE OF MINNESOTA.
Timothy Mauer
DATE 2/6/92 REG. NO. 15316

MSA CONSULTING ENGINEERS
Maier Stewart & Associates Inc.
9800 SHELARD PARKWAY (612) 546-0432 MINNEAPOLIS, MINNESOTA 55441
1959 SLOAN PLACE (612) 774-6021 ST. PAUL, MINNESOTA 55117

DATE	DESCRIPTION	DESIGNED
		CHECKED
		DRAWN
		GRAPHIC SCALE
		0 HORIZ. 50
		0 VERT. 5

CITY OF ELK RIVER
SANITARY SEWER AND WATERMAIN
189TH AVENUE
DATE JAN, 1992 SHEET 8 OF 23 SHEETS PROJECT NO. 230-116