
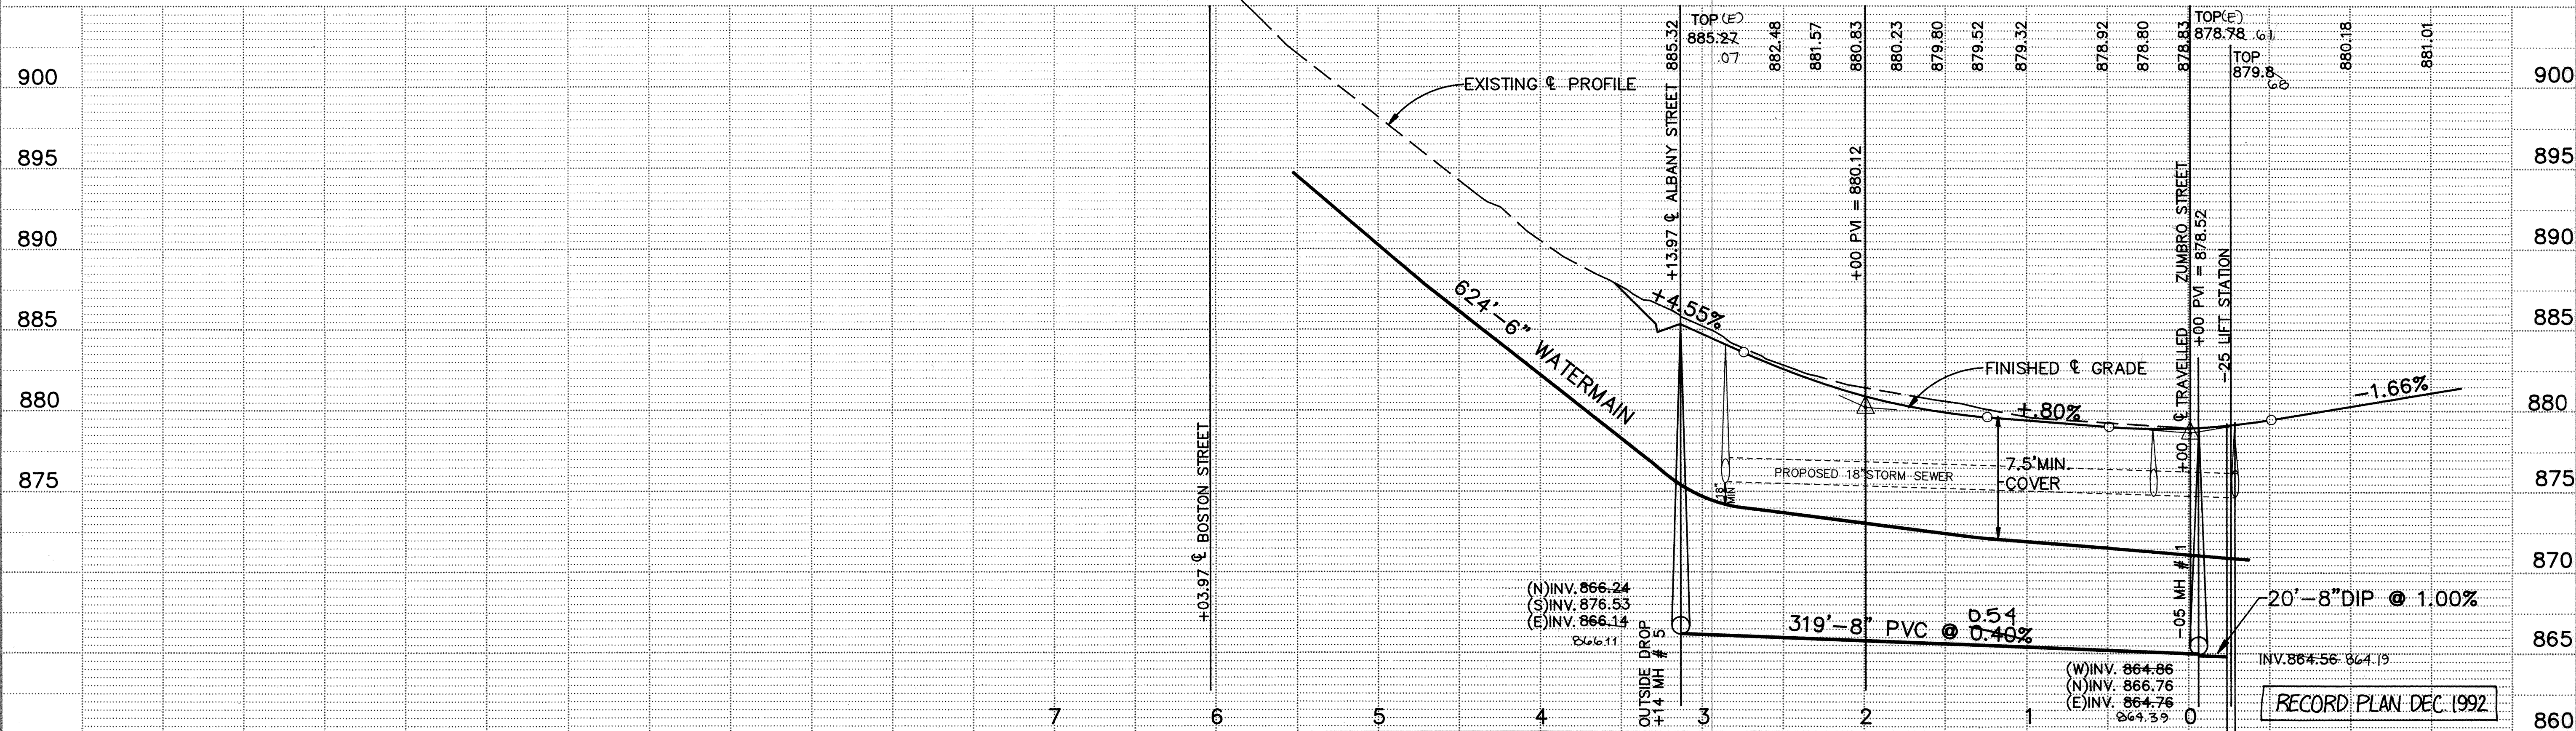


188TH AVENUE

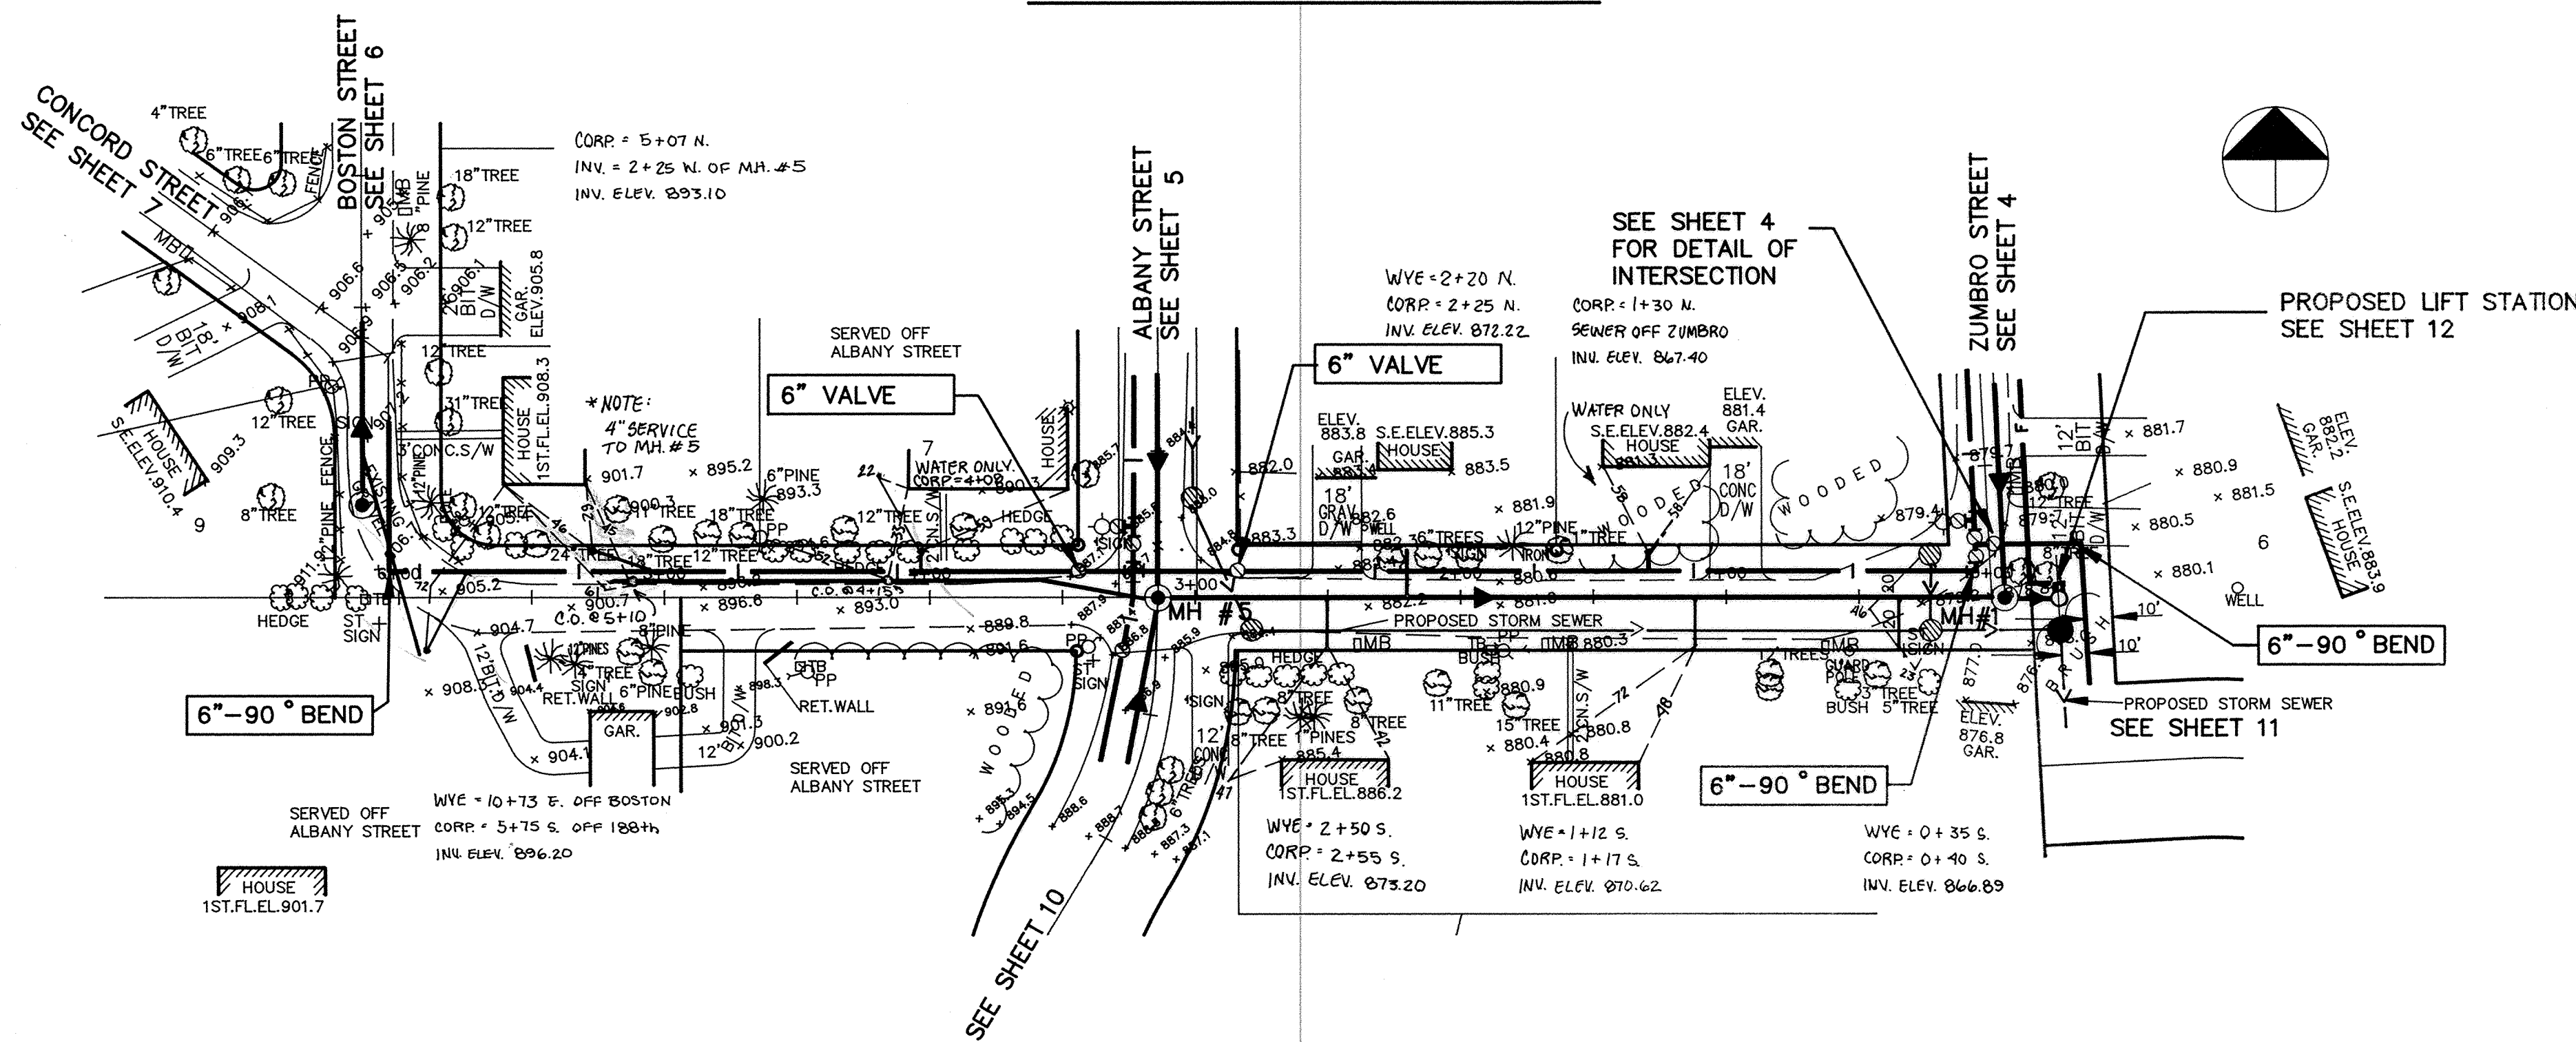

I HEREBY CERTIFY THAT THIS PLAN, SPECIFICATION, OR REPORT WAS PREPARED BY ME OR UNDER MY DIRECT SUPERVISION AND THAT I AM A DULY REGISTERED PROFESSIONAL ENGINEER UNDER THE LAWS OF THE STATE OF MINNESOTA.

Geny J. Maier

DATE 2/4/92 REG. NO. 15314

Maier Stewart & Associates Inc.
CONSULTING ENGINEERS
9800 SHELARD PARKWAY (612) 546-0432 MINNEAPOLIS, MINNESOTA 55441
1959 SLOAN PLACE (612) 774-6021 ST. PAUL, MINNESOTA 55117

DATE	DESCRIPTION	DESIGNED
		CHECKED
		DRAWN
		GRAPHIC SCALE
		HORIZ. 50'
		VERT. 5'

CITY OF ELK RIVER
SANITARY SEWER AND WATERMAIN
188TH AVENUE

RECORD PLAN DEC. 1992

DATE JAN, 1992 SHEET 9 OF 23 SHEETS PROJECT NO. 230-116