

187TH CIRCLE

ALBANY STREET


DRAWING NUMBER

DRAWING NUMBER



DRAWING NUMBER

DRAWING NUMBER
WESTW-92
10

SAECO PRODUCTS • NEW HOPE, MINNESOTA
REPRODUCED BY PART NUMBER 8592

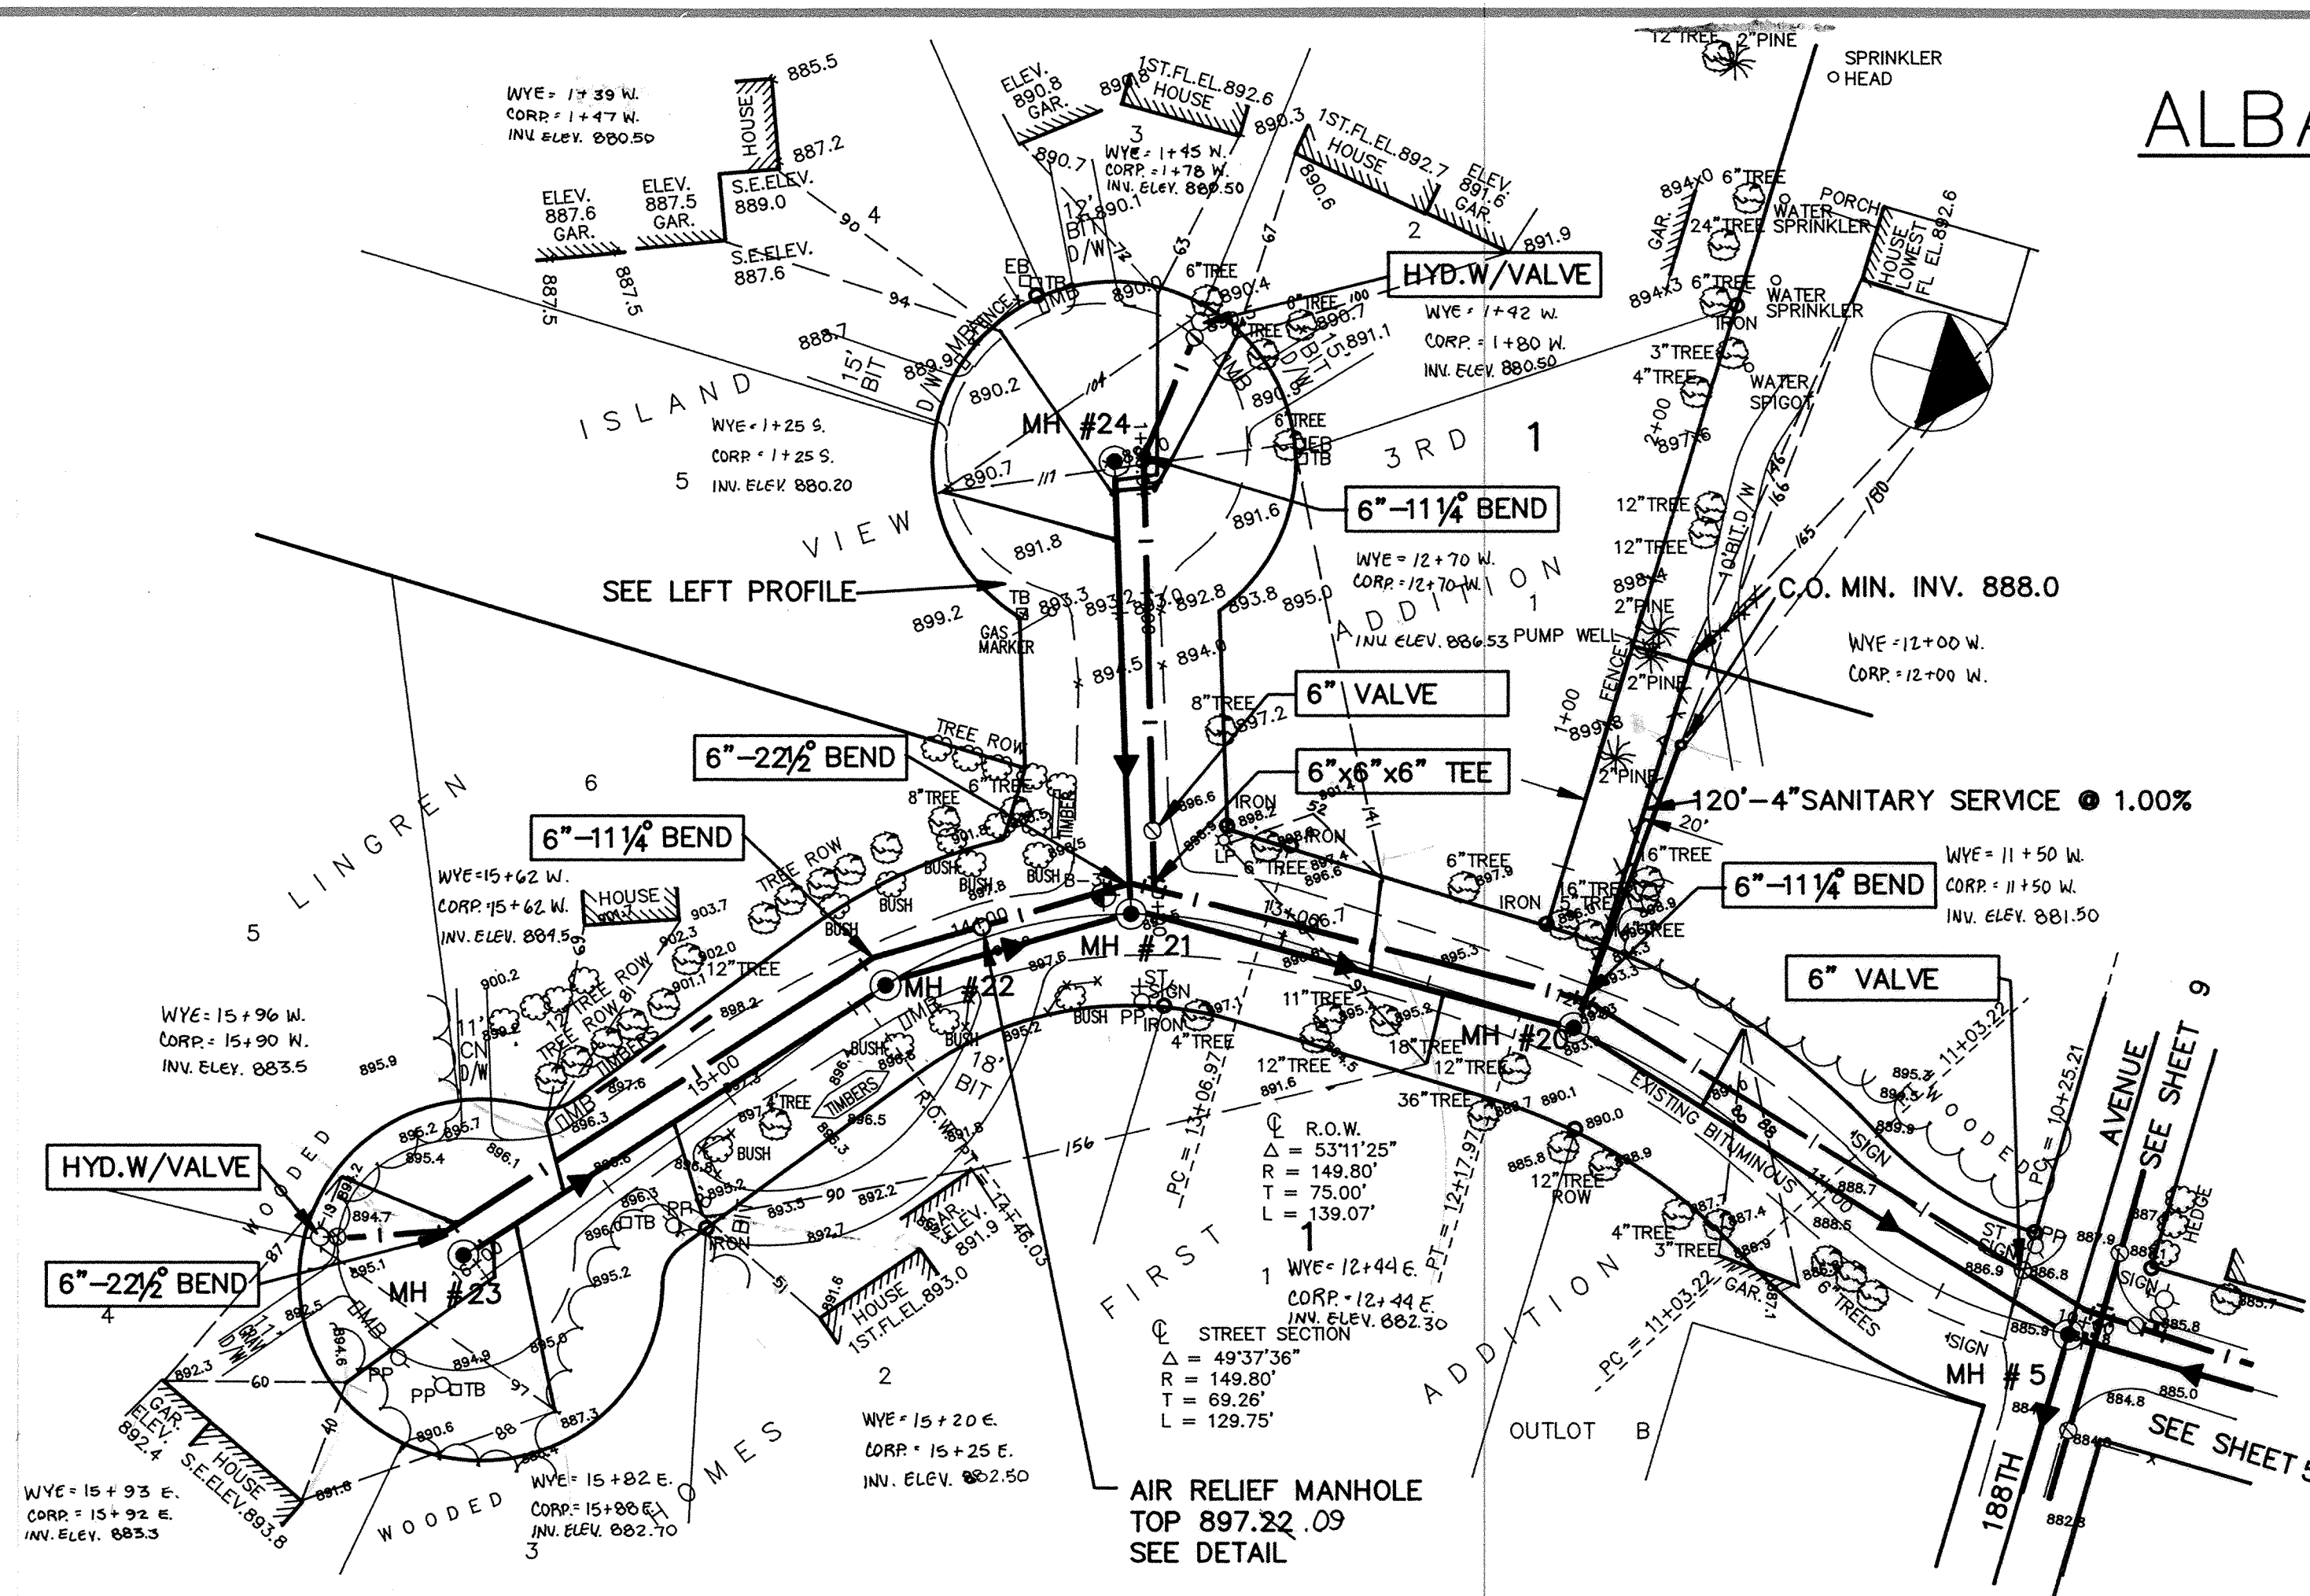

- NOTE:
1. INSTALL SEWER AND WATER SERVICES TO VACANT LOTS. LOCATION TO BE DETERMINED AT TIME OF CONSTRUCTION.
 2. LOCATION OF SEWER AND WATER SERVICES TO EXISTING HOMES TO BE DETERMINED AT TIME OF CONSTRUCTION.

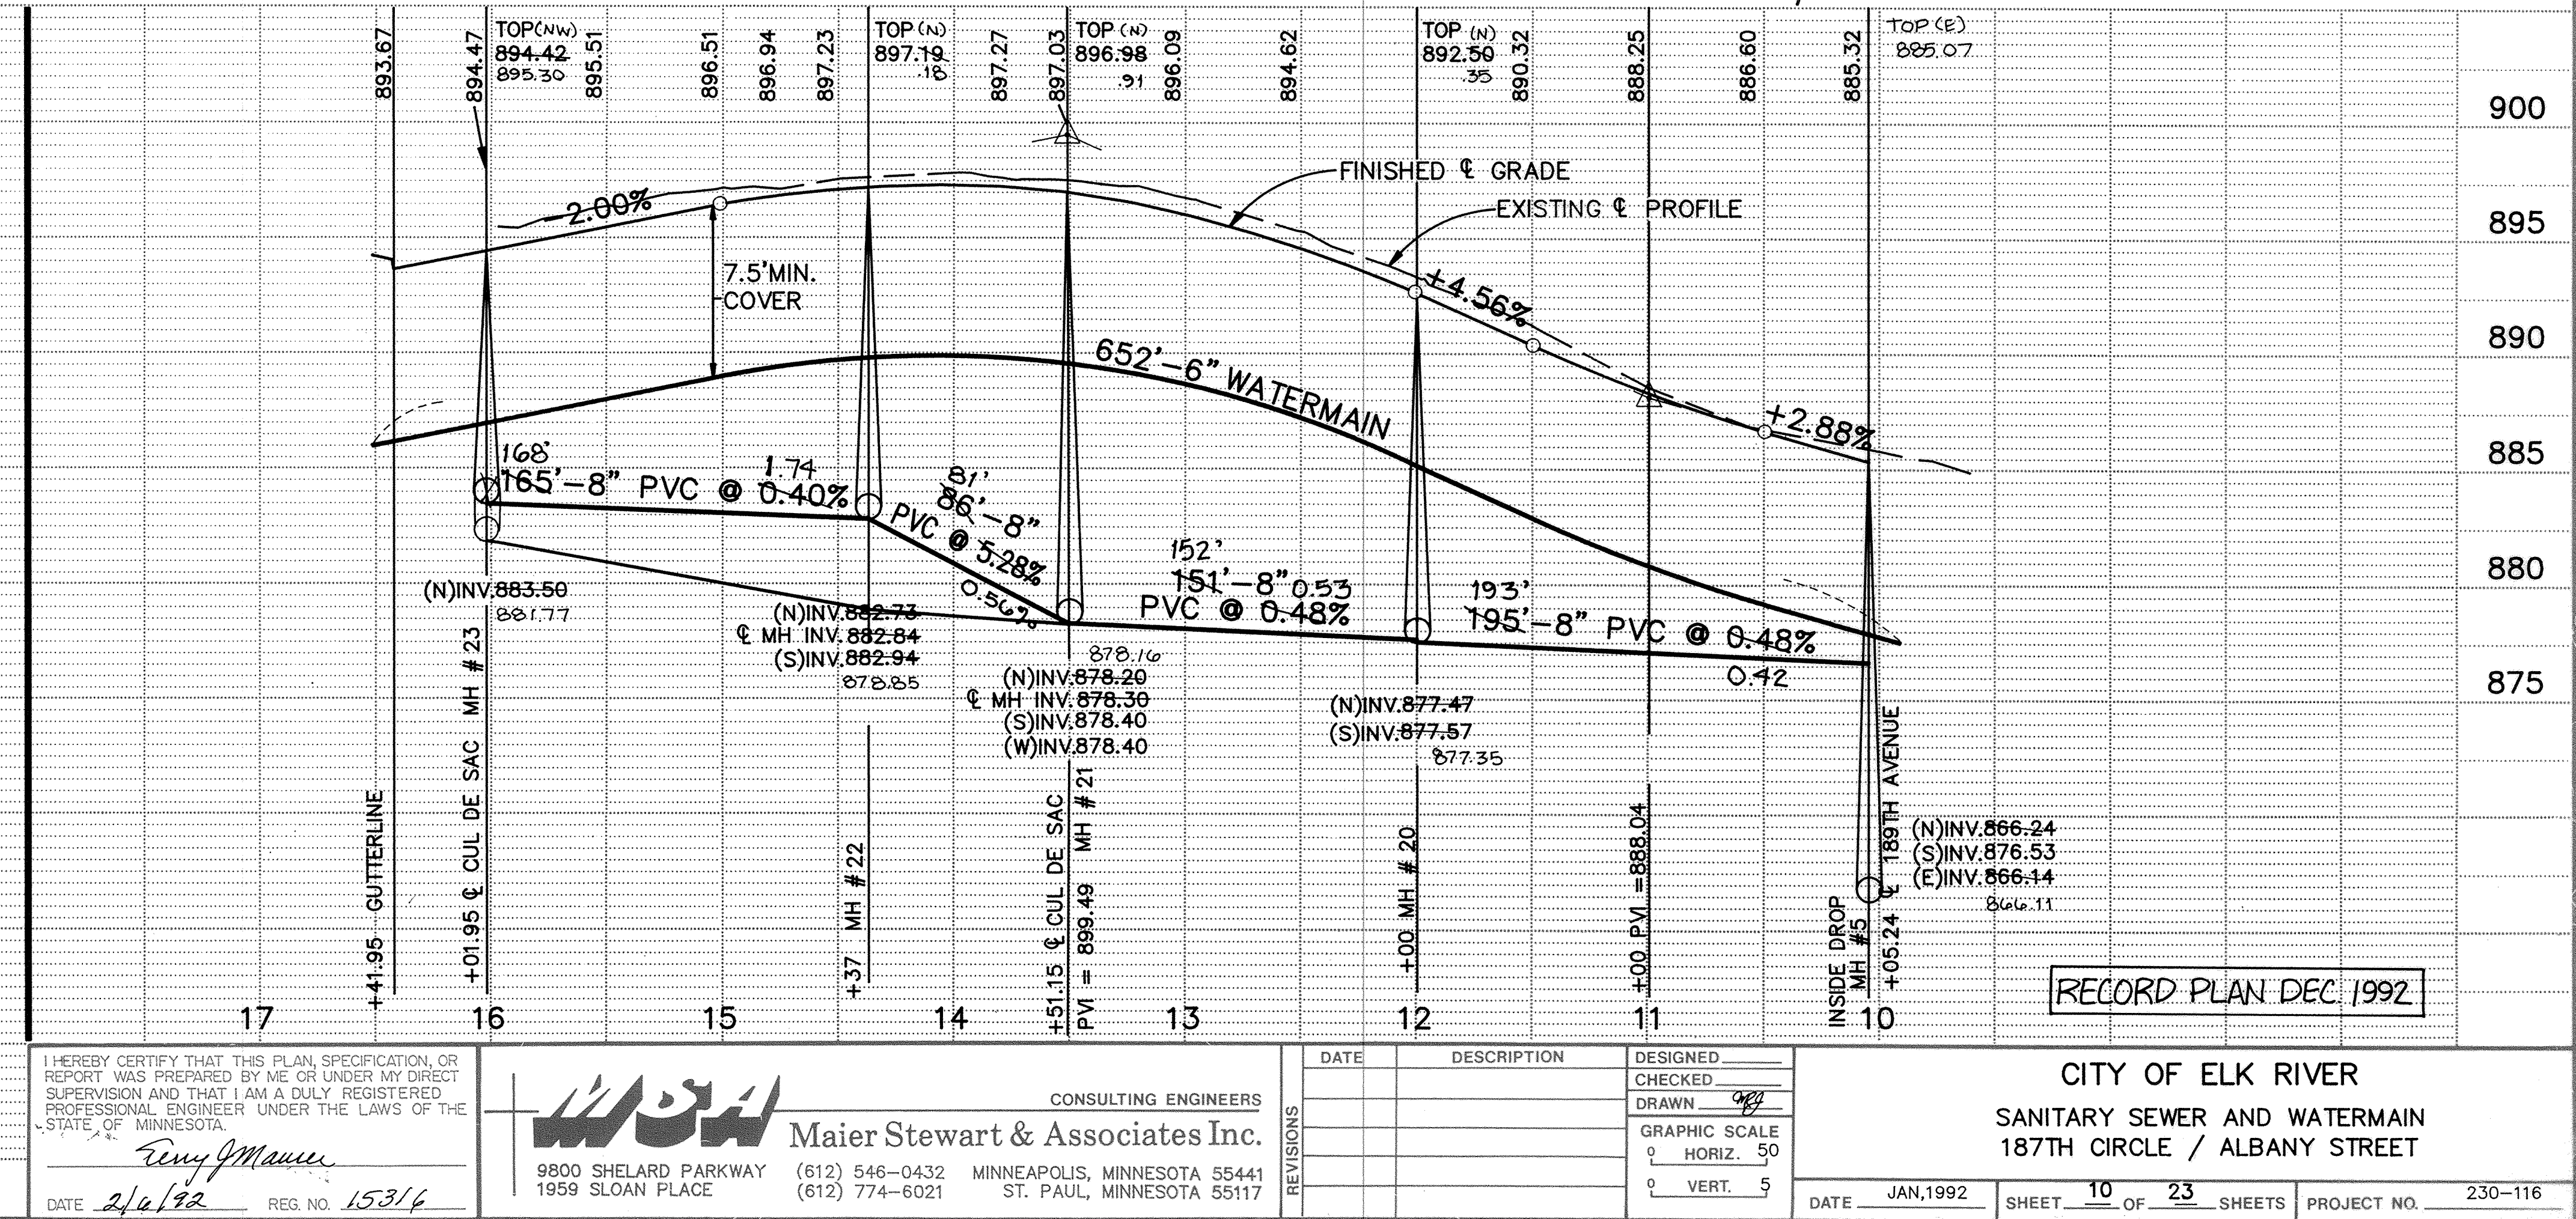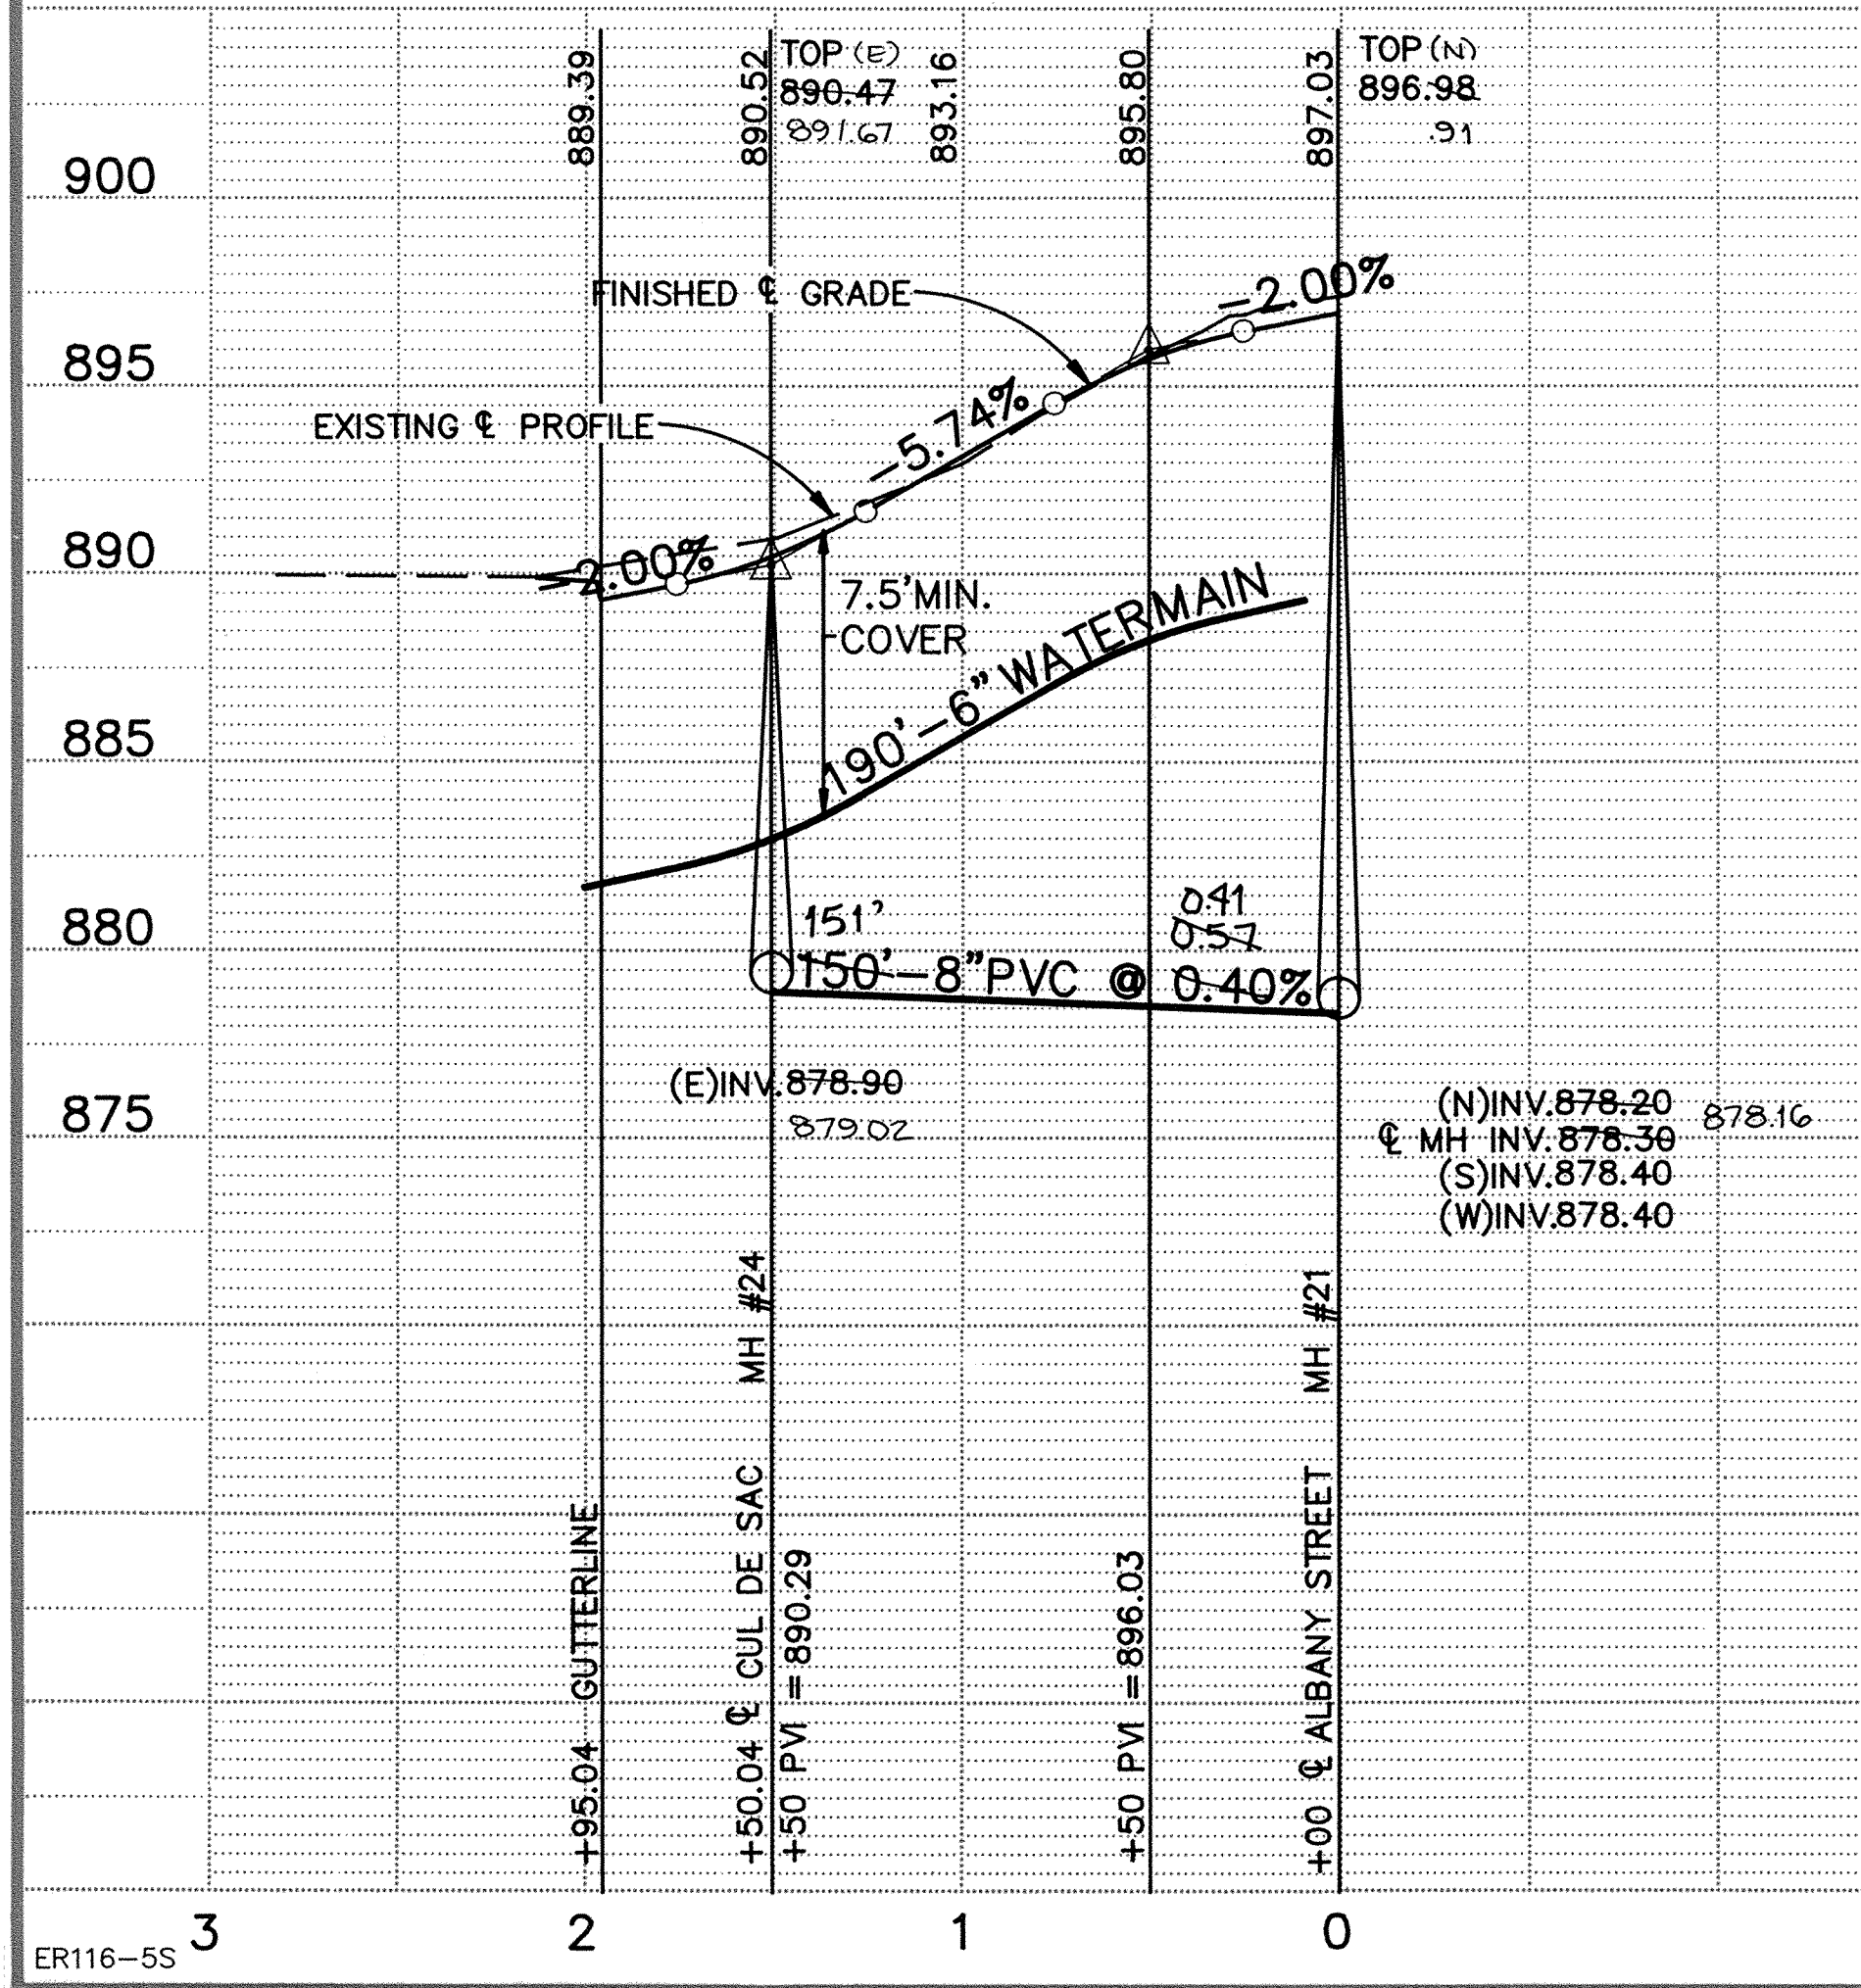

I HEREBY CERTIFY THAT THIS PLAN, SPECIFICATION, OR REPORT WAS PREPARED BY ME OR UNDER MY DIRECT SUPERVISION AND THAT I AM A DULY REGISTERED PROFESSIONAL ENGINEER UNDER THE LAWS OF THE STATE OF MINNESOTA.

Donny J. Maier

DATE 2/6/92 REG. NO. 15316

Maier Stewart & Associates Inc.
CONSULTING ENGINEERS
9800 SHELARD PARKWAY (612) 546-0432 MINNEAPOLIS, MINNESOTA 55441
1959 SLOAN PLACE (612) 774-6021 ST. PAUL, MINNESOTA 55117

DATE	DESCRIPTION	DESIGNED
		CHECKED
		DRAWN
		GRAPHIC SCALE
		0 HORIZ. 50
		0 VERT. 5

CITY OF ELK RIVER
SANITARY SEWER AND WATERMAIN
187TH CIRCLE / ALBANY STREET

DATE JAN, 1992 SHEET 10 OF 23 SHEETS PROJECT NO. 230-116

RECORD PLAN DEC 1992