
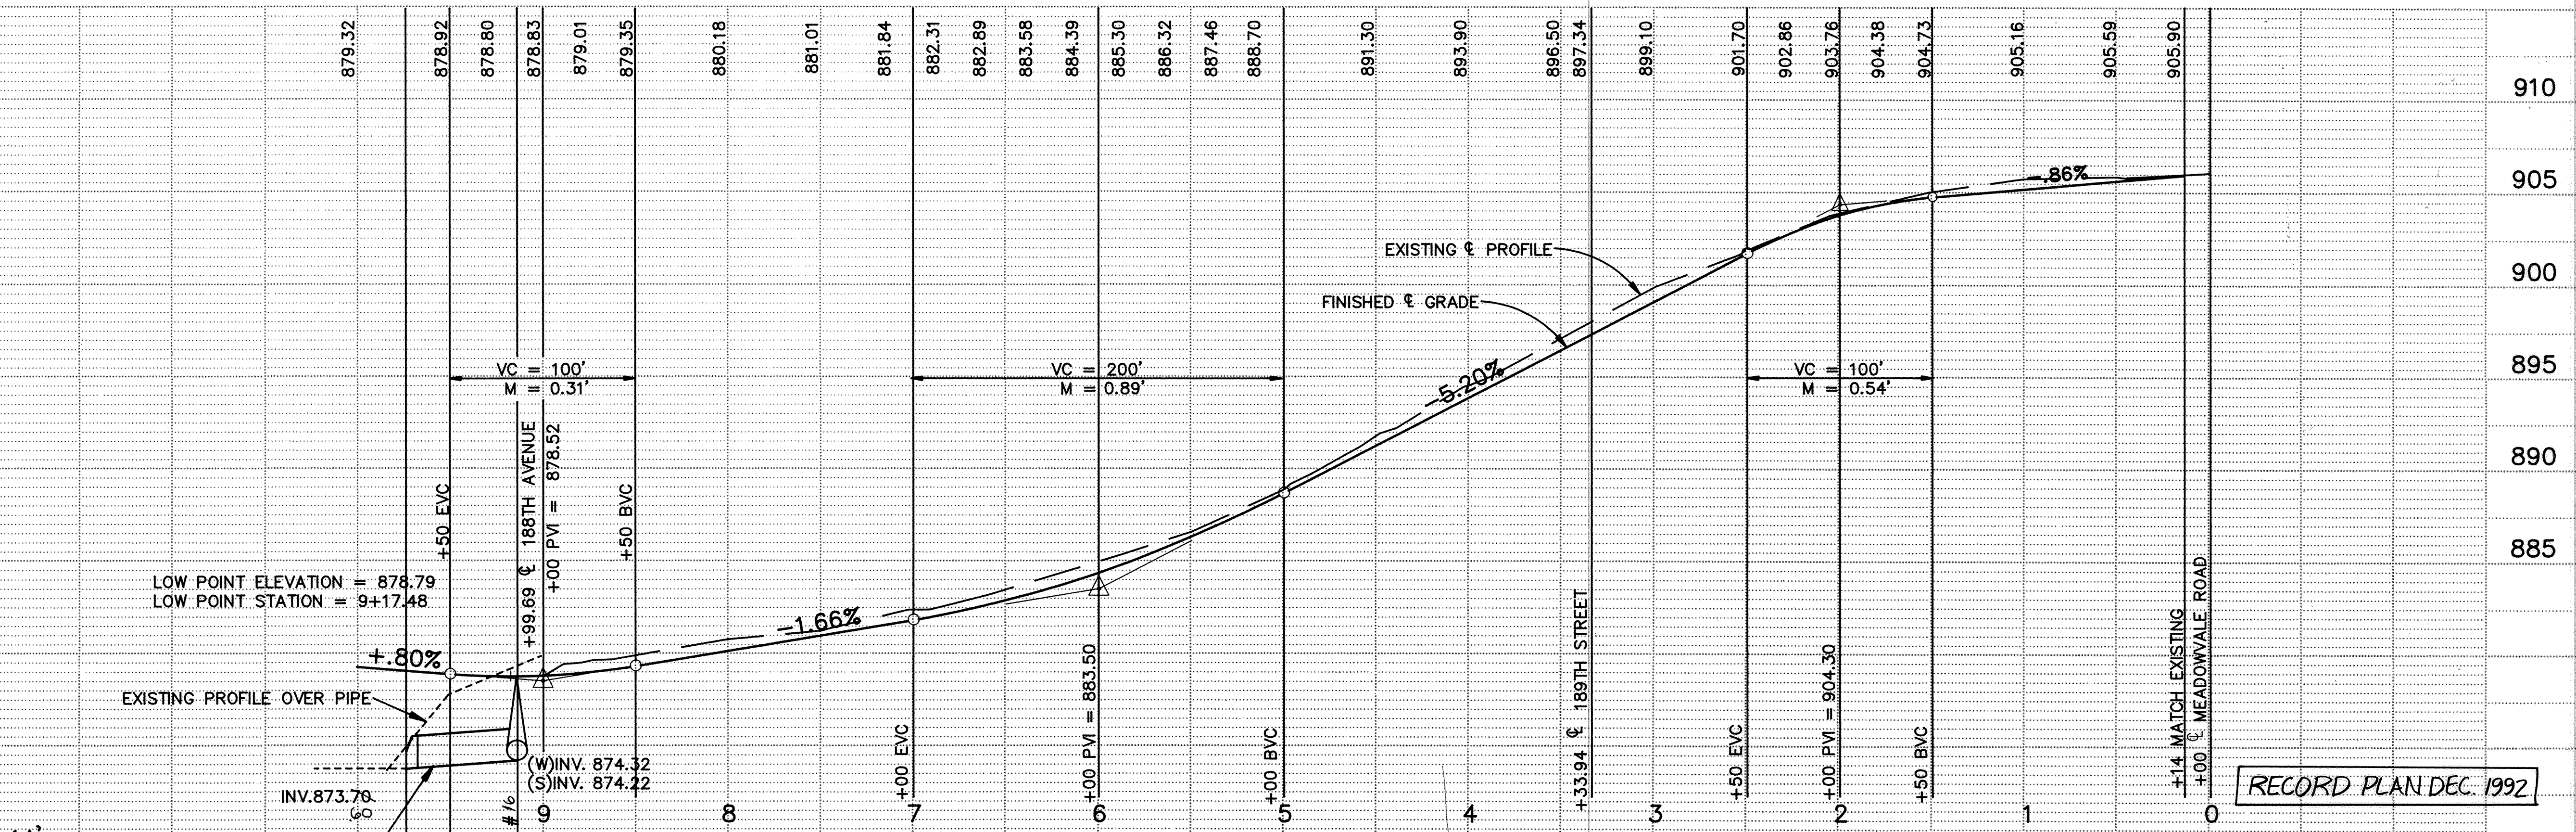
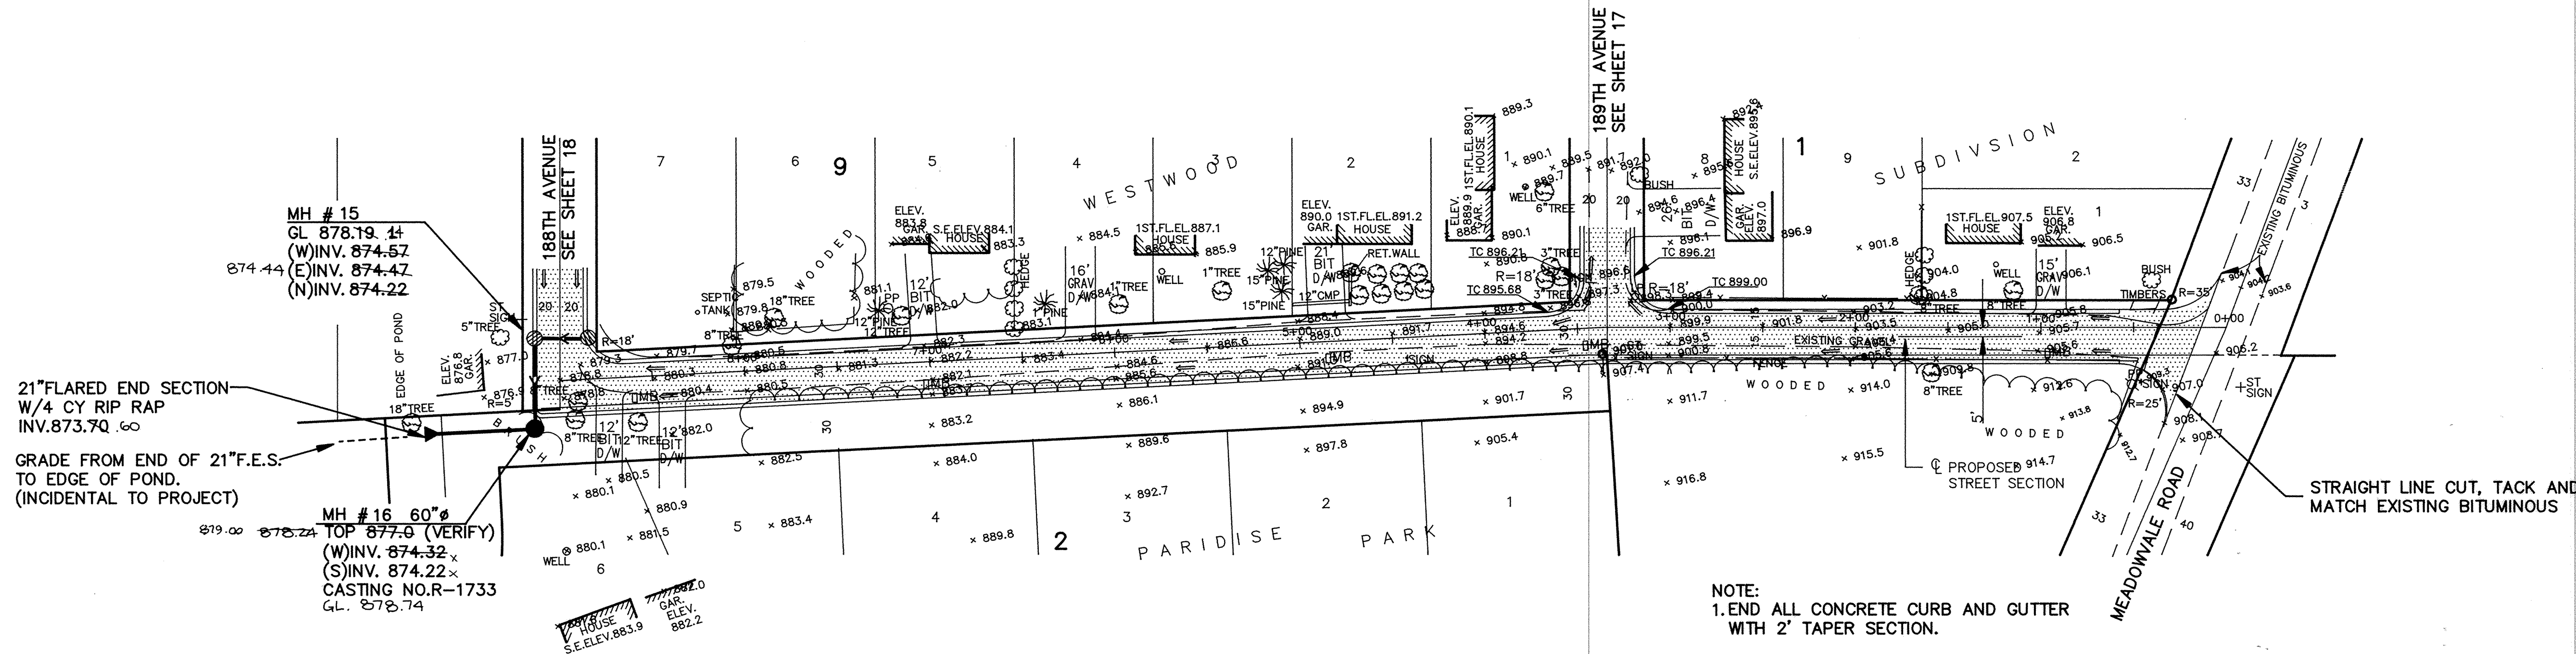


ZUMBRO STREET

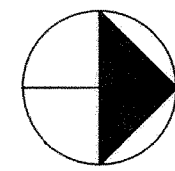

61'-21" RCP CL III @ 0.64%
(54'-21" RCP PLUS 1'-5" F.E.S.)

I HEREBY CERTIFY THAT THIS PLAN, SPECIFICATION, OR REPORT WAS PREPARED BY ME OR UNDER MY DIRECT SUPERVISION AND THAT I AM A DULY REGISTERED PROFESSIONAL ENGINEER UNDER THE LAWS OF THE STATE OF MINNESOTA.

Maier Stewart & Associates Inc.

DATE 2/4/92 REG. NO. 15314

Maier Stewart & Associates Inc.
CONSULTING ENGINEERS
9800 SHELARD PARKWAY (612) 546-0432 MINNEAPOLIS, MINNESOTA 55441
1959 SLOAN PLACE (612) 774-6021 ST. PAUL, MINNESOTA 55117

DATE	DESCRIPTION	DESIGNED
		CHECKED
		DRAWN
		GRAPHIC SCALE
		0' HORIZ. 50'
		0' VERT. 5'

CIT OF ELK RIVER			
STREET AND STORM SEWER			
ZUMBRO STREET			
DATE	NOV. 1991	SHEET	13 OF 23 SHEETS
PROJECT NO.	230-116		