


SAECO PRODUCTS • NEW HOPE, MINNESOTA  
REPORTED BY PART NUMBER 8592  
PROJECT NO. 270-116


# ALBANY STREET

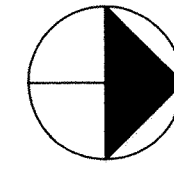

LOW POINT ELEVATION = 881.95  
LOW POINT STATION = 8+26.92


8' 10'-12"RCP CL III @ 20.00%  
(4'-12"RCP PLUS 1-6' F.E.S.)

27' 28'-12"RCP CL III @ 1.00%

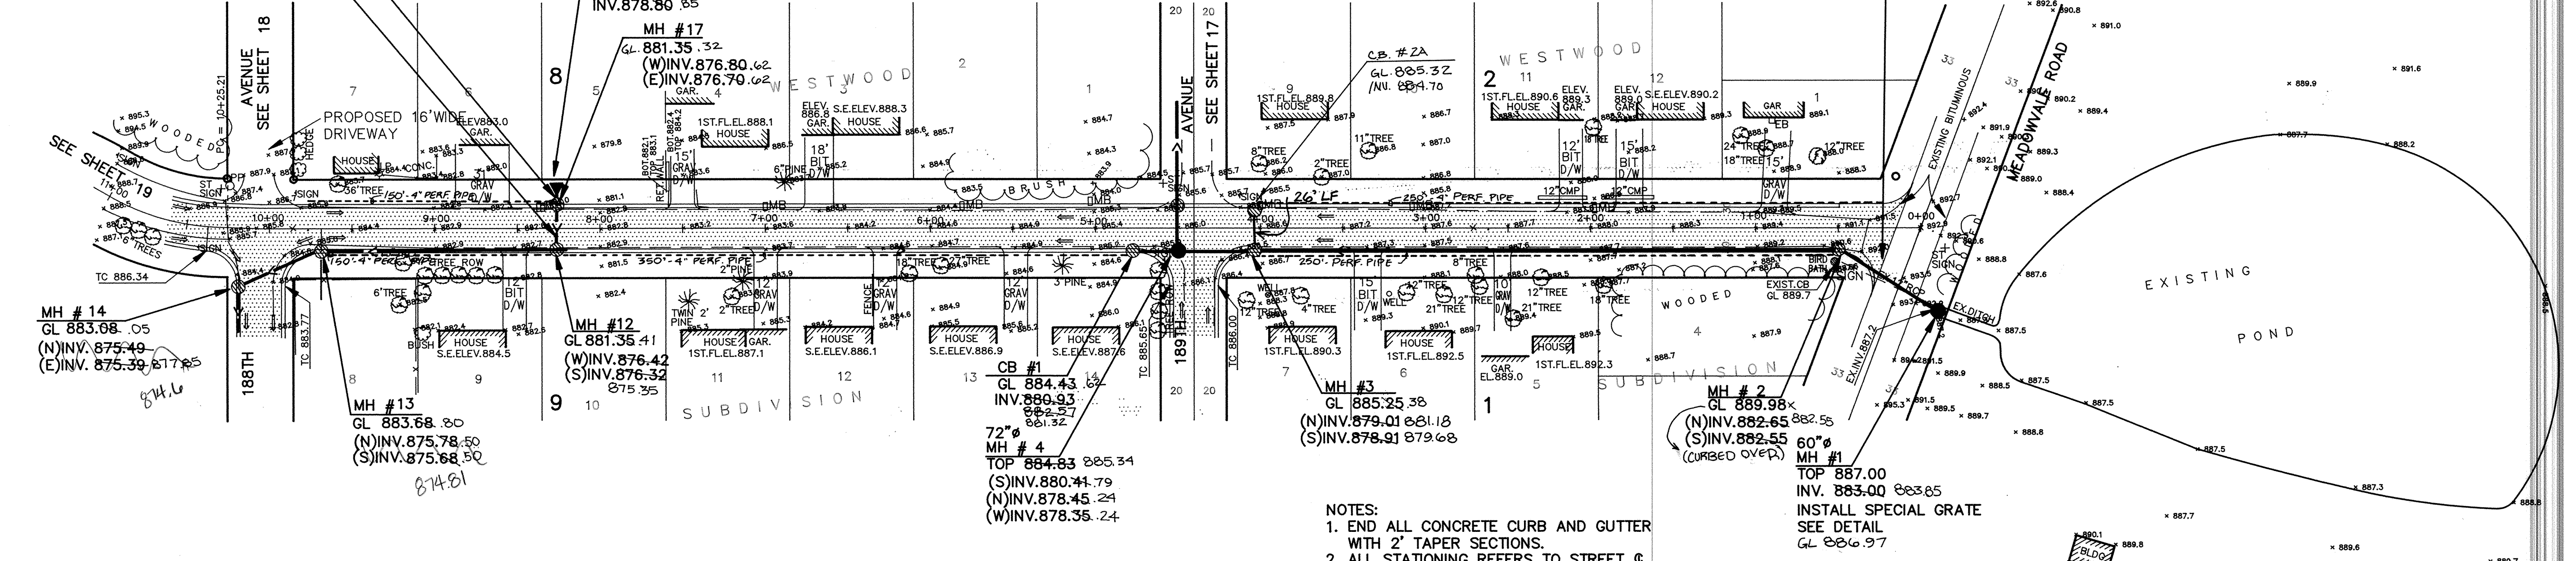

- NOTES:  
1. END ALL CONCRETE CURB AND GUTTER WITH 2' TAPER SECTIONS.  
2. ALL STATIONING REFERS TO STREET C

INSTALL SPECIAL GRATE  
SEE DETAIL  
GL 886.97

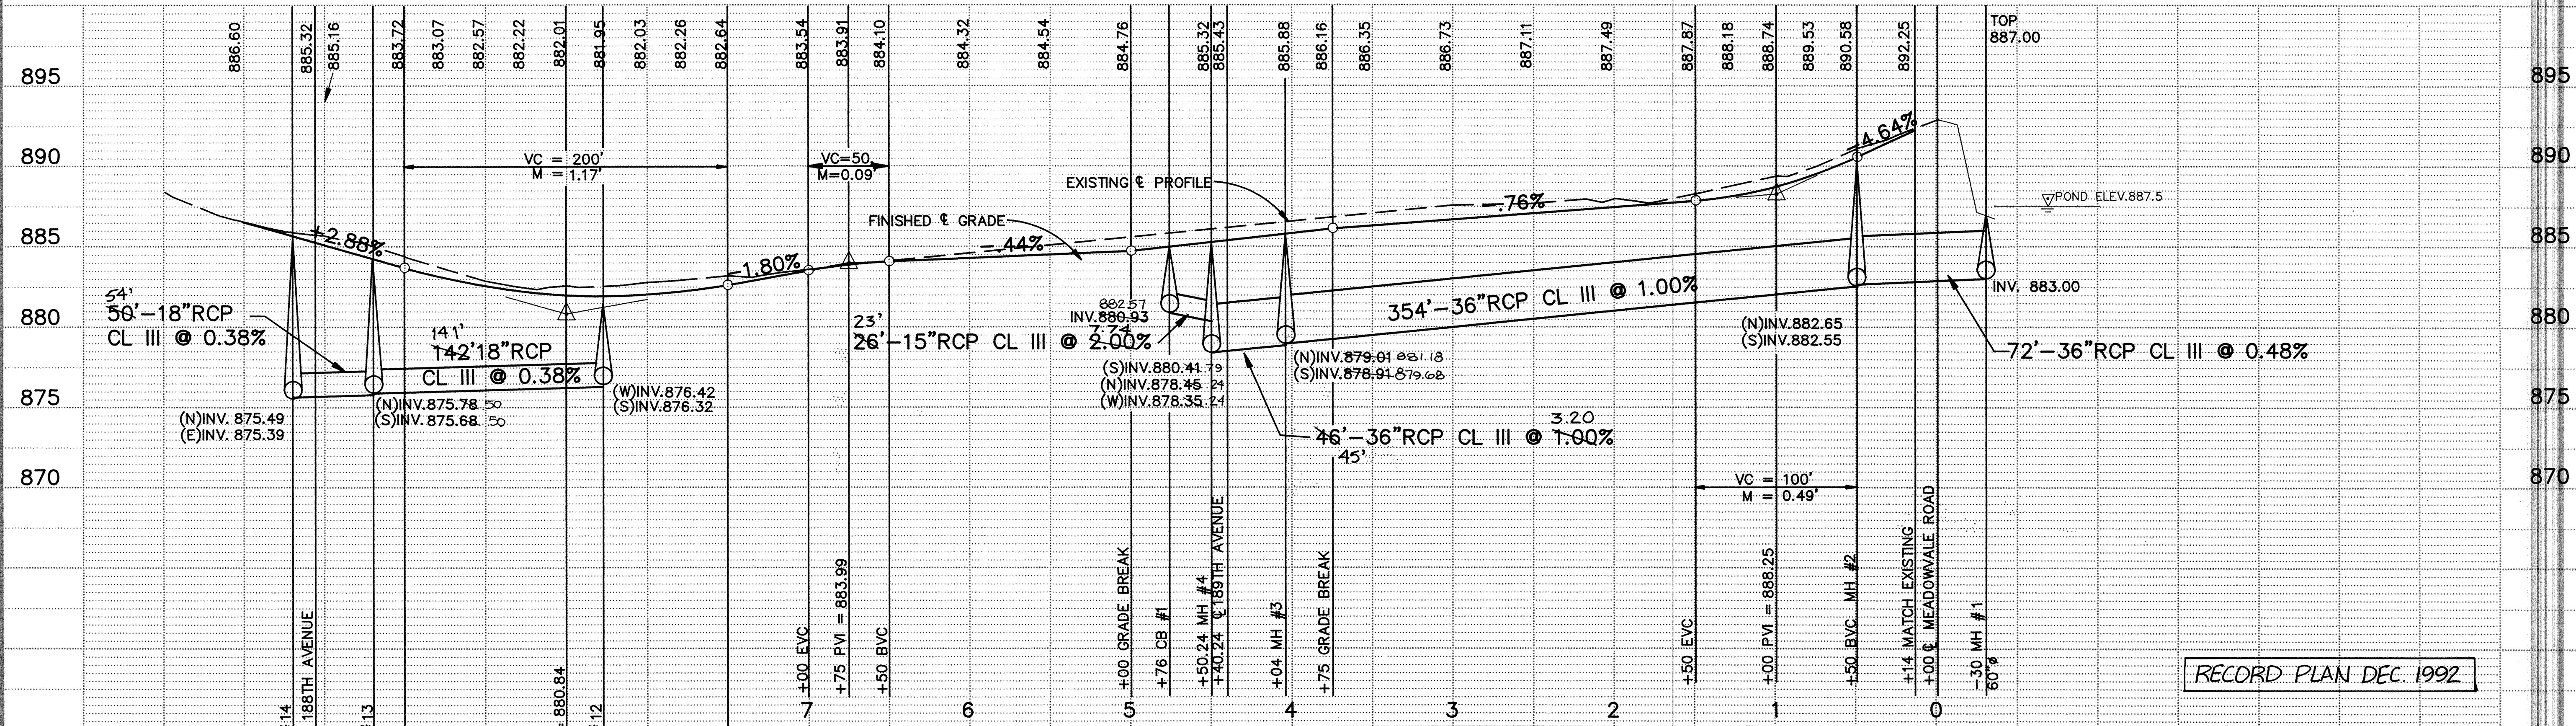

RECORD PLAN DEC. 1992

I HEREBY CERTIFY THAT THIS PLAN, SPECIFICATION, OR REPORT WAS PREPARED BY ME OR UNDER MY DIRECT SUPERVISION AND THAT I AM A DULY REGISTERED PROFESSIONAL ENGINEER UNDER THE LAWS OF THE STATE OF MINNESOTA.  
*Larry J. Maier*  
DATE 2/6/92 REG. NO. 15314

**Maier Stewart & Associates Inc.**  
CONSULTING ENGINEERS  
9800 SHELARD PARKWAY (612) 546-0432 MINNEAPOLIS, MINNESOTA 55441  
1959 SLOAN PLACE (612) 774-6021 ST. PAUL, MINNESOTA 55117

| DATE | DESCRIPTION | DESIGNED      |
|------|-------------|---------------|
|      |             | CHECKED       |
|      |             | DRAWN         |
|      |             | GRAPHIC SCALE |
|      |             | 0' HORIZ. 50' |
|      |             | 0' VERT. 5'   |

|                        |                       |
|------------------------|-----------------------|
| CITY OF ELK RIVER      |                       |
| STORM SEWER AND STREET |                       |
| ALBANY STREET          |                       |
| DATE JAN, 1992         | SHEET 14 OF 23 SHEETS |
| PROJECT NO. 270-116    |                       |