
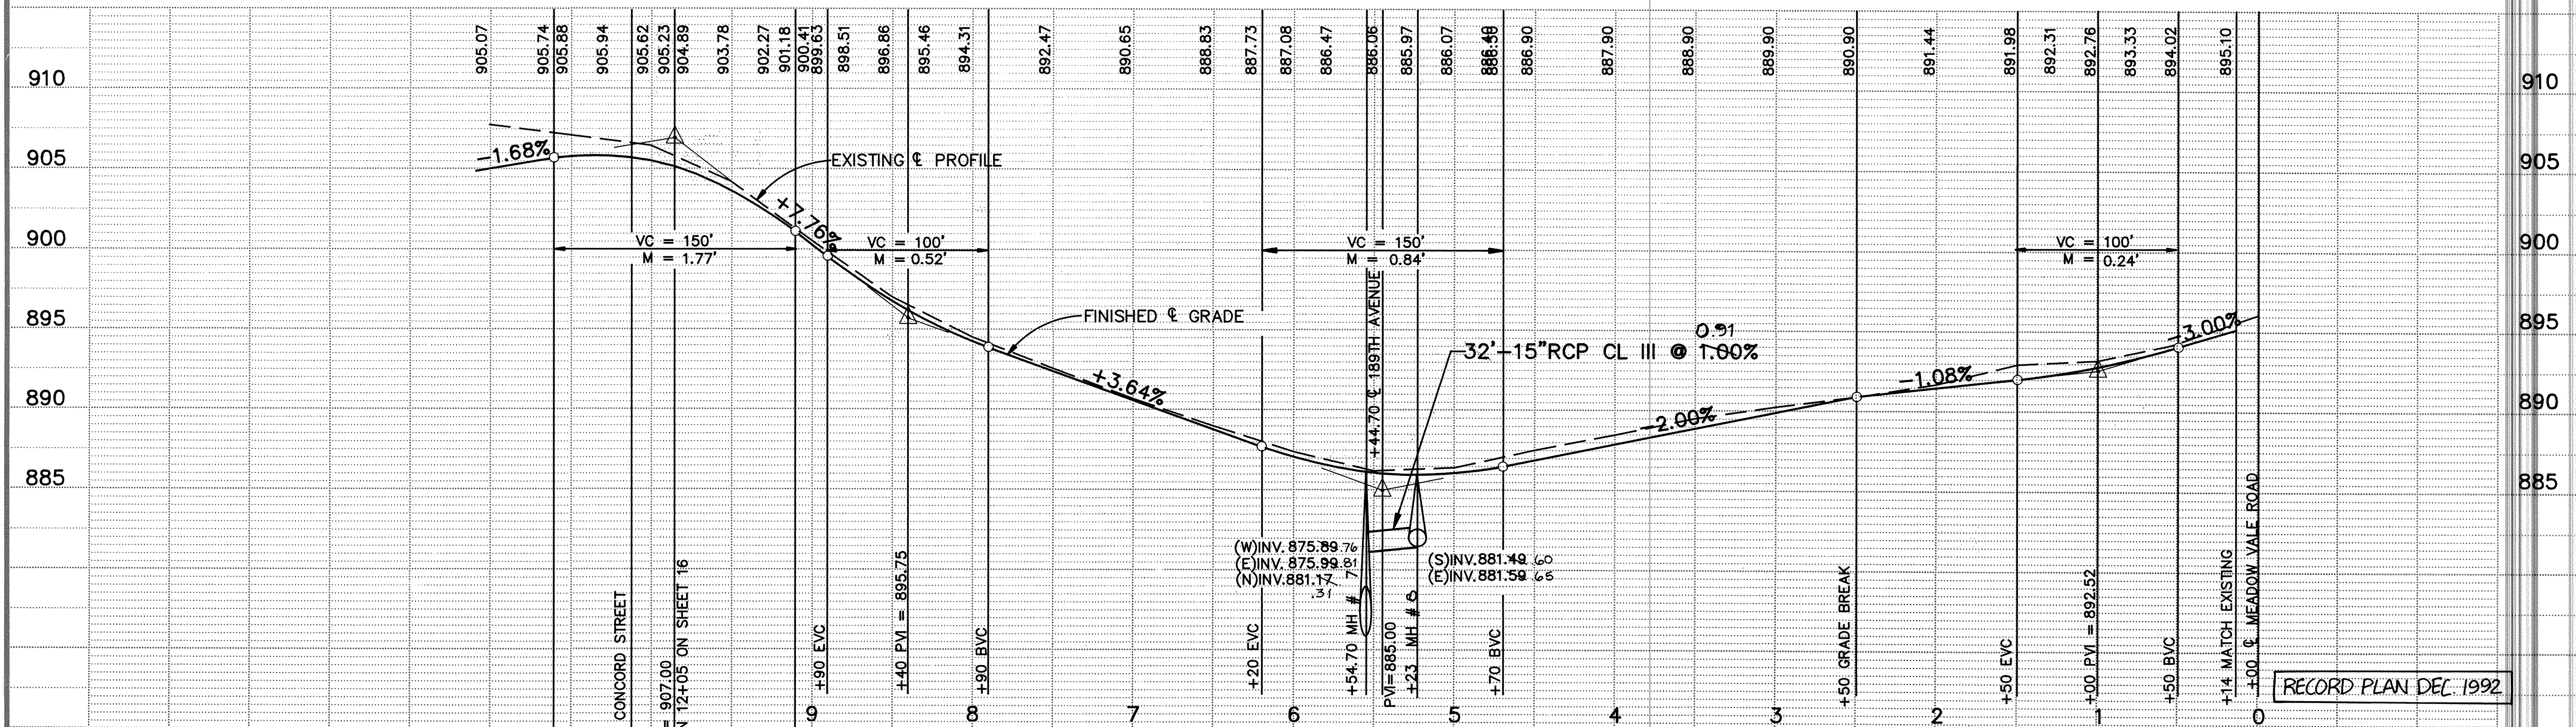
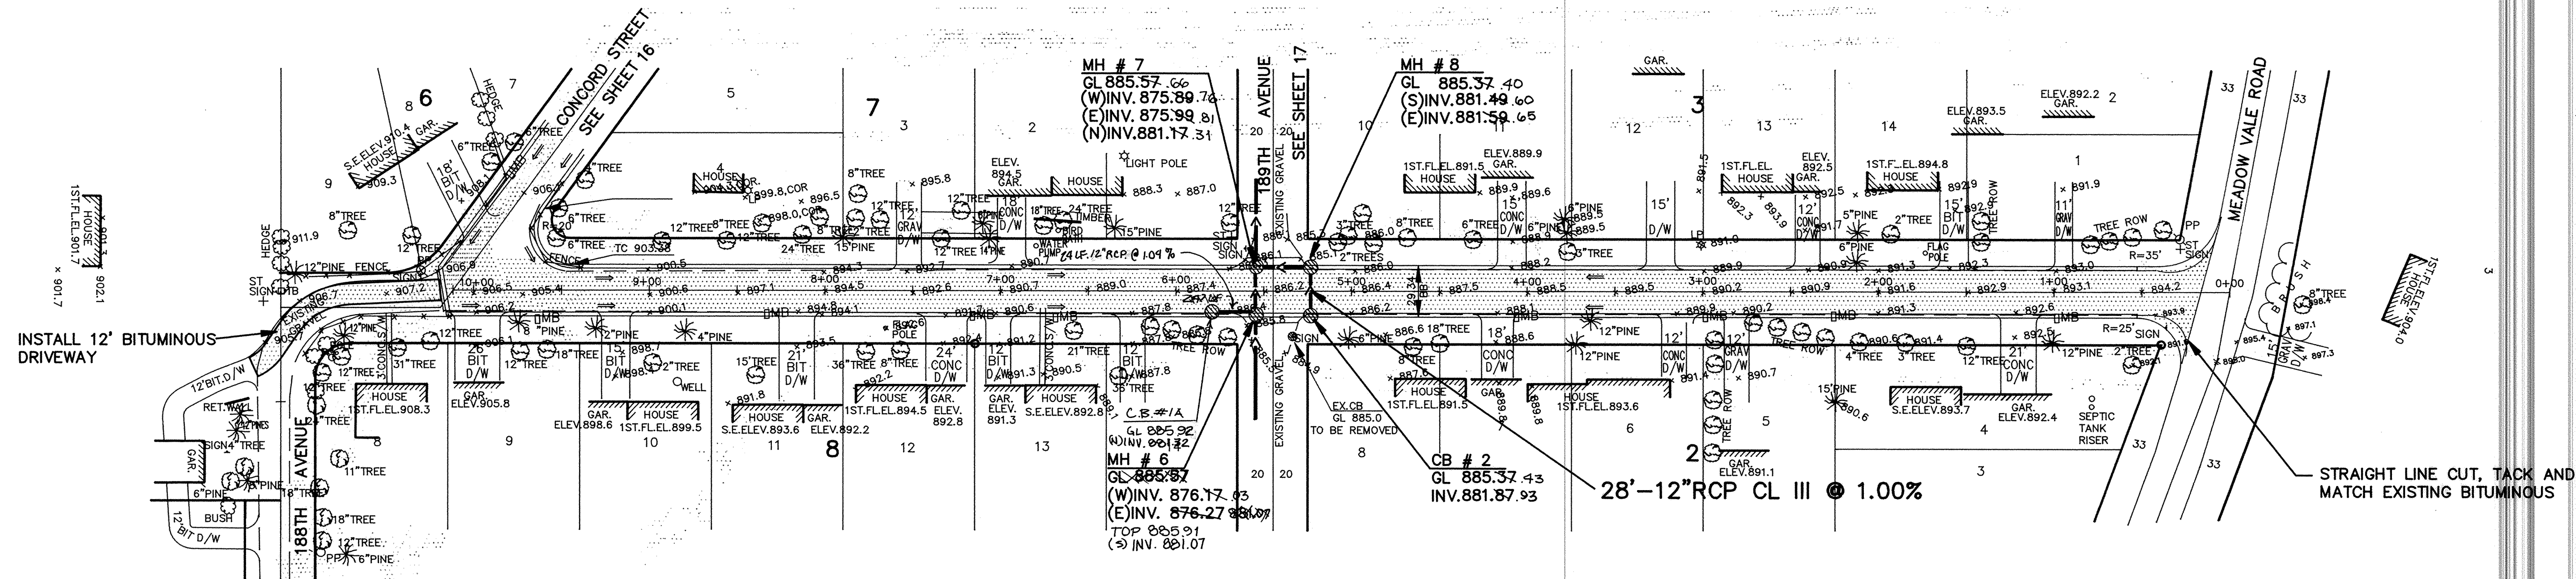


BOSTON STREET

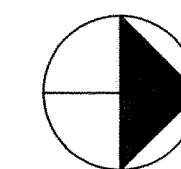

I HEREBY CERTIFY THAT THIS PLAN, SPECIFICATION, OR REPORT WAS PREPARED BY ME OR UNDER MY DIRECT SUPERVISION AND THAT I AM A DULY REGISTERED PROFESSIONAL ENGINEER UNDER THE LAWS OF THE STATE OF MINNESOTA.

Tony J. Maier

DATE 2/6/92 REG. NO. 15314



CONSULTING ENGINEERS
Maier Stewart & Associates Inc.

9800 SHELARD PARKWAY (612) 546-0432 MINNEAPOLIS, MINNESOTA 55441
1959 SLOAN PLACE (612) 774-6021 ST. PAUL, MINNESOTA 55117

DATE	DESCRIPTION	DESIGNED
		CHECKED
		DRAWN
		GRAPHIC SCALE
		0' HORIZ. 50'
		0' VERT. 5'

CITY OF ELK RIVER		
STREET AND STORM SEWER		
BOSTON STREET		
DATE	SHEET	PROJECT NO.
DEC, 1991	15 OF 23 SHEETS	230-116